PLAT OF SURVEY

LOT 5 AS DESIGNATED UPON THE FINAL PLAT OF GLACIAL FOREST RECORDED SUBDIVISION, LOCATED IN THE TOWN OF WHITEWATER, WALWORTH COUNTY, STATE OF WISCONSIN.

NOTE The above description is subject to any and all easements or agreements, recorded or unrecorded.

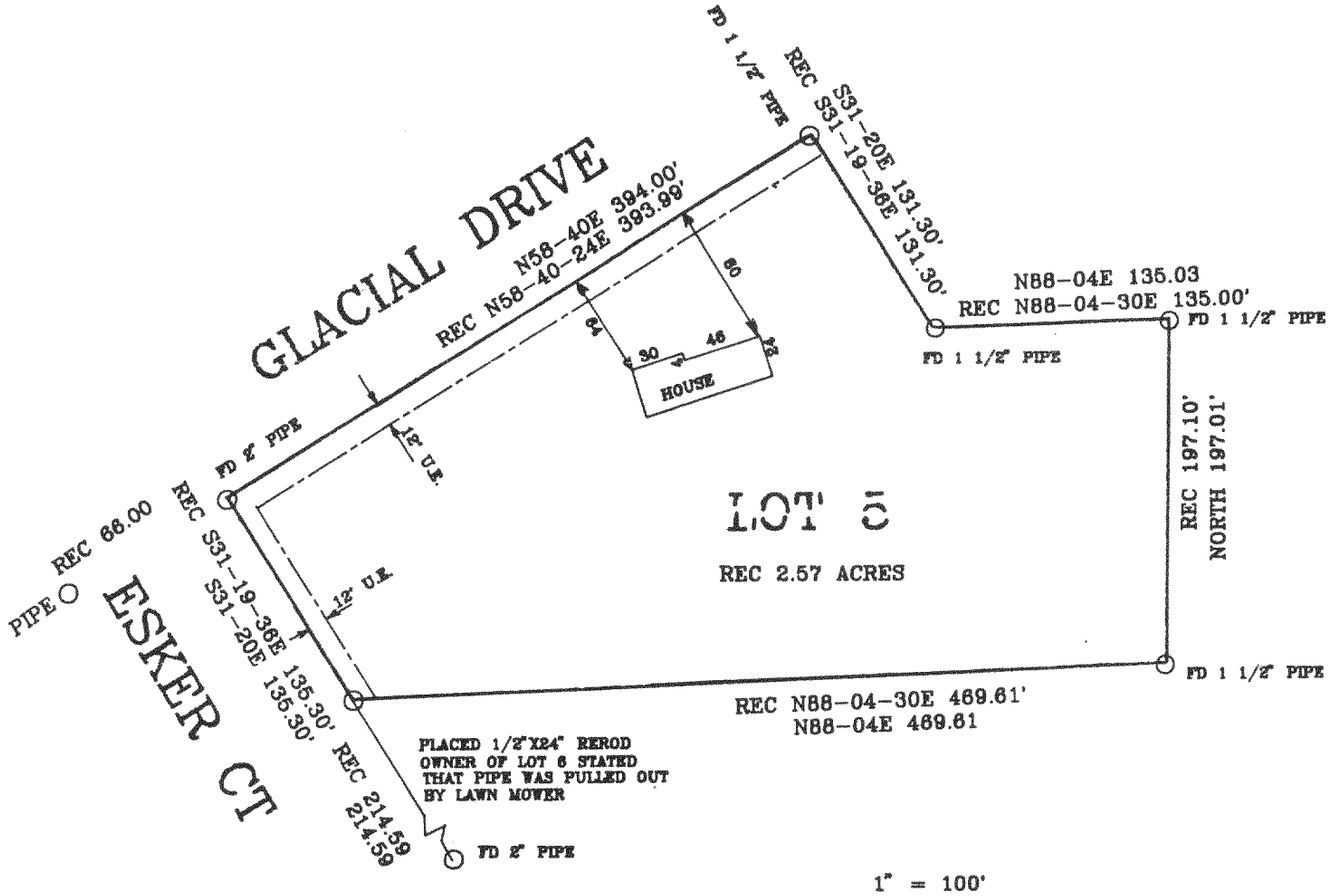

1" = 100'

State of Wisconsin
County of Rock

I have surveyed and mapped the above described property and to the best of my knowledge and belief the map hereon is a true representation thereof and shows the size and location of the property, its boundary fences, apparent easements, roadways and visible encroachments, if any.

This survey is made for the exclusive use of the present owner of of the property. I certify the accuracy of said survey.

Given under my hand seal this 21st day of March, 1994 at Janesville, Wisconsin.

embossed seal

Donald Barnes

RECEIVED
APR 15 1994

D6-5

415-424