
ABELL
SURVEYING & MAPPING
DELAVAN, WISCONSIN 53115
414-728-6737

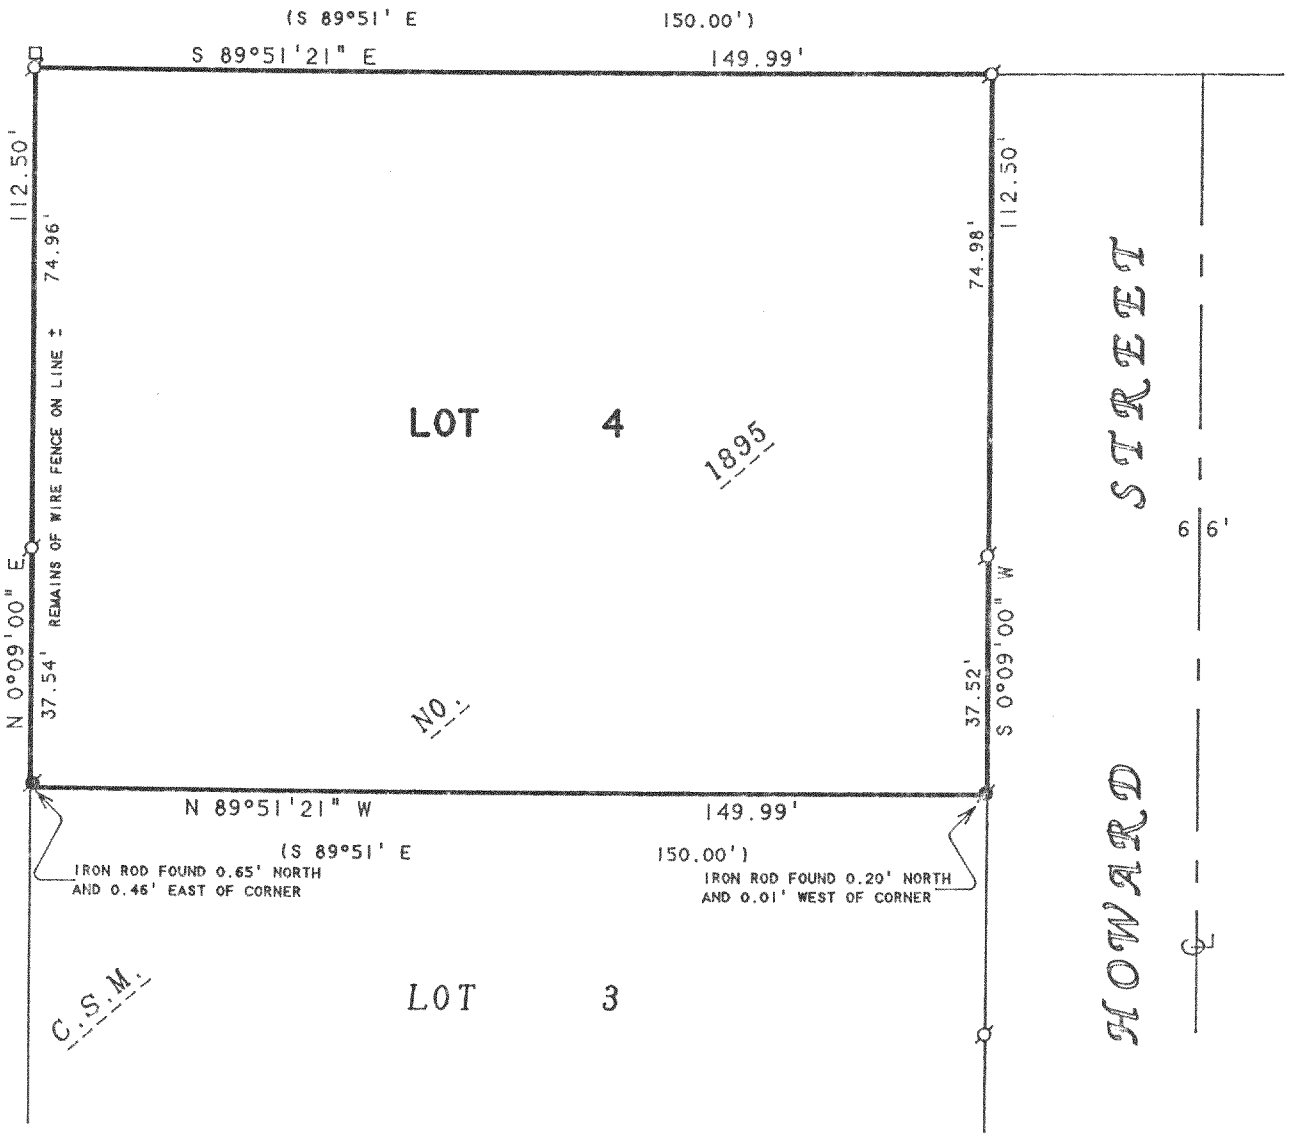

ORDERED BY: VERN LUDTKE
N7480 GRANDVIEW DRIVE
WHITEWATER, WI 53190

NOTE: BEARINGS ARE REFERENCED TO CERTIFIED SURVEY MAP NO. 1895.

PLAT OF SURVEY OF

LOT 4, CERTIFIED SURVEY MAP NO. 1895, LOCATED IN SOUTHEAST 1/4 OF SECTION 34, T4N, R15E, WALWORTH COUNTY, WISCONSIN.

RECEIVED
OCT 9 1995

N

SCALE 1"=30'

LEGEND

- ⌀ -IRON PIPE FOUND
- ● -IRON ROD FOUND
- □ -UTILITY PED.
- ( )-RECORDED AS

I HEREBY CERTIFY THAT I HAVE SURVEYED THE ABOVE DESCRIBED PROPERTY AND THAT THE ABOVE MAP IS A TRUE REPRESENTATION THEREOF AND SHOWS THE SIZE AND LOCATION OF THE PROPERTY, ITS EXTERIOR BOUNDARIES, THE LOCATION OF ALL VISIBLE STRUCTURES AND DIMENSIONS OF ALL PRINCIPAL BUILDINGS THEREON, BOUNDARY FENCES, APPARENT EASEMENTS, ROADWAYS AND VISIBLE ENCROACHMENTS, IF ANY, TO THE BEST OF MY KNOWLEDGE AND BELIEF.

THIS SURVEY IS MADE FOR THE USE OF THE PRESENT OWNERS OF THE PROPERTY, AND ALSO THOSE WHO PURCHASE, MORTGAGE, OR GUARANTEE THE TITLE THERETO WITHIN ONE (1) YEAR FROM DATE HEREON.

David F. Abell

DAVID F. ABELL
WISCONSIN REGISTERED LAND SURVEYOR, S-1596

July 12, 1995
DATE

JOB NUMBER - 95110

NOTE: THIS IS NOT A CERTIFIED COPY UNLESS SEALED.

DA-1895-4

415-498