
ABELL
SURVEYING & MAPPING
DELAVAN, WISCONSIN 53115
414-728-6737

NOTE: BEARINGS ARE REFERENCED TO THE RECORDED PLAT OF MORAINE PARK SUBDIVISION.

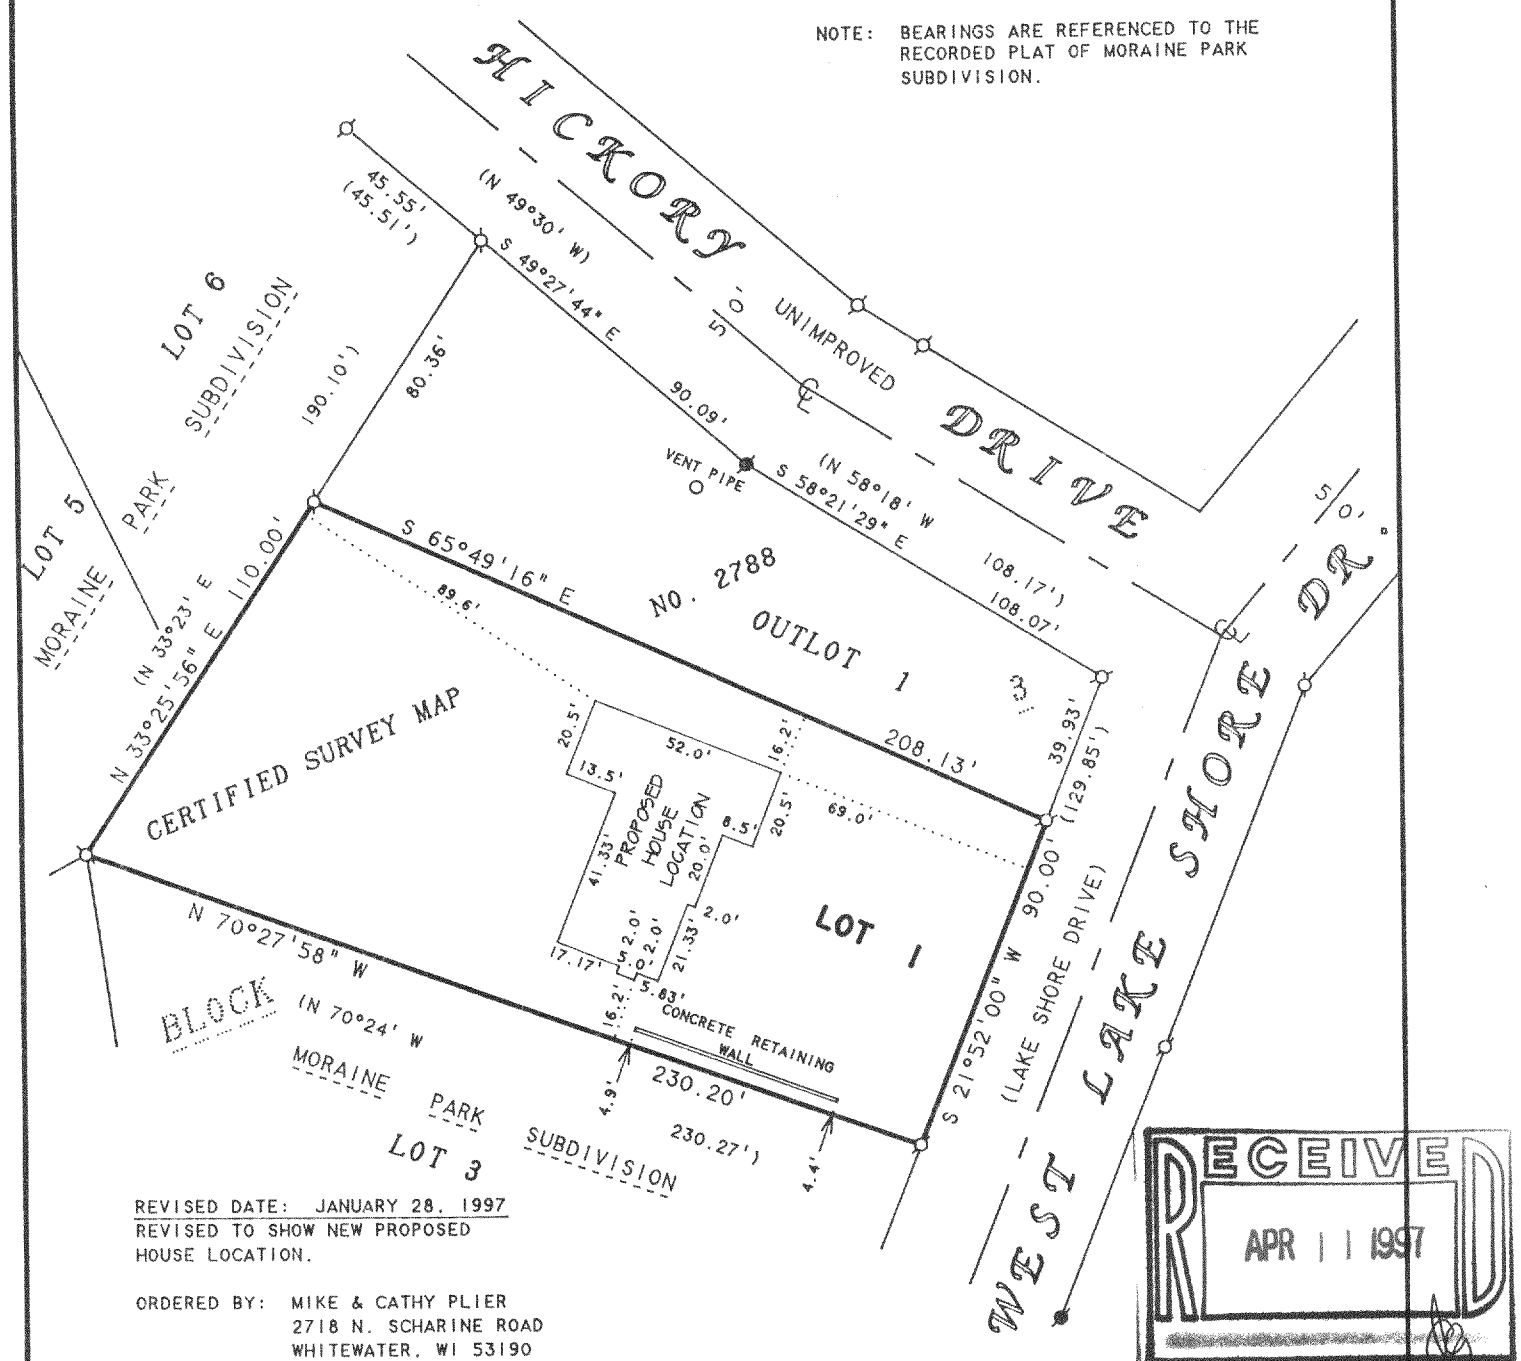

REVISED DATE: JANUARY 28, 1997
REVISED TO SHOW NEW PROPOSED HOUSE LOCATION.

ORDERED BY: MIKE & CATHY PLIER
2718 N. SCHARINE ROAD
WHITEWATER, WI 53190

RECEIVED
APR 11 1997

PLAT OF SURVEY OF

LOT 1, CERTIFIED SURVEY MAP NO. 2788, LOCATED IN THE NORTHEAST 1/4 OF SECTION 34, T4N, R15E, WALWORTH COUNTY, WISCONSIN.

N

SCALE 1"=50'

LEGEND

- ⌀ - IRON PIPE FOUND
- ● - IRON ROD FOUND
- ( ) - RECORDED AS

I HEREBY CERTIFY THAT I HAVE SURVEYED THE ABOVE DESCRIBED PROPERTY AND THAT THE ABOVE MAP IS A TRUE REPRESENTATION THEREOF AND SHOWS THE SIZE AND LOCATION OF THE PROPERTY, ITS EXTERIOR BOUNDARIES, THE LOCATION OF ALL VISIBLE STRUCTURES AND DIMENSIONS OF ALL PRINCIPAL BUILDINGS THEREON, BOUNDARY FENCES, APPARENT EASEMENTS, ROADWAYS AND VISIBLE ENCROACHMENTS, IF ANY, TO THE BEST OF MY KNOWLEDGE AND BELIEF.

THIS SURVEY IS MADE FOR THE USE OF THE PRESENT OWNERS OF THE PROPERTY, AND ALSO THOSE WHO PURCHASE, MORTGAGE, OR GUARANTEE THE TITLE THERETO WITHIN ONE (1) YEAR FROM DATE HEREON.

David F. Abell

DAVID F. ABELL
WISCONSIN REGISTERED LAND SURVEYOR, S-1596


January 6, 1997

DATE JOB NUMBER - 93168

NOTE: THIS IS NOT A CERTIFIED COPY UNLESS SEALED.

ABELL
SURVEYING & MAPPING
DELAVAN, WISCONSIN 53115
414-728-6737

NOTE: BEARINGS ARE REFERENCED TO THE RECORDED PLAT OF MORAINE PARK SUBDIVISION.

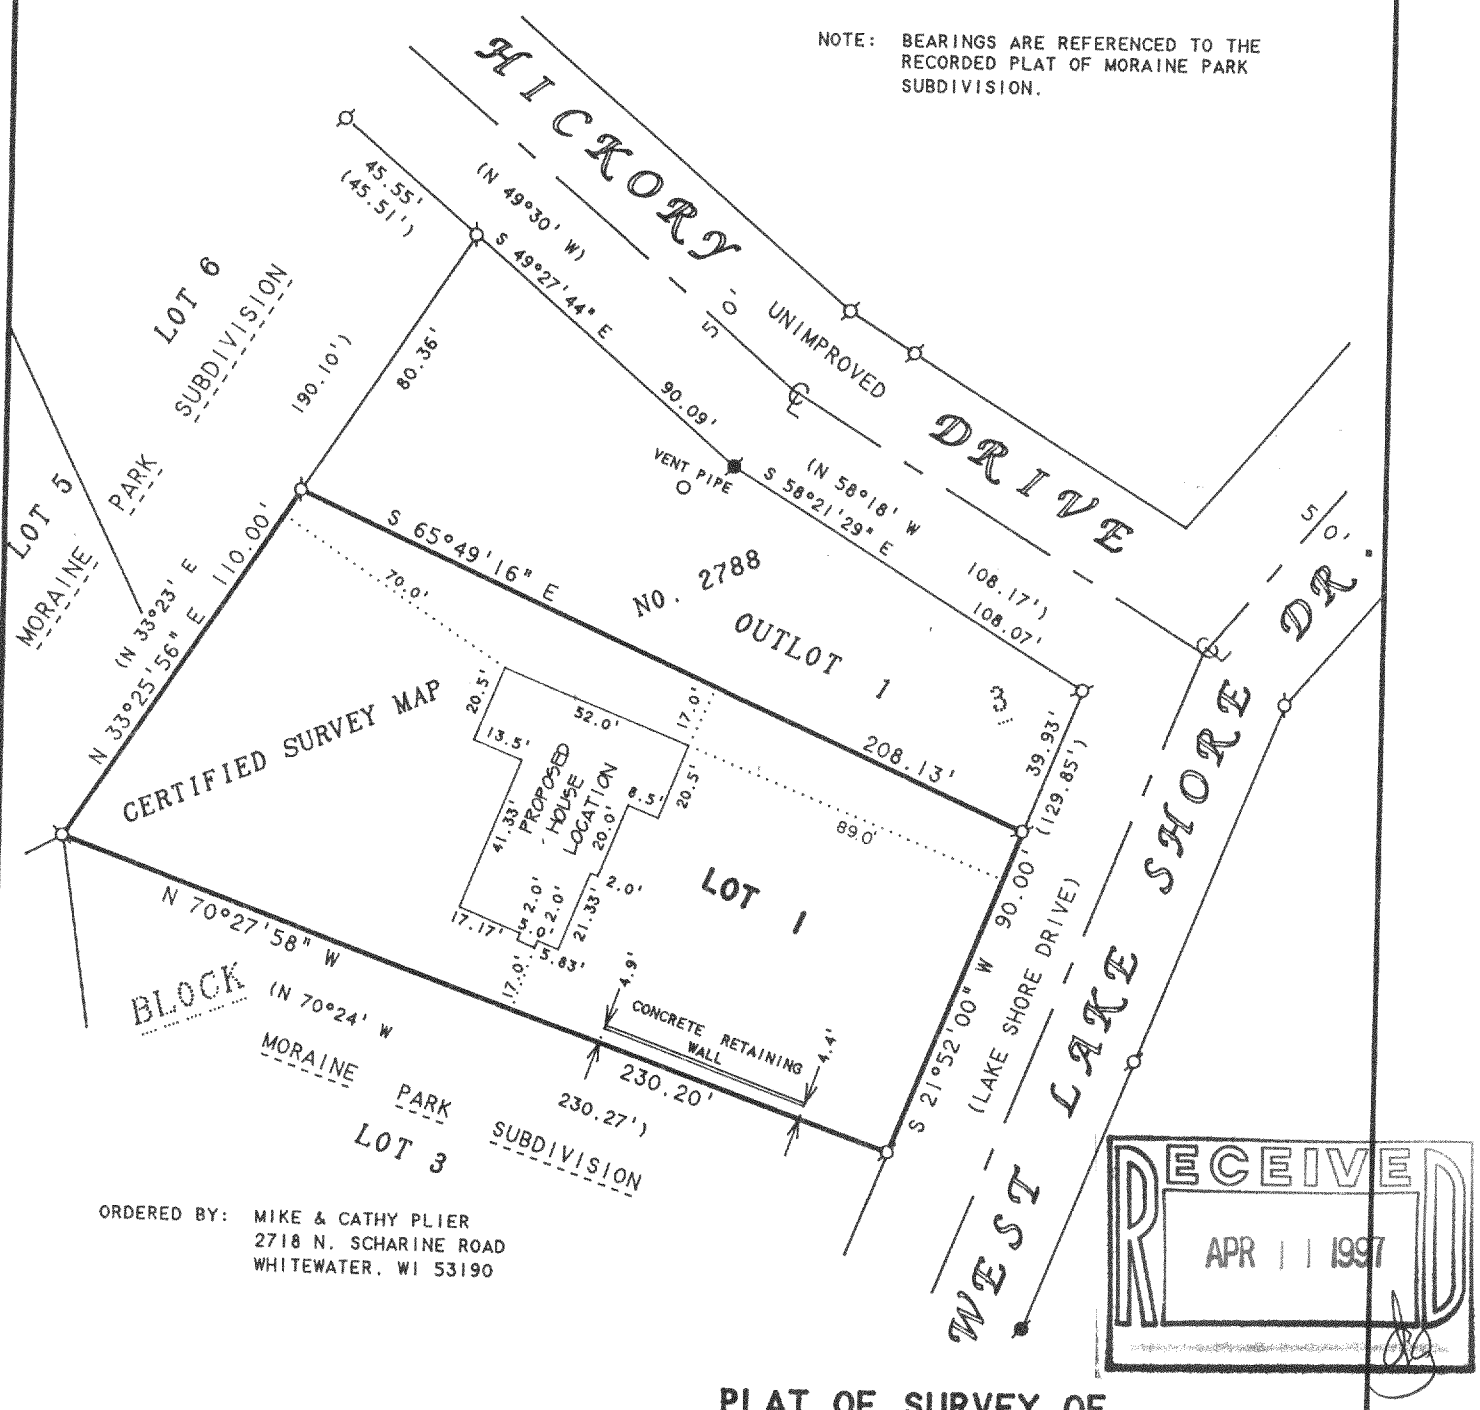

ORDERED BY: MIKE & CATHY PLIER
2718 N. SCHARINE ROAD
WHITEWATER, WI 53190

RECEIVED
APR 11 1997

PLAT OF SURVEY OF

LOT 1, CERTIFIED SURVEY MAP NO. 2788, LOCATED IN THE NORTHEAST 1/4 OF SECTION 34, T4N, R15E, WALWORTH COUNTY, WISCONSIN.

N

SCALE 1"=50'

LEGEND

- ∅ -IRON PIPE FOUND
- ● -IRON ROD FOUND
- ( )-RECORDED AS

I HEREBY CERTIFY THAT I HAVE SURVEYED THE ABOVE DESCRIBED PROPERTY AND THAT THE ABOVE MAP IS A TRUE REPRESENTATION THEREOF AND SHOWS THE SIZE AND LOCATION OF THE PROPERTY, ITS EXTERIOR BOUNDARIES, THE LOCATION OF ALL VISIBLE STRUCTURES AND DIMENSIONS OF ALL PRINCIPAL BUILDINGS THEREON, BOUNDARY FENCES, APPARENT EASEMENTS, ROADWAYS AND VISIBLE ENCROACHMENTS, IF ANY, TO THE BEST OF MY KNOWLEDGE AND BELIEF.

THIS SURVEY IS MADE FOR THE USE OF THE PRESENT OWNERS OF THE PROPERTY, AND ALSO THOSE WHO PURCHASE, MORTGAGE, OR GUARANTEE THE TITLE THERETO WITHIN ONE (1) YEAR FROM DATE HEREON.

David F. Abell

DAVID F. ABELL
WISCONSIN REGISTERED LAND SURVEYOR, S-1596

January 6, 1997

DATE JOB NUMBER - 93168

NOTE: THIS IS NOT A CERTIFIED COPY UNLESS SEALED.

DA-2788-1
415-580