
PLAT OF SURVEY

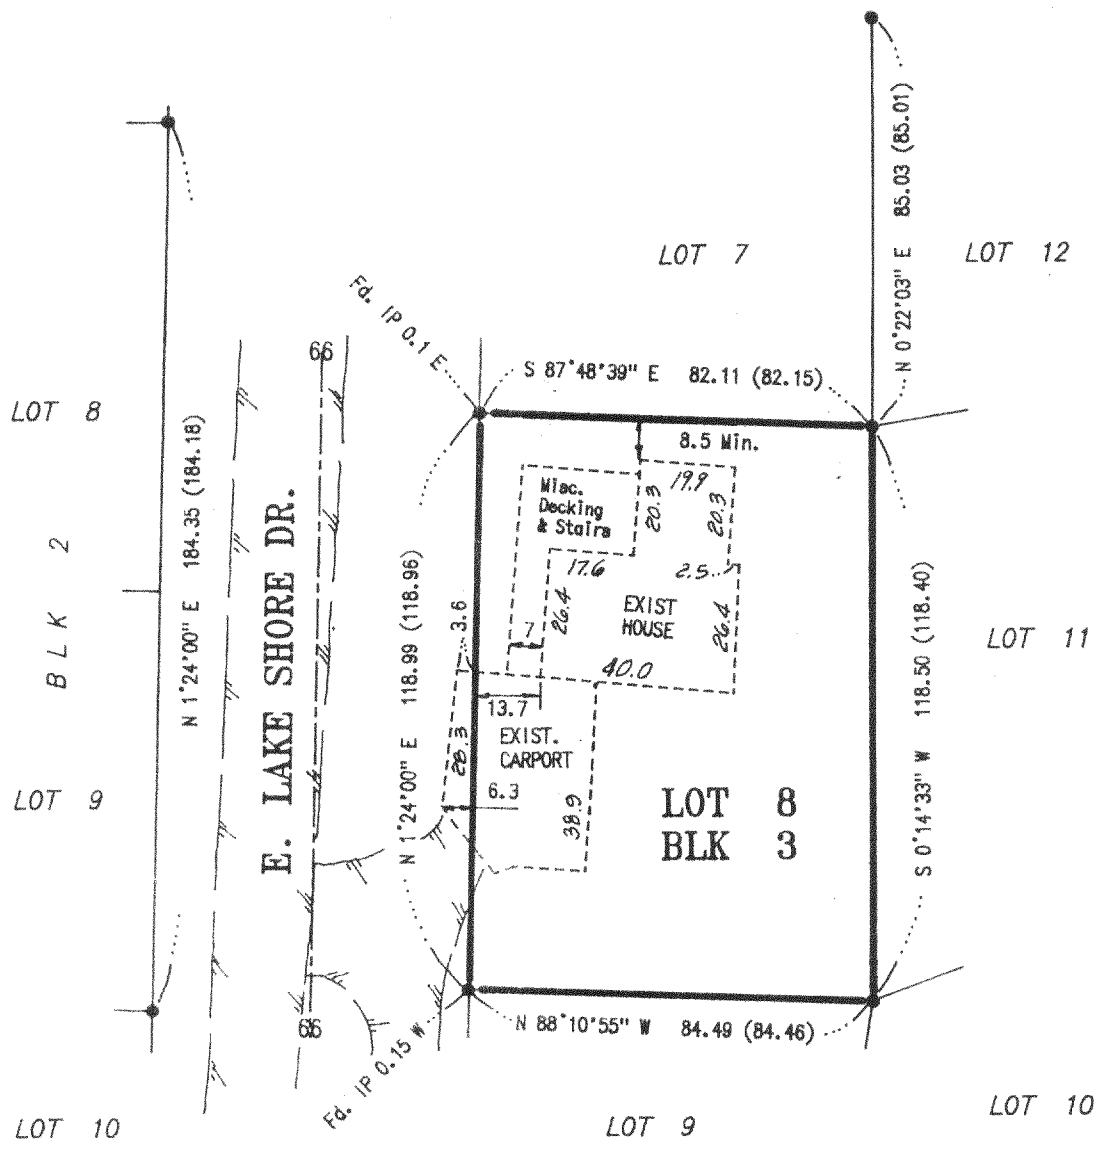



BASIS OF BEARINGS:
THE W. LINE OF E. LAKE SHORE DR.
BEING N 1°24'00" E

NOTES:

( ) -- Indicates Record Distance
● -- Indicates Fd. 1" Iron Pipe

SURVEYOR'S CERTIFICATE
I, JAMES K. LANGONE, REGISTERED LAND SURVEYOR, CERTIFY THAT I HAVE SURVEYED THE PROPERTY DESCRIBED BELOW AND THAT THE PLAT SHOWN HEREON IS A CORRECT REPRESENTATION OF THE BOUNDARIES THEREOF.

DATE: 10/29/97

JAMES K. LANGONE
REGISTERED LAND SURVEYOR, S-1347

WISCONSIN JAMES K. LANGONE S-1347 WHITEWATER LAND SURVEYOR

RECEIVED
NOV 3 1997

LEGAL DESCRIPTION:

IN THE SW 1/4, SEC. 25, T4N, R15E, IN THE TOWN OF WHITEWATER, WALWORTH COUNTY, WISCONSIN.

LOT 8, BLOCK 3, GUTZMER'S SUBDIVISION

0 20 40 80 120

SCALE: 1"=40'

10/20/97
JN: 97-146

JAMES K. LANGONE
LAND SURVEYS & CIVIL ENGINEERING
N339 Co. Rd. "N" (Upper) Whitewater, WI. 53190-2842 (414) 473-4119

DGD-26
415-610