ABERNATHY and ASSOCIATES
Kenneth B. Abernathy Jr.
Wisconsin Registered Land Surveyor S-1594


W4056 Bray Road
Elkhorn, Wisconsin 53121
Phone: (414) 723-4260 (office)
(414) 723-7209 (fax)

PLAT OF SURVEY

LEGAL DESCRIPTION

Lot 10 of Block 2 of Minnieska Subdivision, Located in the Northeast 1/4 of Section 35, Town 4 North, Range 15 East, Town of Whitewater, County of Walworth, State of Wisconsin.

Owner: Micheal Chance
578 Woodland Ave.
Northfield, Illinois 60093

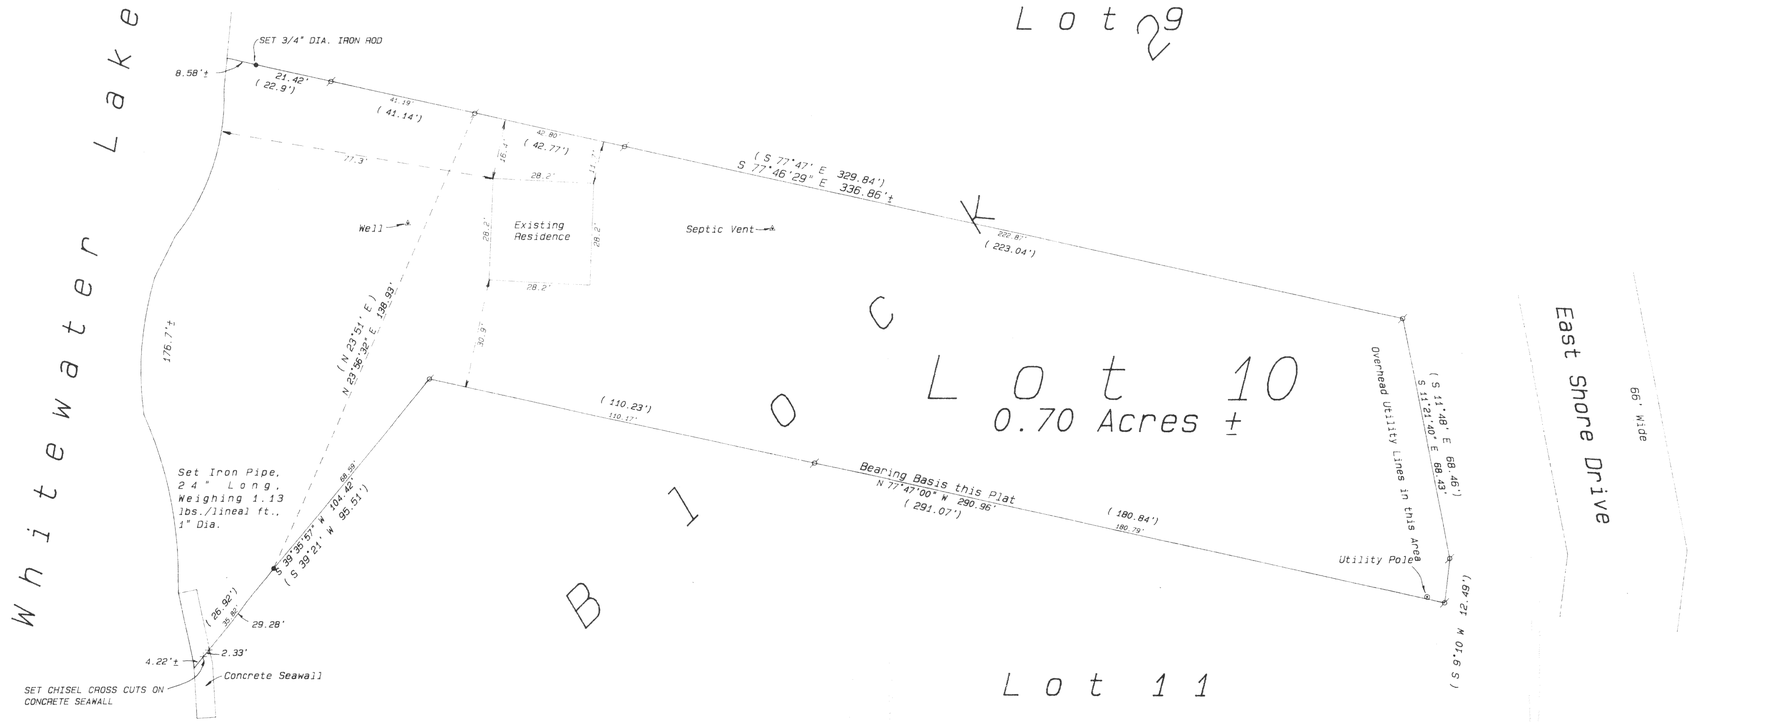

PLAT WAS REVISED ON SEPTEMBER 30, 1997 TO SHOW ADDITIONAL MONUMENTATION NEAR THE SHORELINE AND TO RELOCATE AND MARK EXTERIOR CORNERS.

Legend

- FOUND IRON PIPE
- FOUND IRON ROD
- FOUND BRASS CAPPED MONUMENT
- FOUND CONCRETE MONUMENT
- CHISEL CUT IN CONCRETE
- SET IRON ROD, 24" LONG, WEIGHING 1.5 LBS./LINEAL FT., 1" DIA.
- SET IRON ROD, 18" LONG, WEIGHING 4.5 LBS./LINEAL FT., 1-11/16" DIA.
- [xx] RECORDED AS DIMENSION
- EXISTING FENCE

RECEIVED
OCT 22 1997

N

SCALE: 1" = 30 FEET

I hereby certify that the above described property has been surveyed by me or under my direction and that the above map is a true representation thereof and shows the size and location of the property, its exterior boundaries, the location of all visible structures and dimensions of all principal buildings thereon, boundary fences, apparent easements, roadways and visible encroachments, if any.
This survey is made for the use of the present owners of the property and also those who purchase, mortgage, or guarantee the title thereto within one year from date hereof.

WISCONSIN
KENNETH B. ABERNATHY, JR.
S-1594
ELKHORN, WI
LAND SURVEYOR

KENNETH B. ABERNATHY, JR.
WISCONSIN REGISTERED LAND SURVEYOR,
S-1594

Date: April 21, 1992 Job No. 1992.401

415-622 DM-33

DESIGN PRODUCTS (414)