
ABELL
SURVEYING & MAPPING

1140 SEQUOIA STREET · DELAVAN, WISCONSIN 53115
262-728-6737

PLAT OF SURVEY OF

LOT 11, BLOCK 2, LUDTKE SUBDIVISION, LOCATED IN T4N, R15E, WALWORTH COUNTY, WISCONSIN.

ORDERED BY: MIKE HAJEK
5808 AMHURST COURT
McHENRY, IL 60050

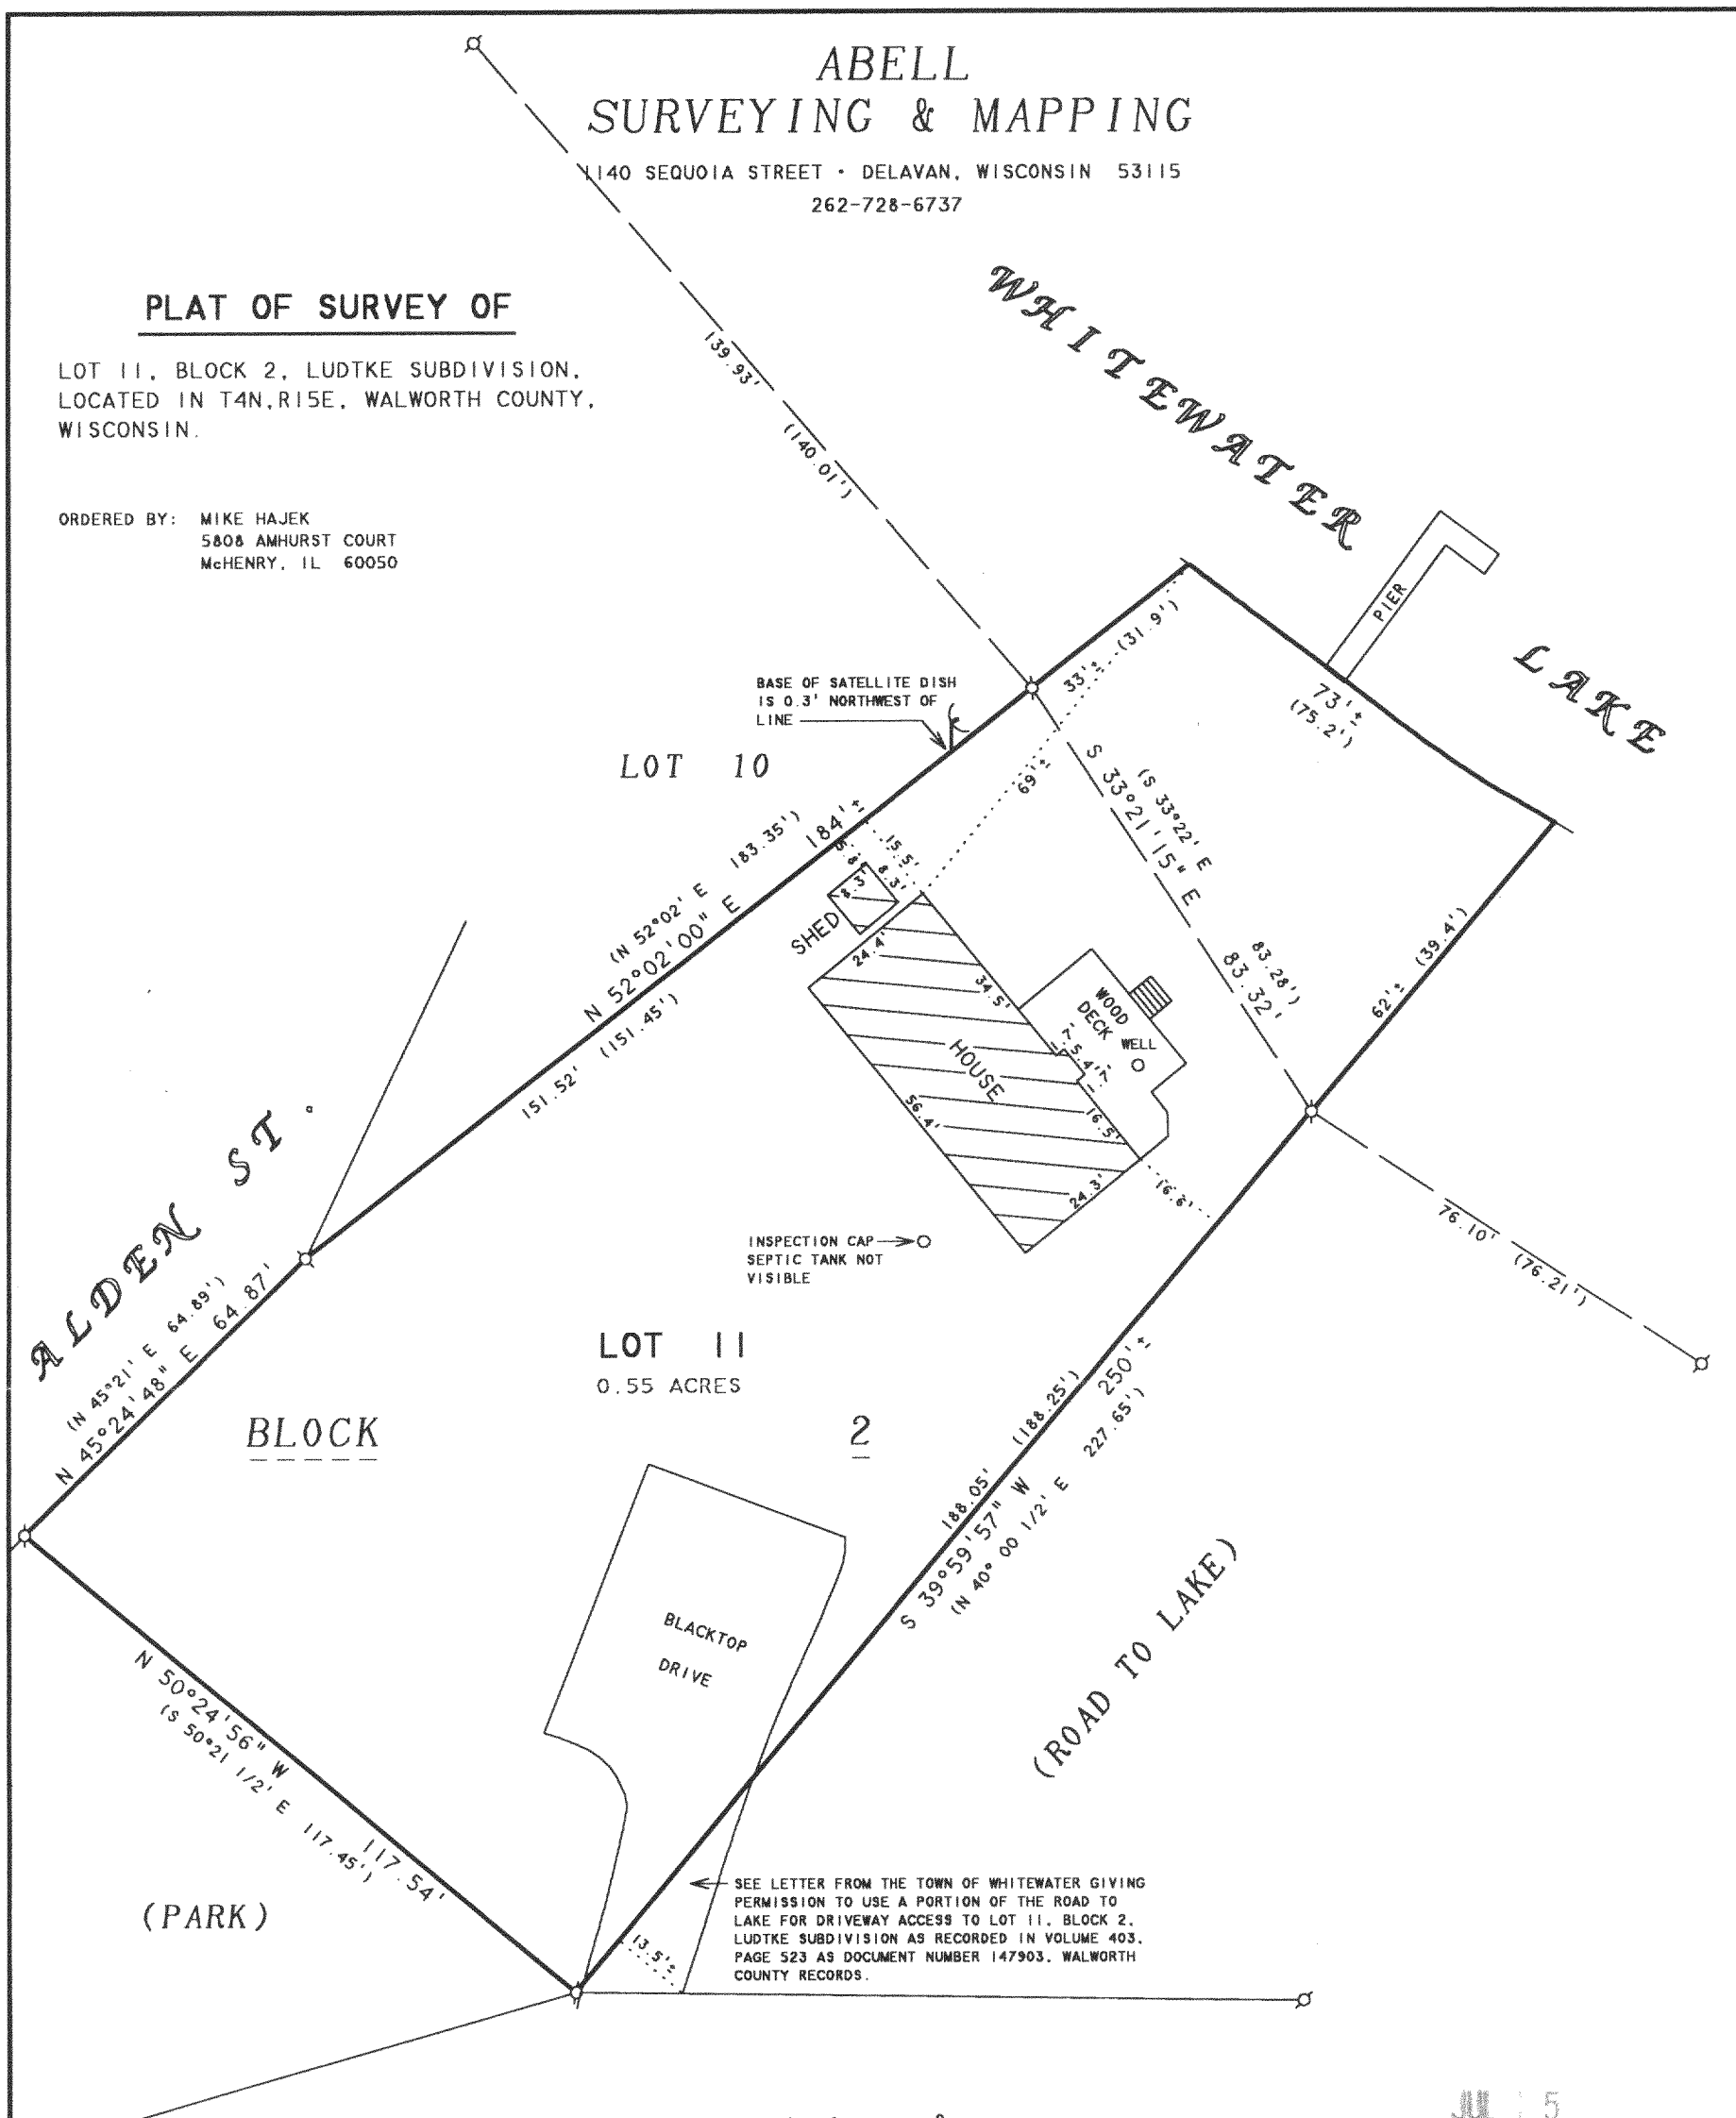

JUL 15

KW

NOTE: BEARINGS ARE REFERENCED TO EXISTING SURVEY RECORDS.

N

SCALE 1"=30'

LEGEND

Ø - IRON PIPE FOUND
( )- RECORDED AS

I HEREBY CERTIFY THAT I HAVE SURVEYED THE ABOVE DESCRIBED PROPERTY AND THAT THE ABOVE MAP IS A TRUE REPRESENTATION THEREOF AND SHOWS THE SIZE AND LOCATION OF THE PROPERTY, ITS EXTERIOR BOUNDARIES, THE LOCATION OF ALL VISIBLE STRUCTURES AND DIMENSIONS OF ALL PRINCIPAL BUILDINGS THEREON, BOUNDARY FENCES, APPARENT EASEMENTS, ROADWAYS AND VISIBLE ENCROACHMENTS, IF ANY, TO THE BEST OF MY KNOWLEDGE AND BELIEF.

THIS SURVEY IS MADE FOR THE USE OF THE PRESENT OWNERS OF THE PROPERTY, AND ALSO THOSE WHO PURCHASE, MORTGAGE, OR GUARANTEE THE TITLE THERETO WITHIN ONE (1) YEAR FROM DATE HEREON.

David F. Abell

DAVID F. ABELL
WISCONSIN REGISTERED LAND SURVEYOR, S-1596

June 29, 2004

DATE JOB NUMBER - 04078

NOTE: THIS IS NOT A CERTIFIED COPY UNLESS SEALED.

DLS 00014

415-9666