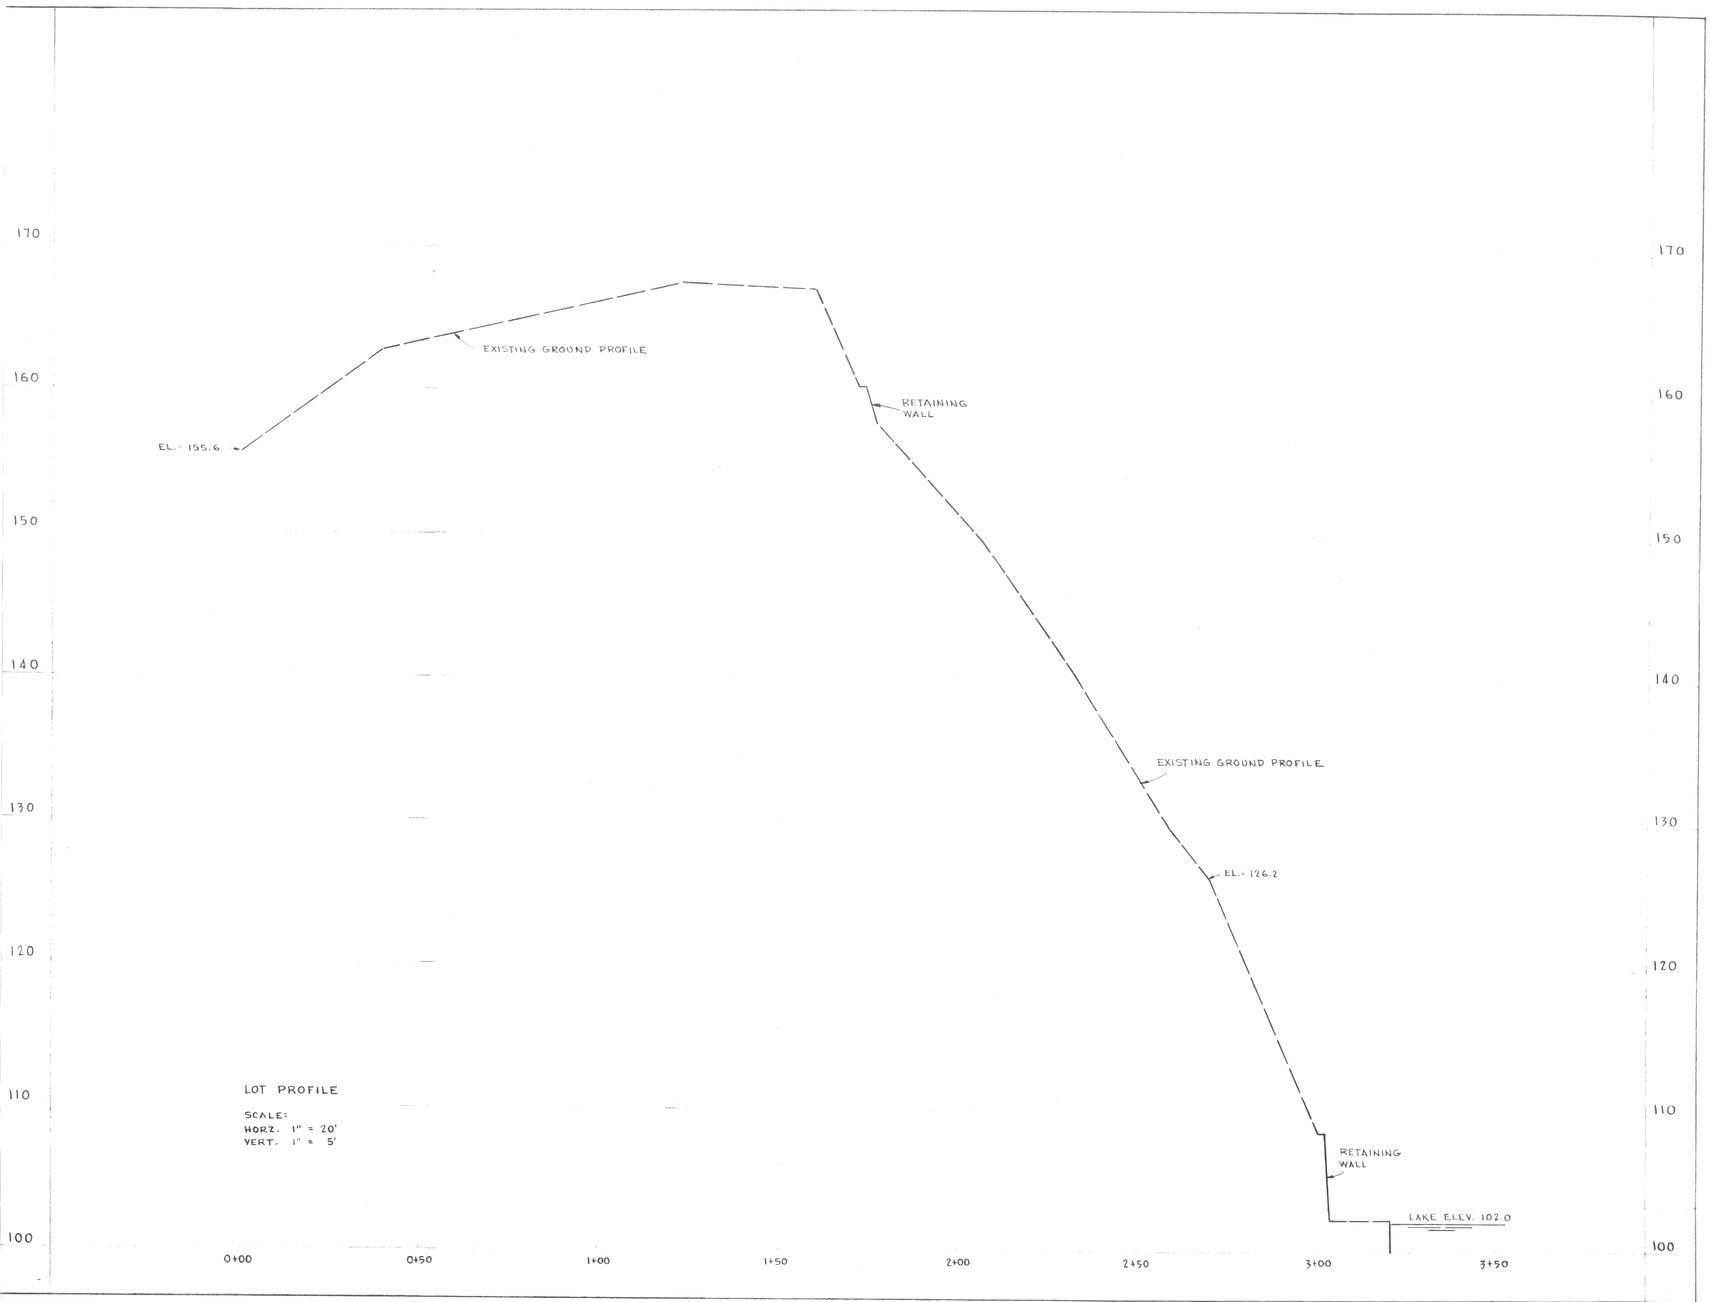

170
160
150
140
130
120
110
100
EXISTING GROUND PROFILE
EL.= 155.6
RETAINING WALL
EXISTING GROUND PROFILE
EL.= 126.2
RETAINING WALL
LAKE ELEV. 102.0
LOT PROFILE
SCALE:
HORZ. 1" = 20'
VERT. 1" = 5'
0+00
0+50
1+00
1+50
2+00
2+50
3+00
3+50

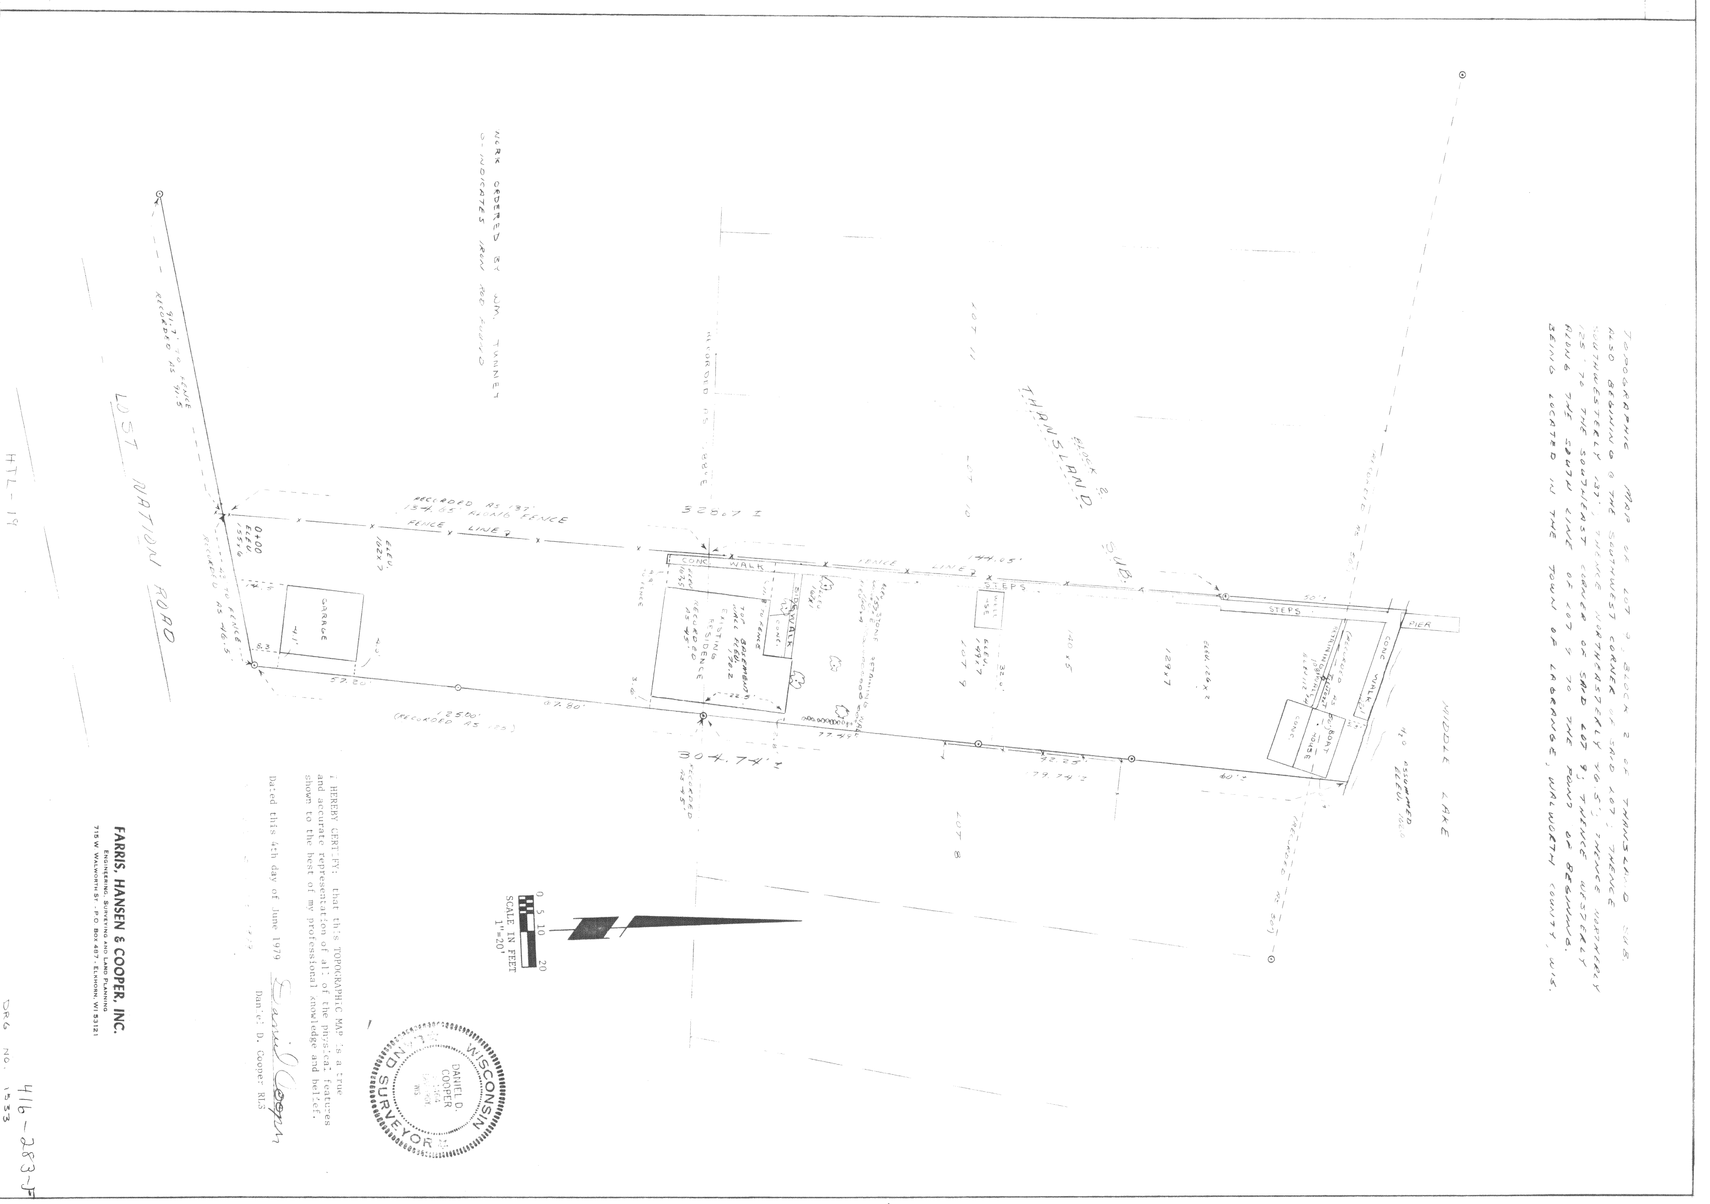

LOST NATION ROAD
MIDDLE LAKE
THANSLAND SUB.
GARAGE
CONC. WALK
STEPS
PIER
SCALE IN FEET
1"=20'
WISCONSIN
DANIEL D. COOPER
LAND SURVEYOR
FARRIS, HANSEN & COOPER, INC.