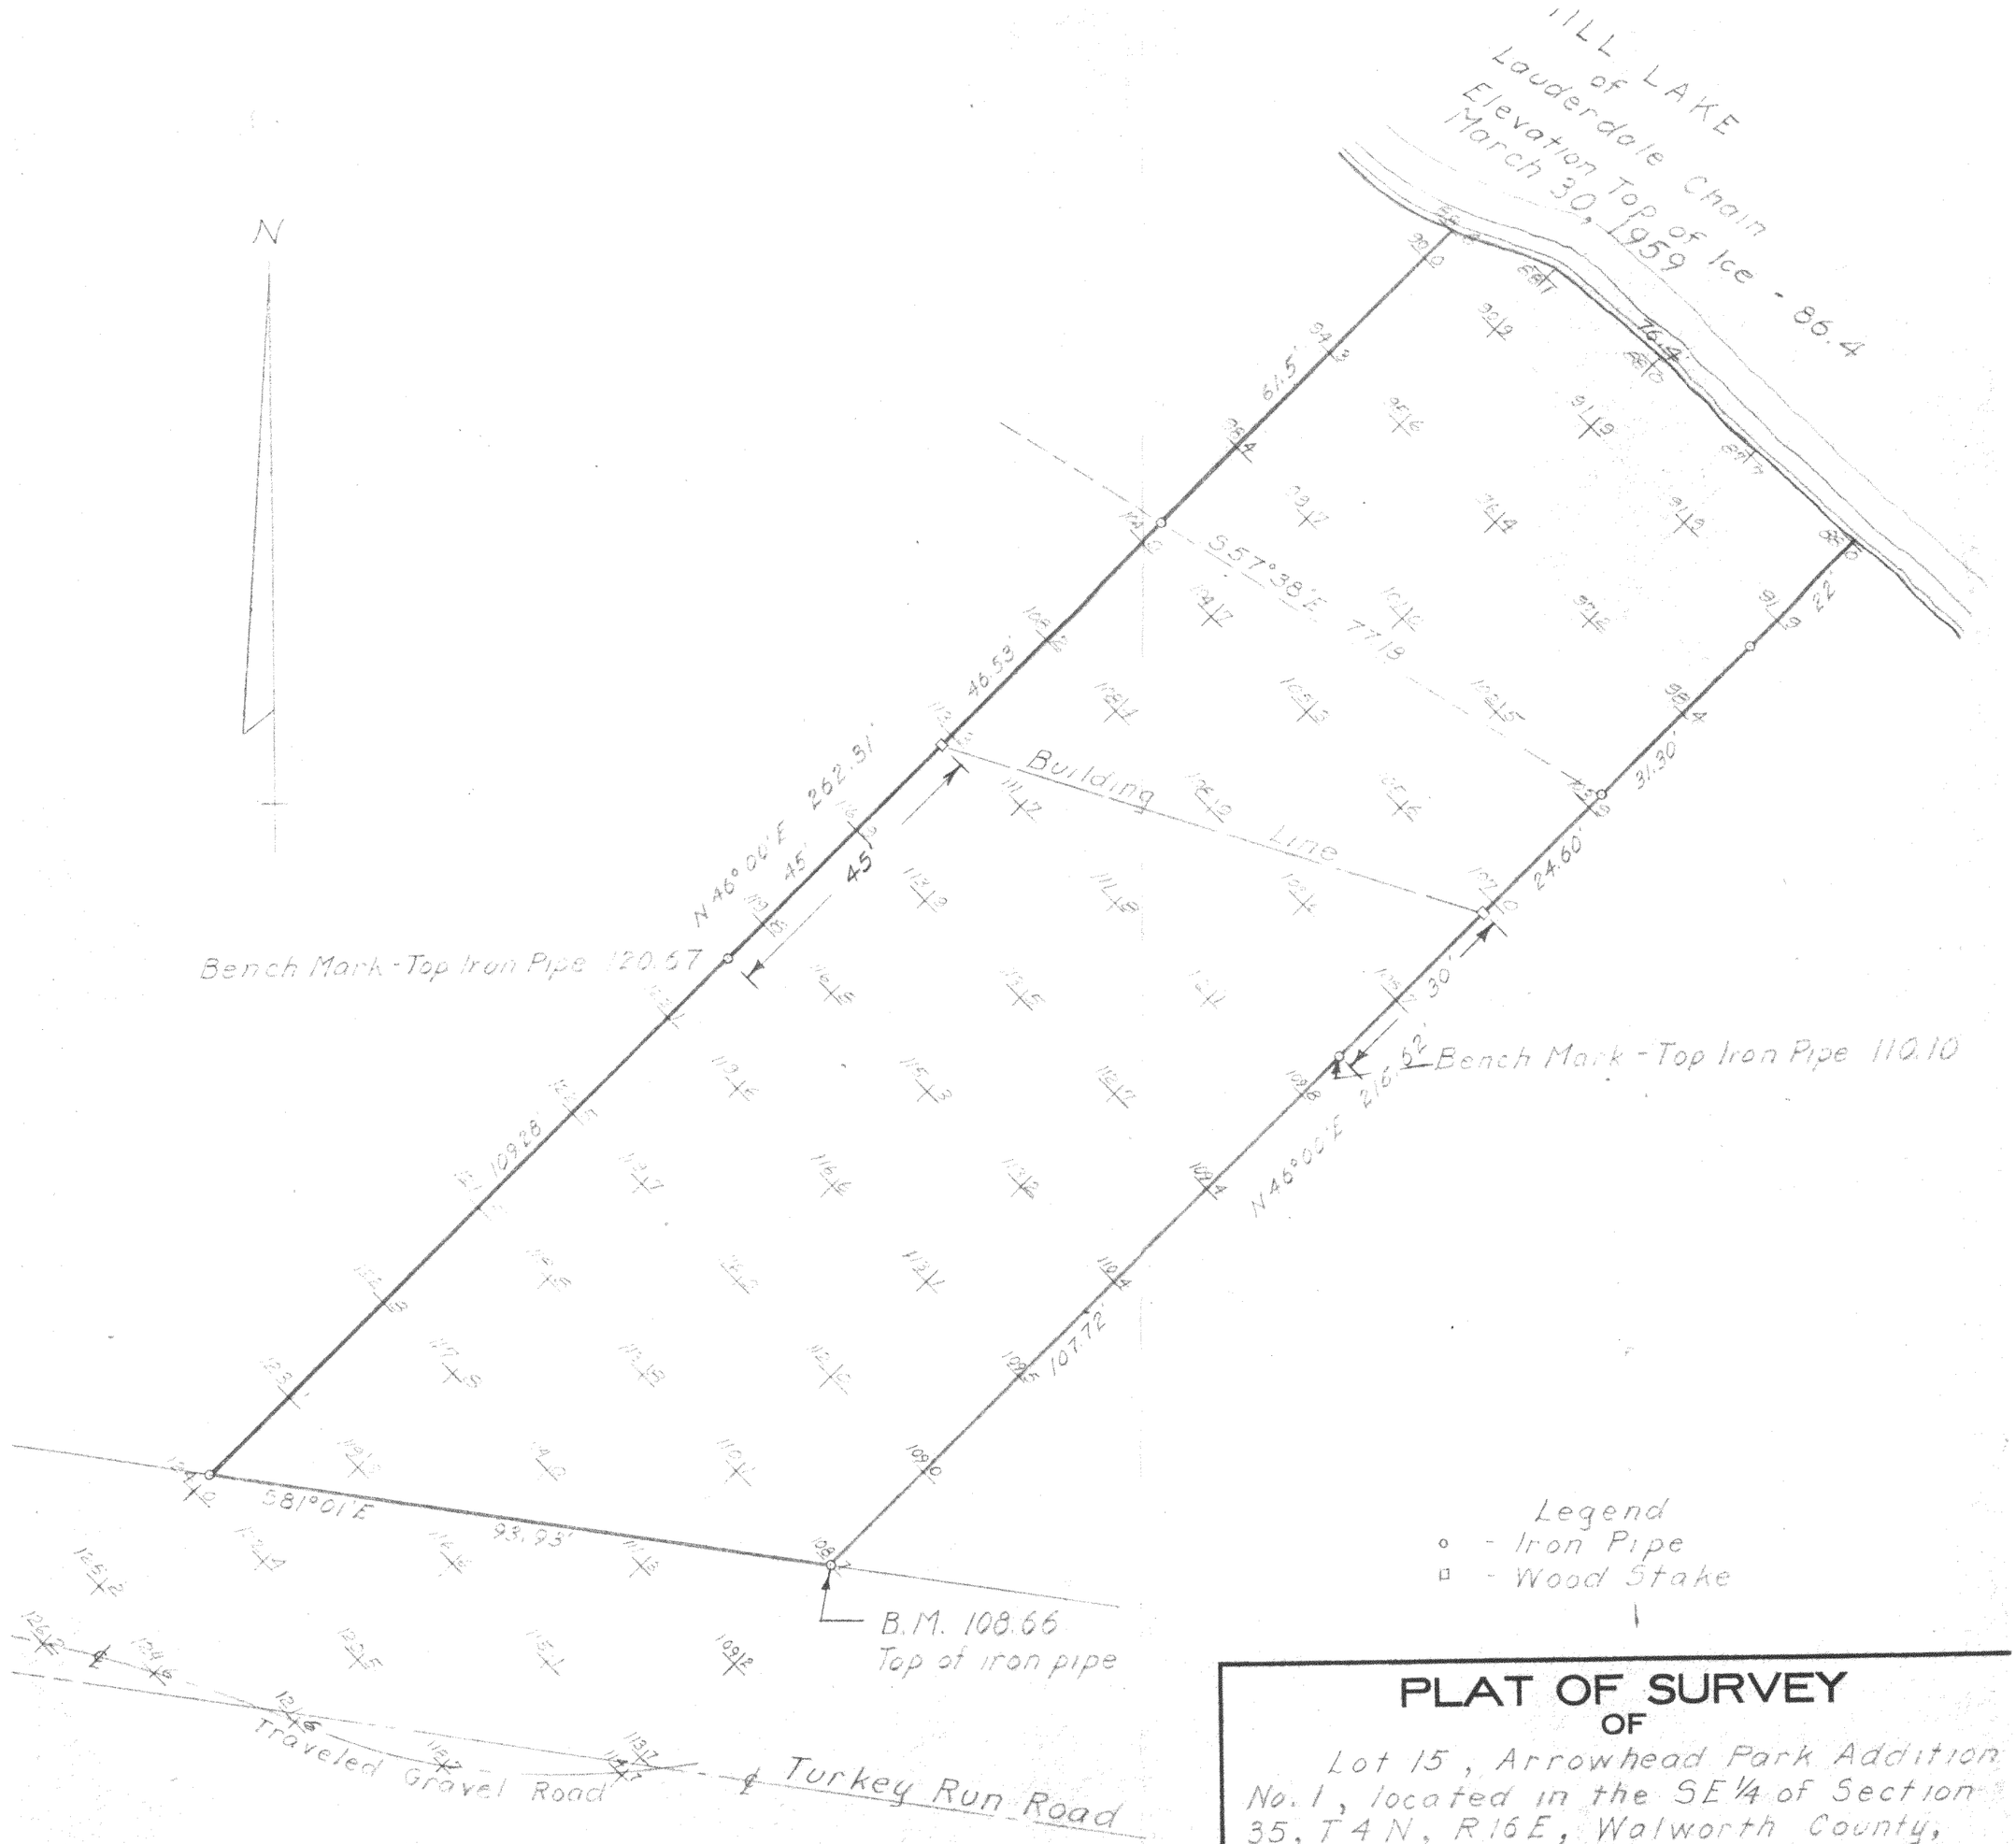

PLAT OF SURVEY
OF

Lot 15, Arrowhead Park Addition No. 1, located in the SE¼ of Section 35, T4N, R16E, Walworth County, Wisconsin.

Lloyd L. Jensen
SURVEYOR

SCALE 1" = 20'

DATE March 1959

Topo Map
MAPA-5

416-103.1