


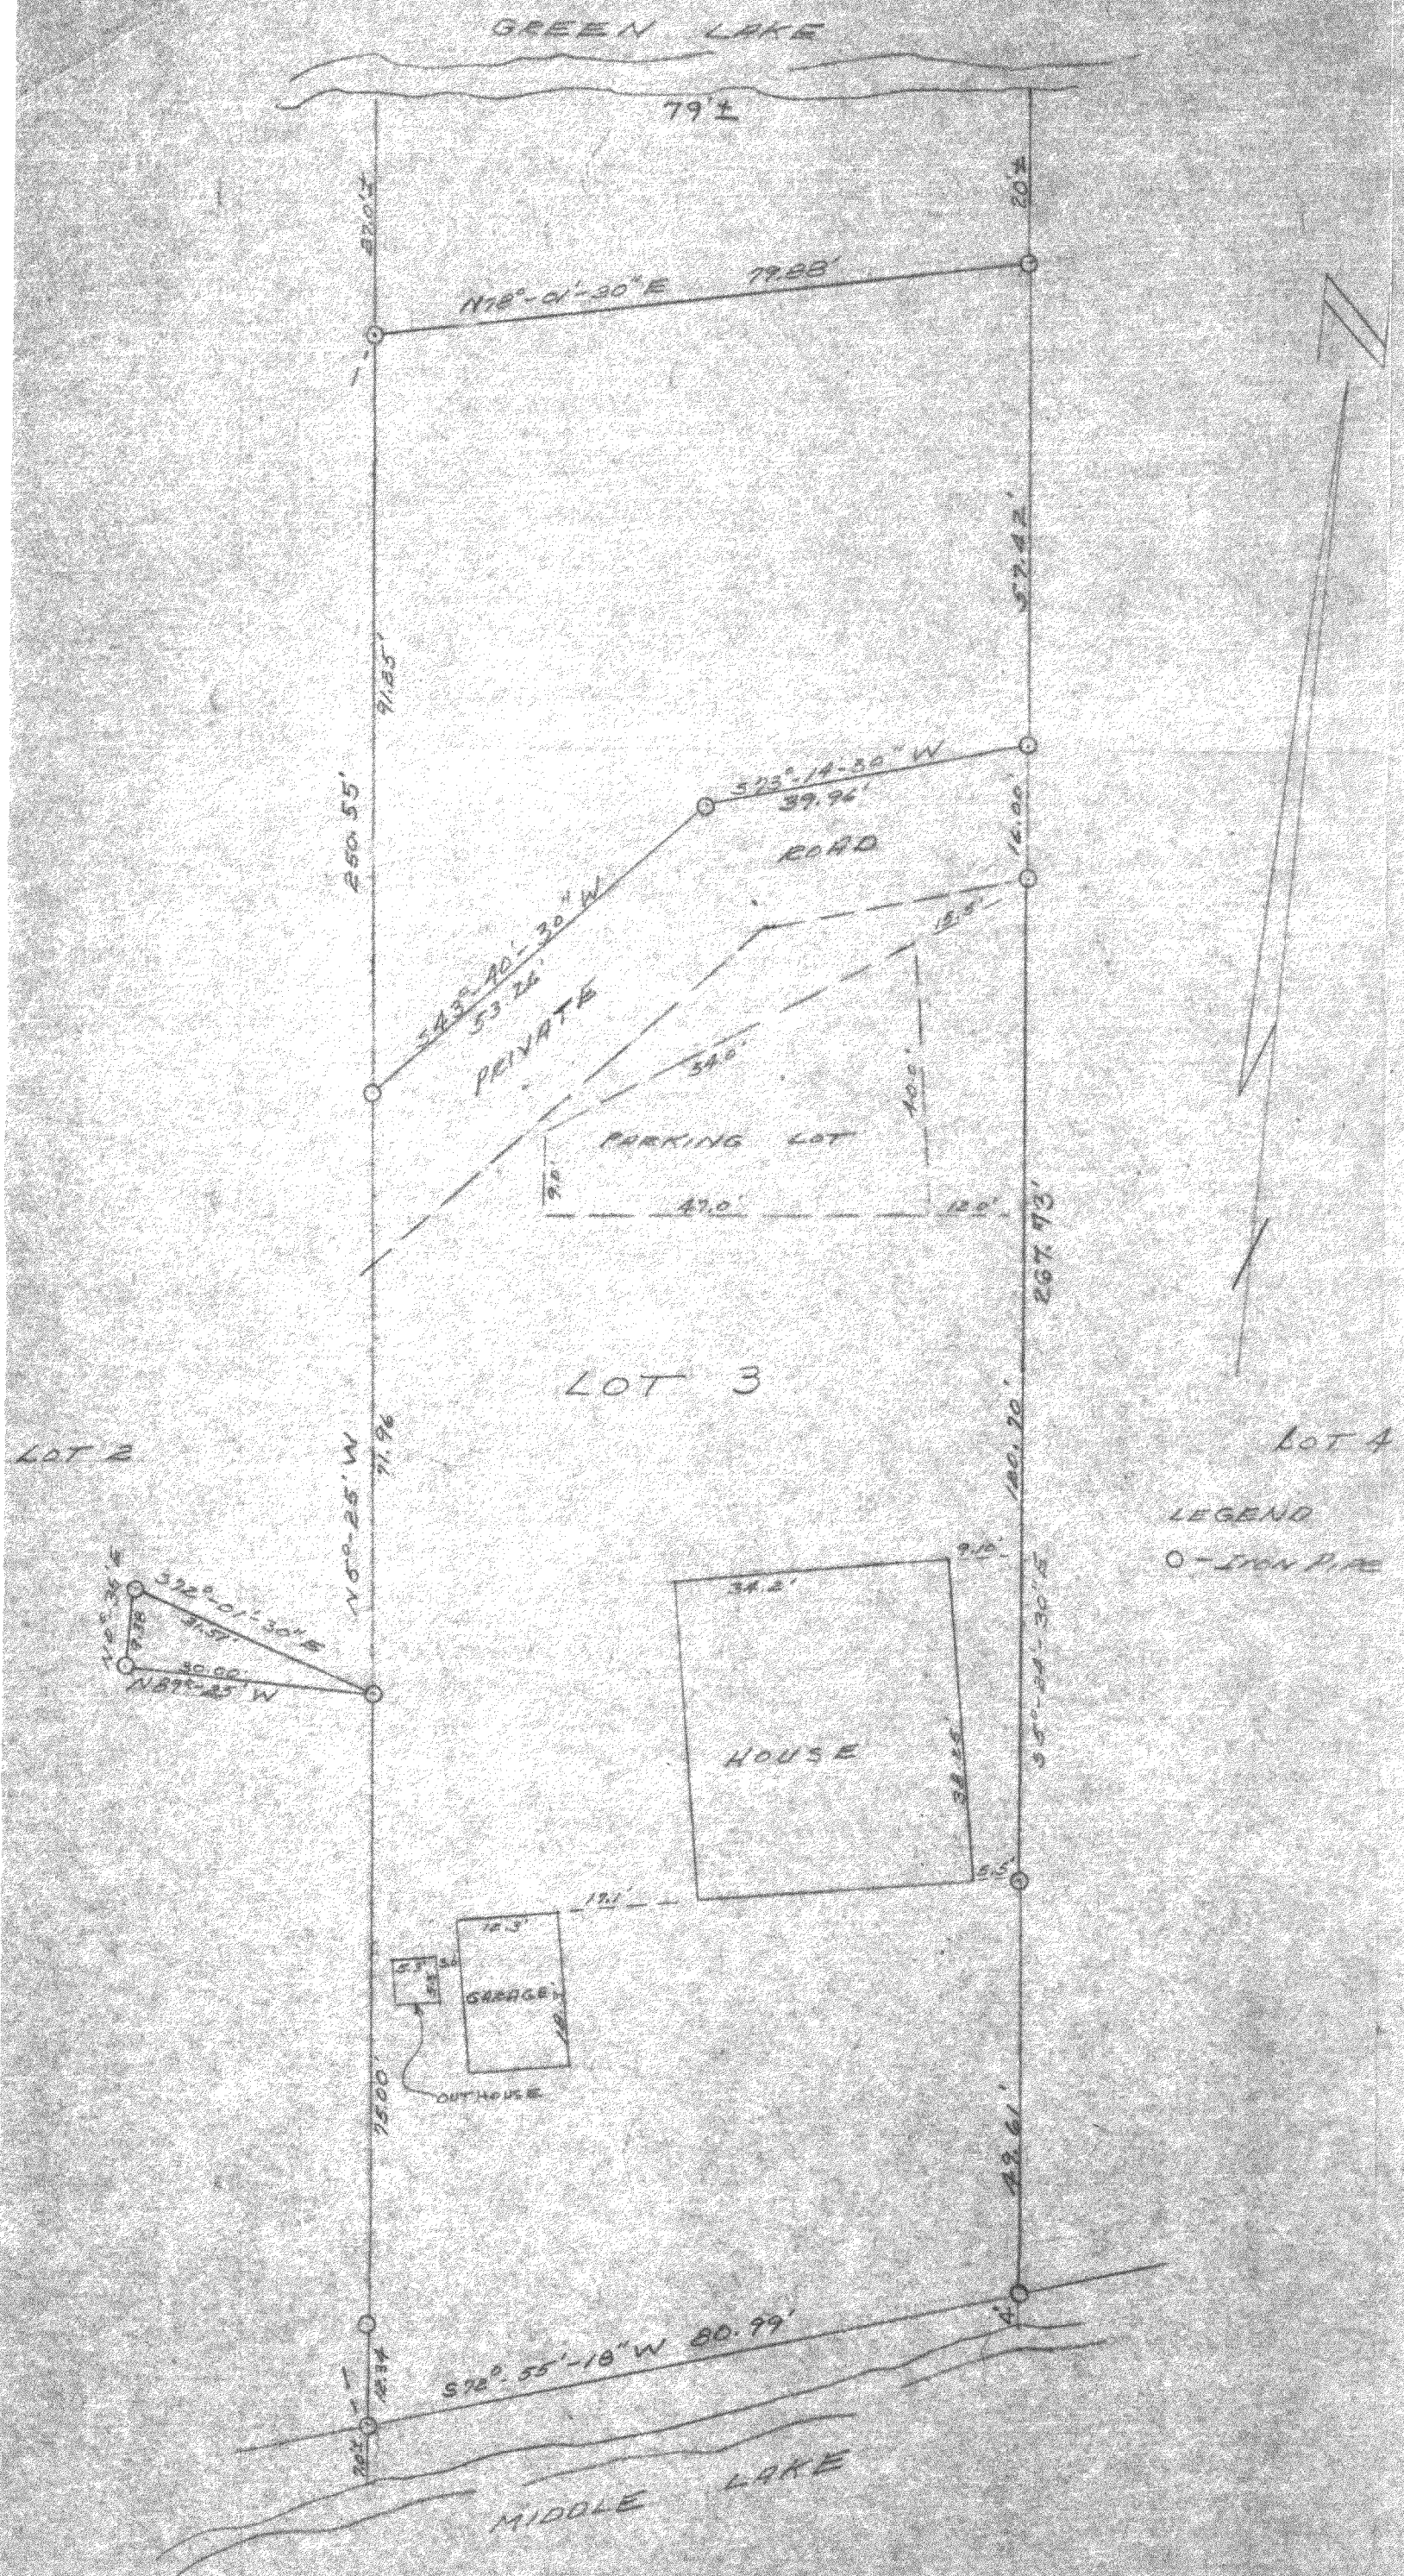

PLAT OF SURVEY OF

LOT 3 AND PART OF LOT 2 OF
LAUDERDALE PARK SUBDIVISION,
LOCATED IN THE SW 1/4 OF SECTION
25, T4N R1E, WALWORTH
COUNTY WISCONSIN.

Lloyd Jensen
SURVEYOR

SCALE 1" = 20'

DATE Nov 1964

HLP 44 + D 410-3

416-112.1