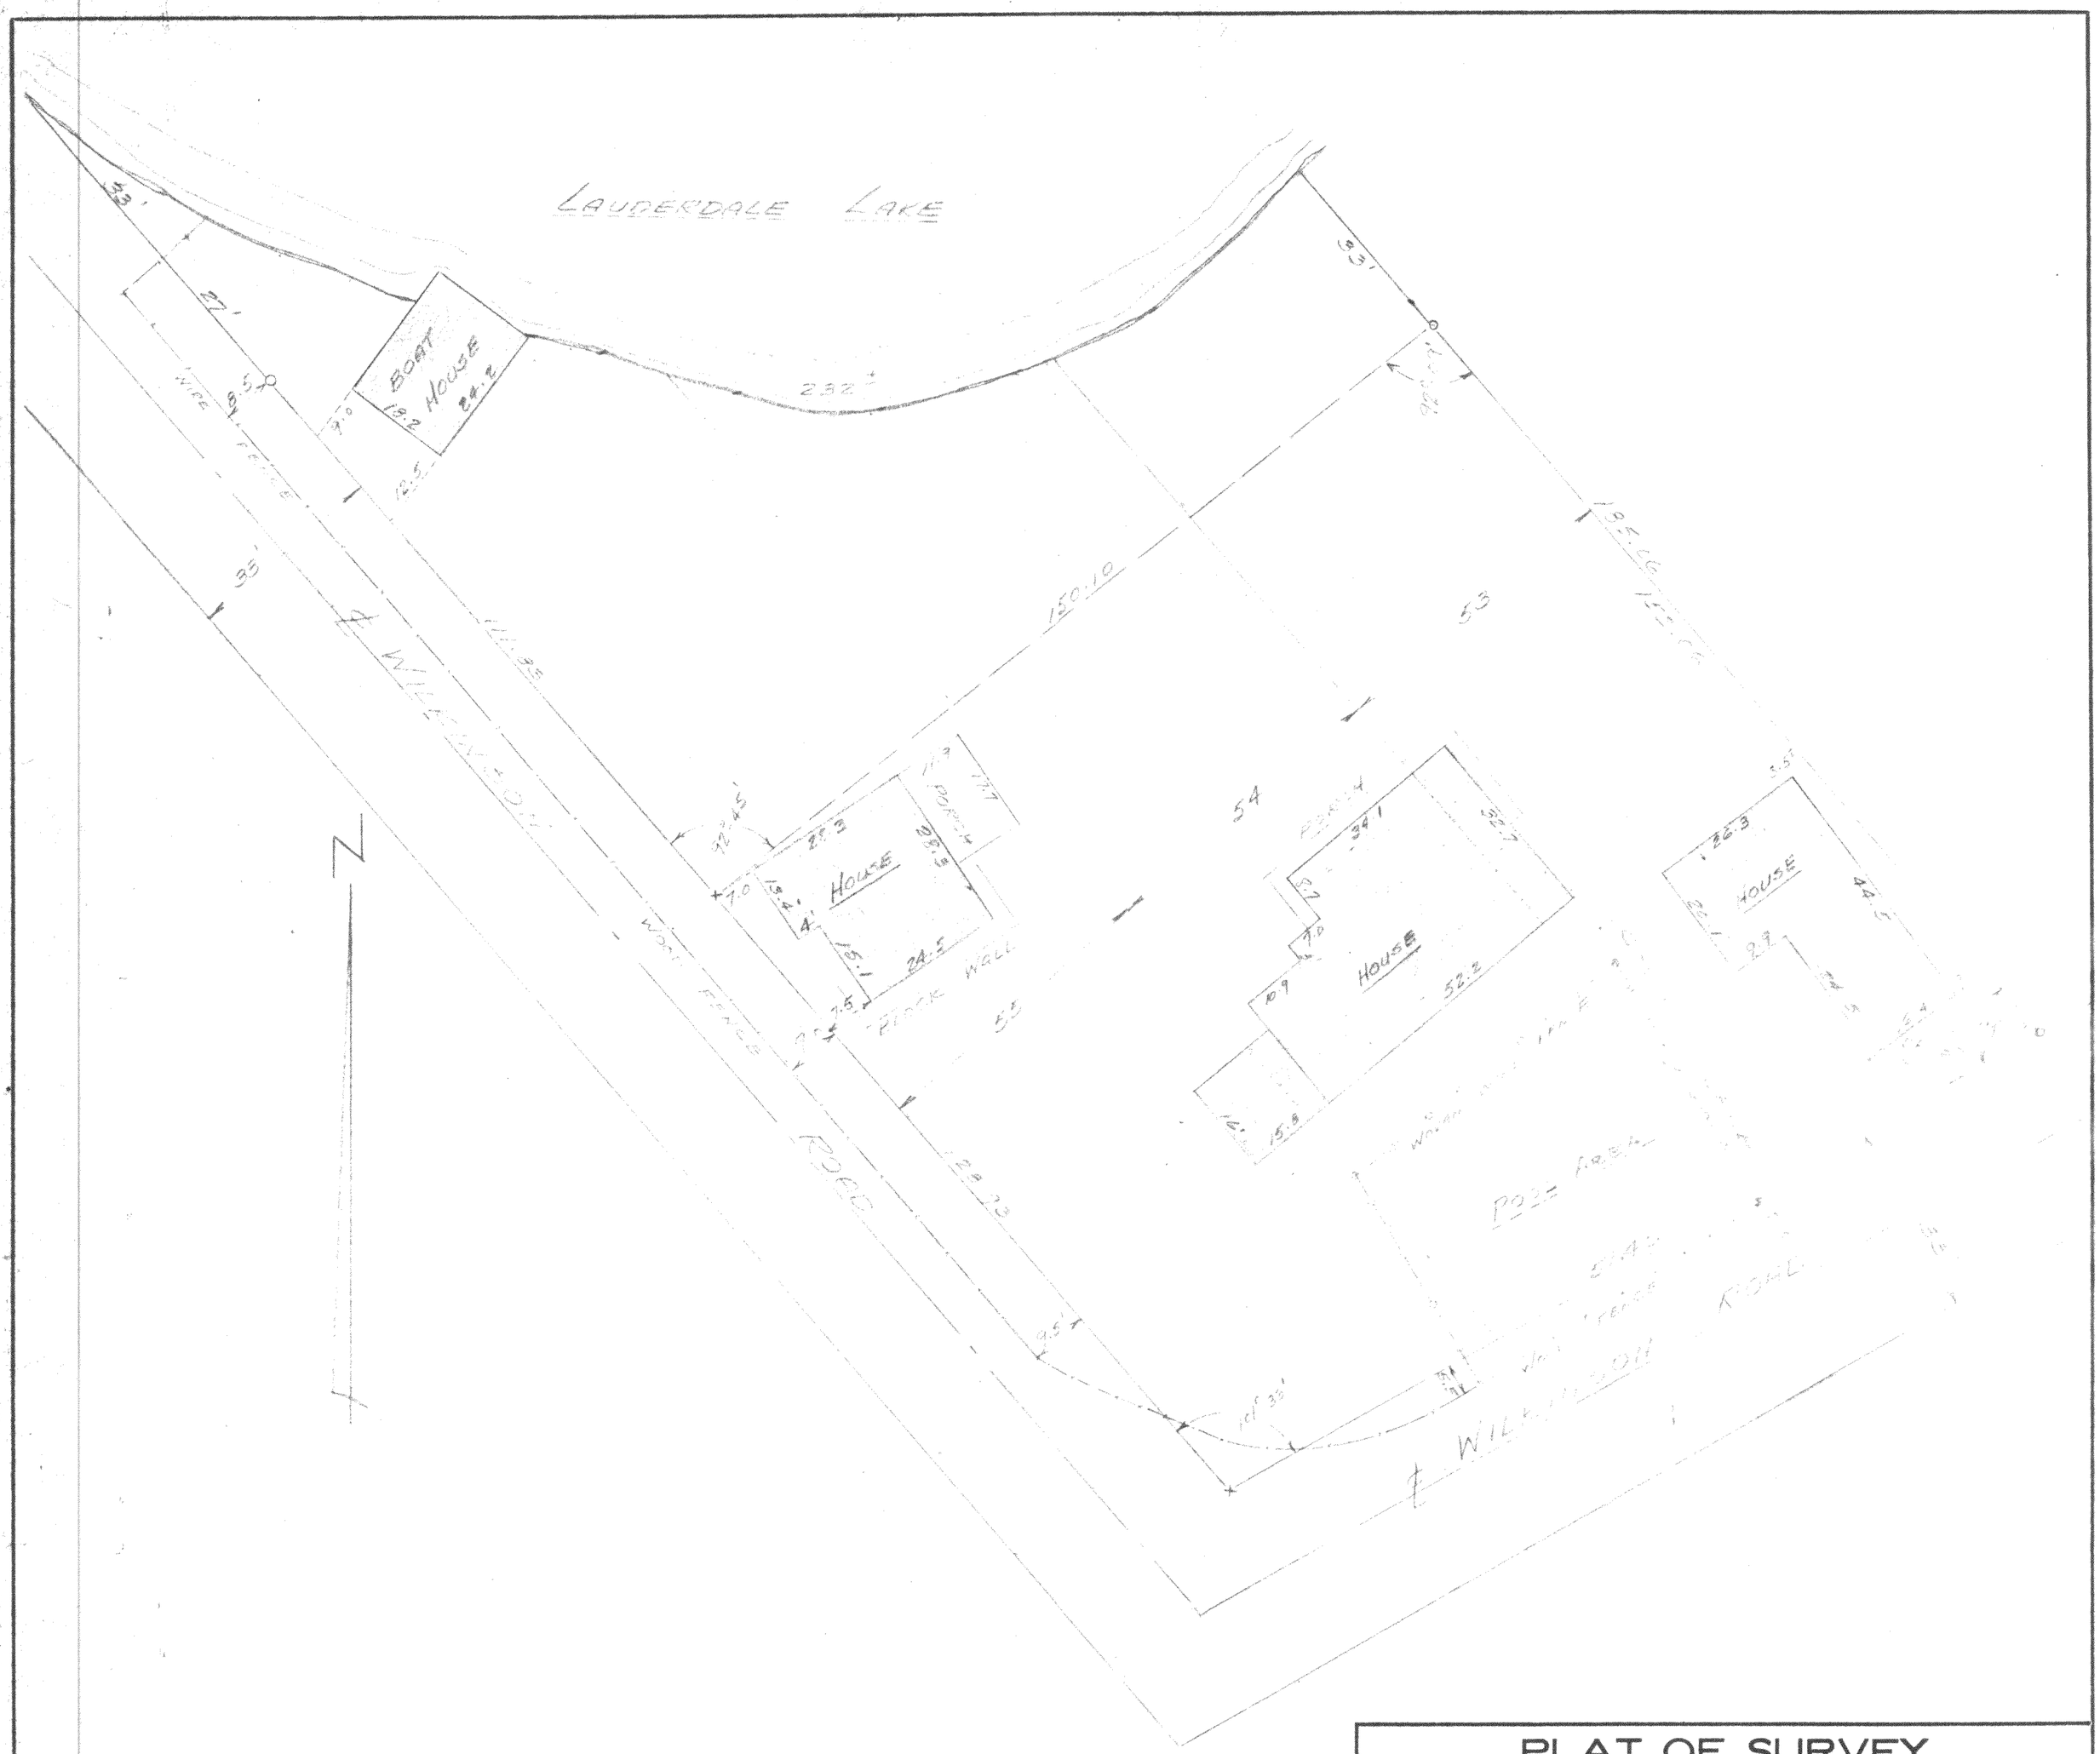

PLAT OF SURVEY
OF

LOT 53-54-55 LAUDERDALE HEIGHTS, T4N-R16E
WALWORTH COUNTY, WISCONSIN.

Lloyd L. Jensen
SURVEYOR

SCALE 1" = 20'

DATE MAR. 29, 1966

WISCONSIN
LLOYD L. JENSEN
ELKHORN, WIS.
LAND SURVEYOR

HLH-16,17,18

416-117.1

PLAST NO. 175H—400—1-30-58