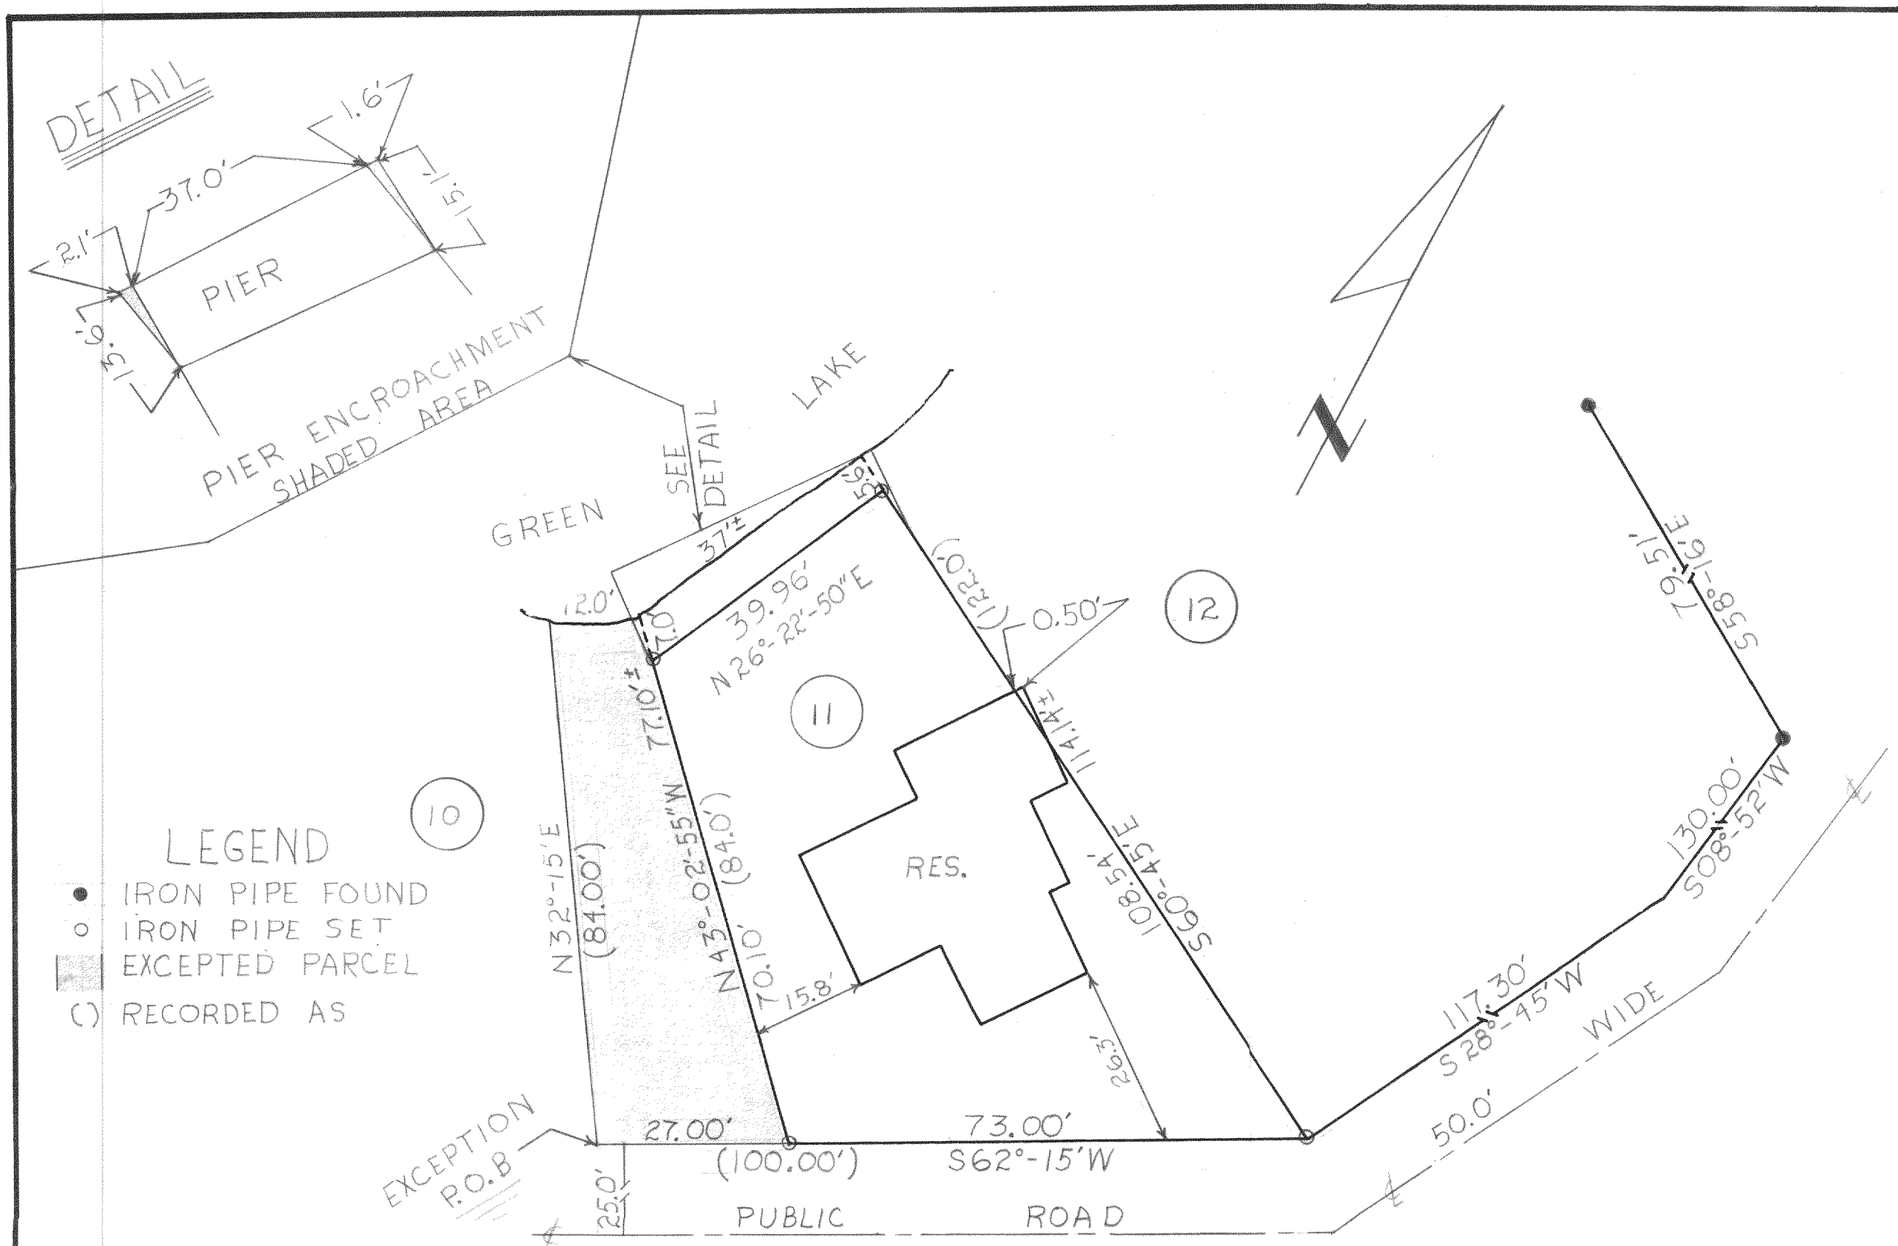


DESCRIPTION:

ALL OF LOT 11, IN LA SELVA SUBDIVISION, WALWORTH COUNTY, WISCONSIN, EXCEPT THE FOLLOWING DESCRIBED PARCEL; COMMENCING AT THE SOUTH WEST CORNER OF SAID LOT 11, THENCE N32°-15'E ALONG THE SOUTHWESTERLY LOT LINE OF SAID LOT 11, 84.0' FEET MORE OR LESS TO THE SHORE OF GREEN LAKE; THENCE NORTHEASTERLY ALONG THE SHORE OF GREEN LAKE 12.00' FEET; THENCE S43°-02'-55"E, 77.10' FEET TO THE SOUTH LINE OF SAID LOT 11; THENCE S62°-15'W ALONG THE SOUTH LINE OF LOT 11, 27.00' FEET TO THE PLACE OF BEGINNING.

DATE: SEPTEMBER 18 1975

CERTIFICATE:

I, JOSEPH M. BIAGI, SURVEYOR, DO HEREBY CERTIFY THAT I HAVE SUVEYED THE LANDS HEREON DESCRIBED.

JOSEPH M. BIAGI R.L.S. #12

WISCONSIN JOSEPH M. BIAGI S-12 ELKHORN WIS. LAND SURVEYOR

REVISIONS		
NO.	DATE	BY
1		
2		
3		
4		
5		

DONALD VAN SCOTTER

LOT 11 LA SELVA SUB.
WALWORTH COUNTY WIS.

DRAWN BY H.WG	SCALE 1" = 20'	MATERIAL
CHK'D	DATE 9-18-75	DRAWING NO. #93-75
TRACED	APP'D	

HL-9

416-19B

TELEDYNE POST 18AE-10E—12X18