
ABELL
SURVEYING & MAPPING
DELAVAN, WISCONSIN 53115
414-728-6737

RECEIVED
MAR 13 1996
Alc

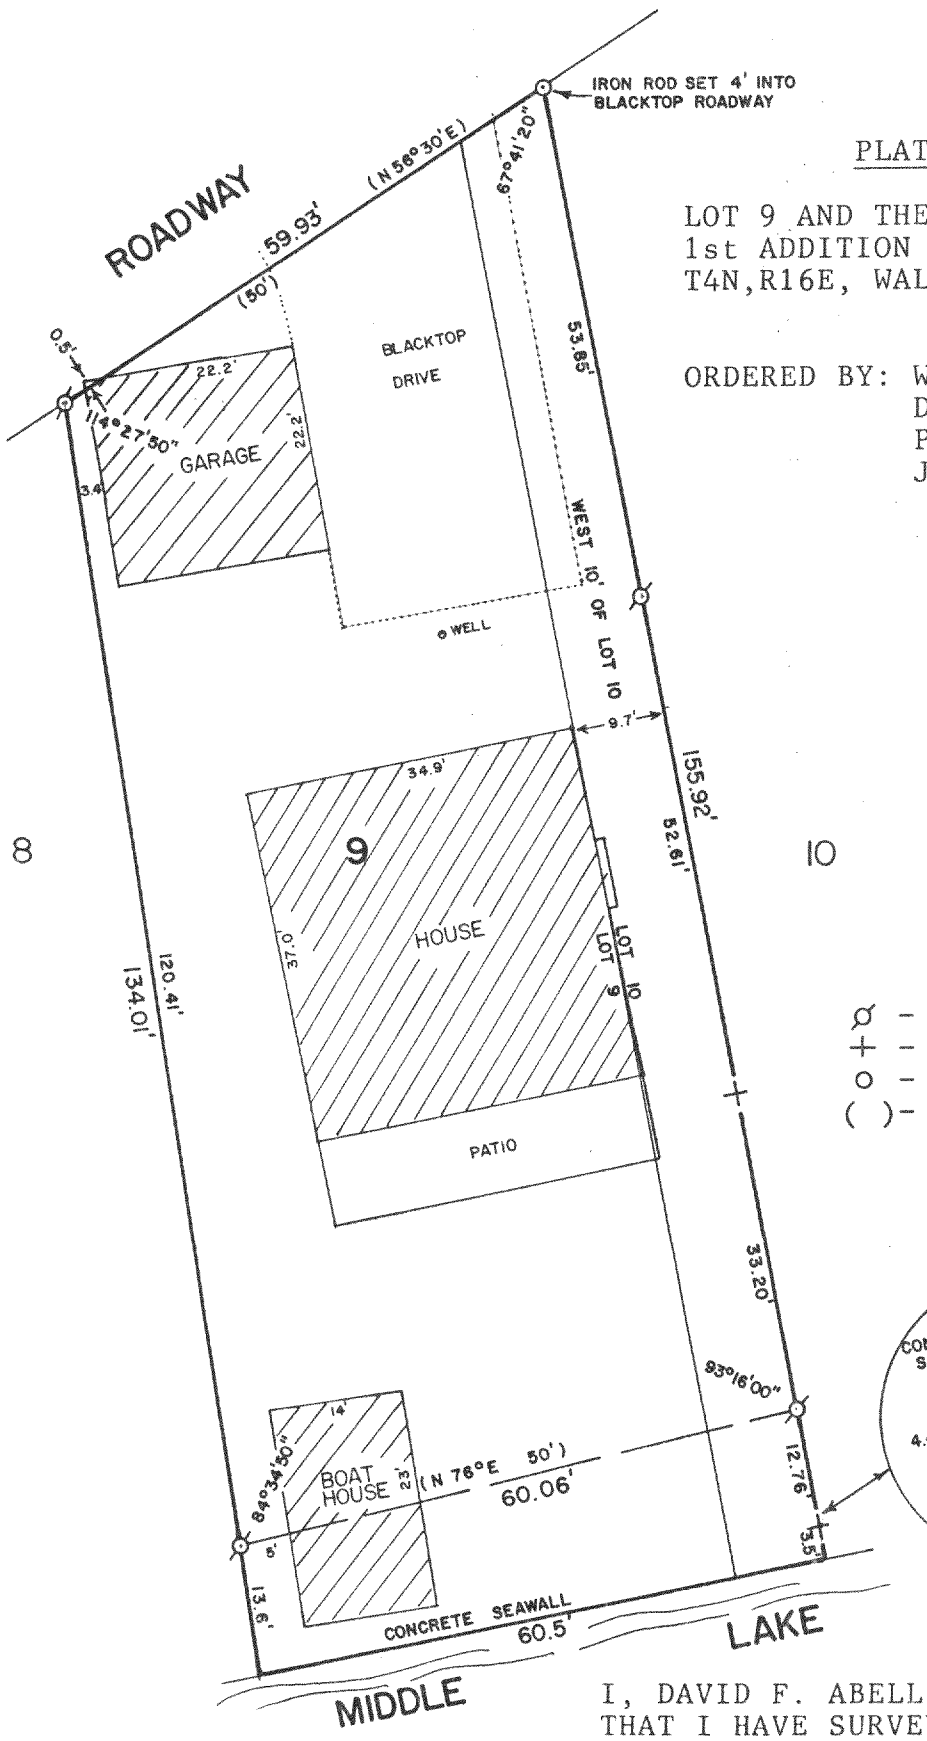

8

10

PLAT OF SURVEY OF


LOT 9 AND THE WEST 10 FEET OF LOT 10,
1st ADDITION TO LAUDERDALE PARK,
T4N,R16E, WALWORTH COUNTY, WISCONSIN.

ORDERED BY: WALLEY BUSH
DATA DIMENSIONS CORP.
P.O. BOX 1465
JANESVILLE, WI. 53547

SCALE - 1"=20'

LEGEND
ø - IRON PIPE FOUND
+ - CUTCROSS IN CONCRETE FOUND
o - IRON ROD SET, found 9/27/95
( )- RECORDED AS

INSERT NOT TO SCALE

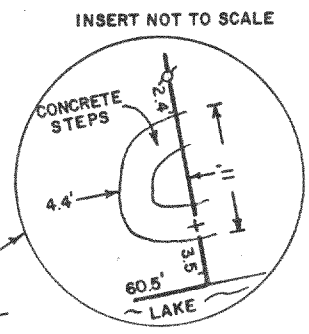

REVISED: SEPT. 28, 1995
ORDERED BY: COLONY REALTY
P.O. BOX 83
ELKHORN, WI
53121

I, DAVID F. ABELL, DO HEREBY CERTIFY THAT I HAVE SURVEYED THE PROPERTY HEREON DESCRIBED ACCORDING TO THE OFFICIAL RECORDS AND THAT THE PLAT HEREON IS A CORRECT REPRESENTATION OF THE PROPERTY LINES TO THE BEST OF MY KNOWLEDGE AND BELIEF.

David F. Abell
DAVID F. ABELL
WISCONSIN REGISTERED LAND SURVEYOR, S-1596

October 6, 1988
DATE JOB NUMBER - 88232

NOTE: THIS IS NOT A CERTIFIED COPY UNLESS SEALED.

416-1213
REVISED: MARCH 21, 1990

HLPA-2