PLAT OF SURVEY

RECEIVED
JUL 7 1996
SLC

LEGAL DESCRIPTION

LOTS 25 & 26 AND THE N'LY 20 FEET OF LOT 27, FROEDERT'S GREEN LAKE PARK SUBDIVISION, LOCATED IN SECTION 26, T4N, R16E, WALWORTH COUNTY, WISCONSIN

CLIENT: RUTH ALICE DOMINK


SURVEYOR'S CERTIFICATE

I, JAMES K. LANGONE, REGISTERED LAND SURVEYOR, CERTIFY THAT I HAVE SURVEYED THE PROPERTY DESCRIBED, AND THAT THE PLAT SHOWN HEREON IS A CORRECT REPRESENTATION OF THE BOUNDARIES THEREOF.

DATE: 7/10/96

WISCONSIN JAMES K. LANGONE S-1347 WHITEWATER WI SURVEYOR

JAMES K. LANGONE
REG. LAND SURVEYOR S-1347

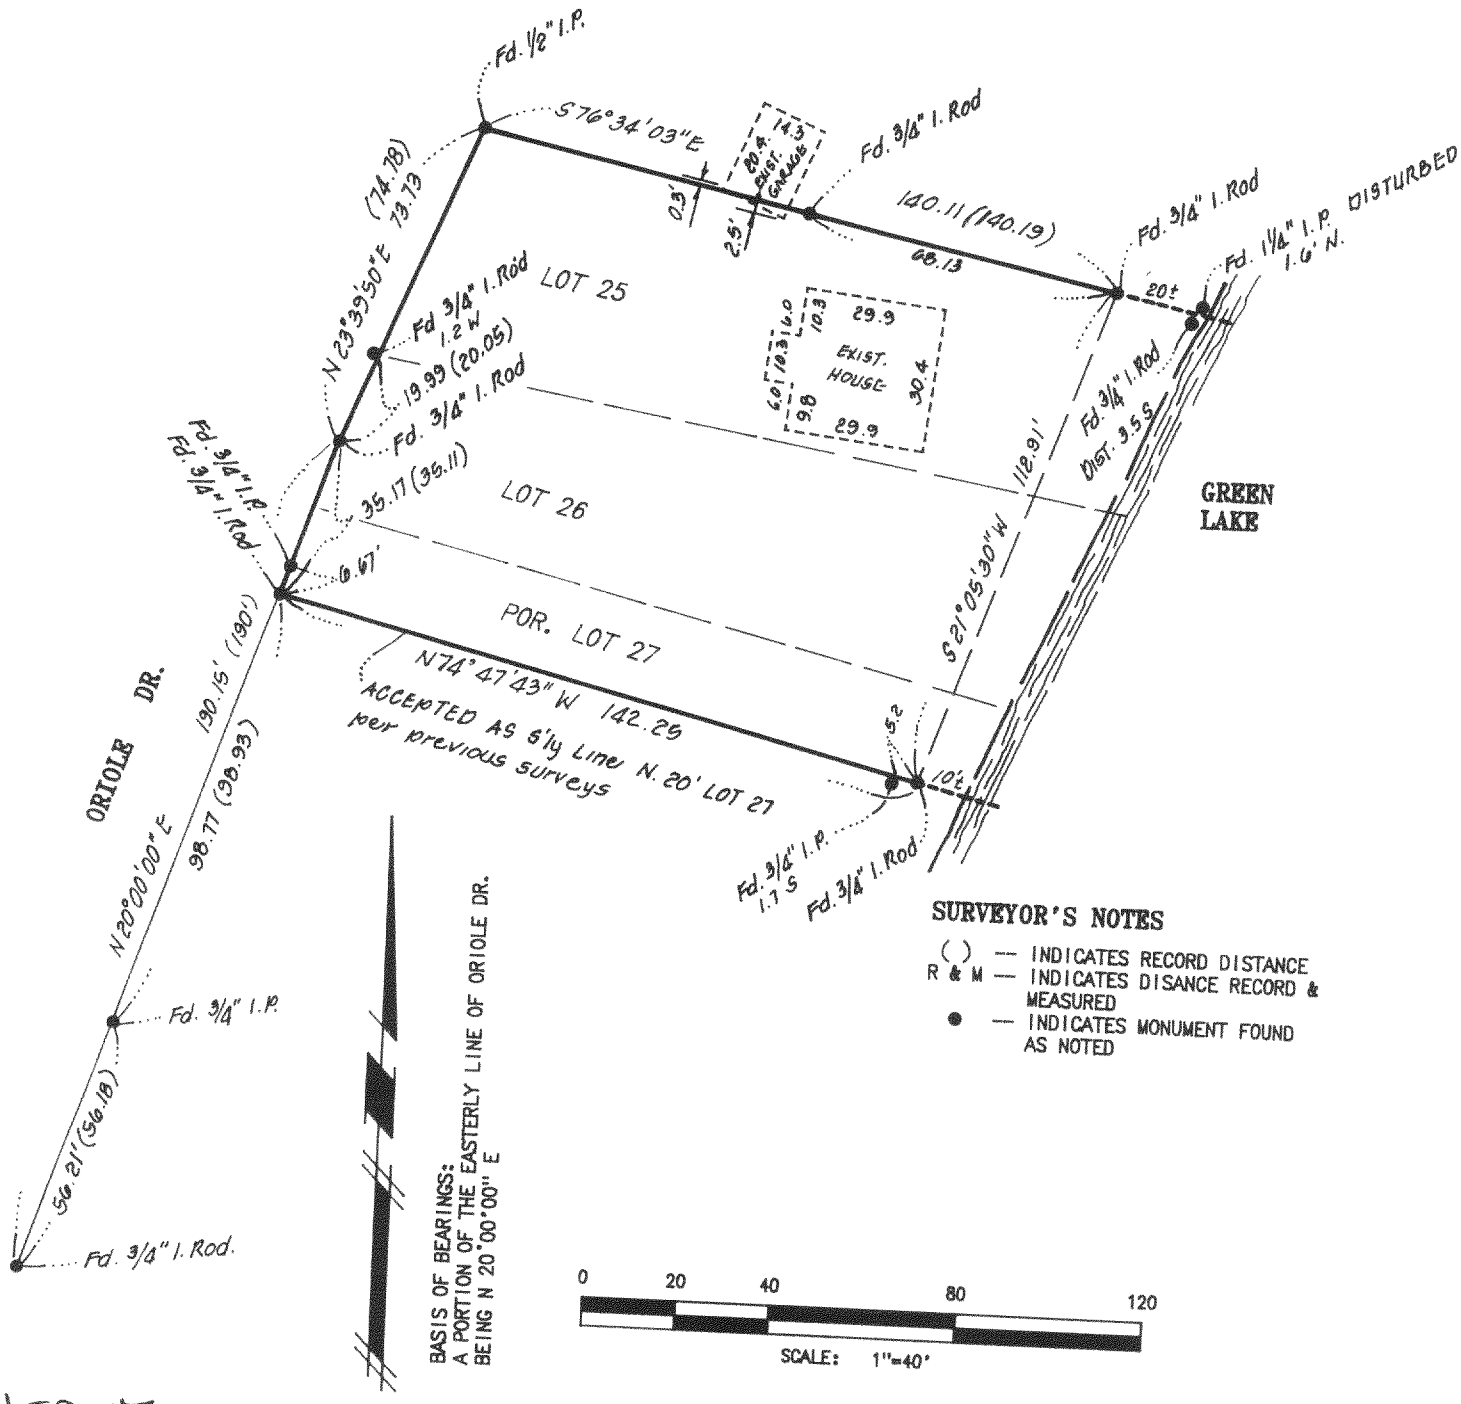

SURVEYOR'S NOTES

( ) — INDICATES RECORD DISTANCE
R & M — INDICATES DISANCE RECORD & MEASURED
● — INDICATES MONUMENT FOUND AS NOTED

HFP-17
HFP-18
416-1216

JAMES K. LANGONE
LAND SURVEYS & CIVIL ENGINEERING
N339 Co. Rd. "N" (Upper) Whitewater, Wi. 53190-2842 (414) 473-4119

JN: 96-114