ABERNATHY and ASSOCIATES
Kenneth B. Abernathy Jr.
Wisconsin Registered Land Surveyor S-1594


Rt. 3, Box 273
Elkhorn, Wisconsin 53121
Phone: (414) 723-4260 (office)
(414) 723-7209 (FAX)

PLAT OF SURVEY

LOT 1 OF CERTIFIED SURVEY MAP NO. 1545 AS RECORDED IN VOL. 7 OF CERTIFIED SURVEY MAPS AS PAGES 172 AND 173 AS DOCUMENT NO. 137687, BEING LOCATED IN THE SOUTHWEST 1/4 AND THE SOUTHEAST 1/4 OF THE NORTHWEST 1/4 OF SECTION 11, TOWN 4 NORTH, RANGE 16 EAST, WALWORTH COUNTY, WISCONSIN.

OWNERS: CLEM AND ANGELA MEAS

SUBJECT PROPERTY ADDRESS: W5621 TAMARACK TRAIL
WHITEWATER, WI. 53190

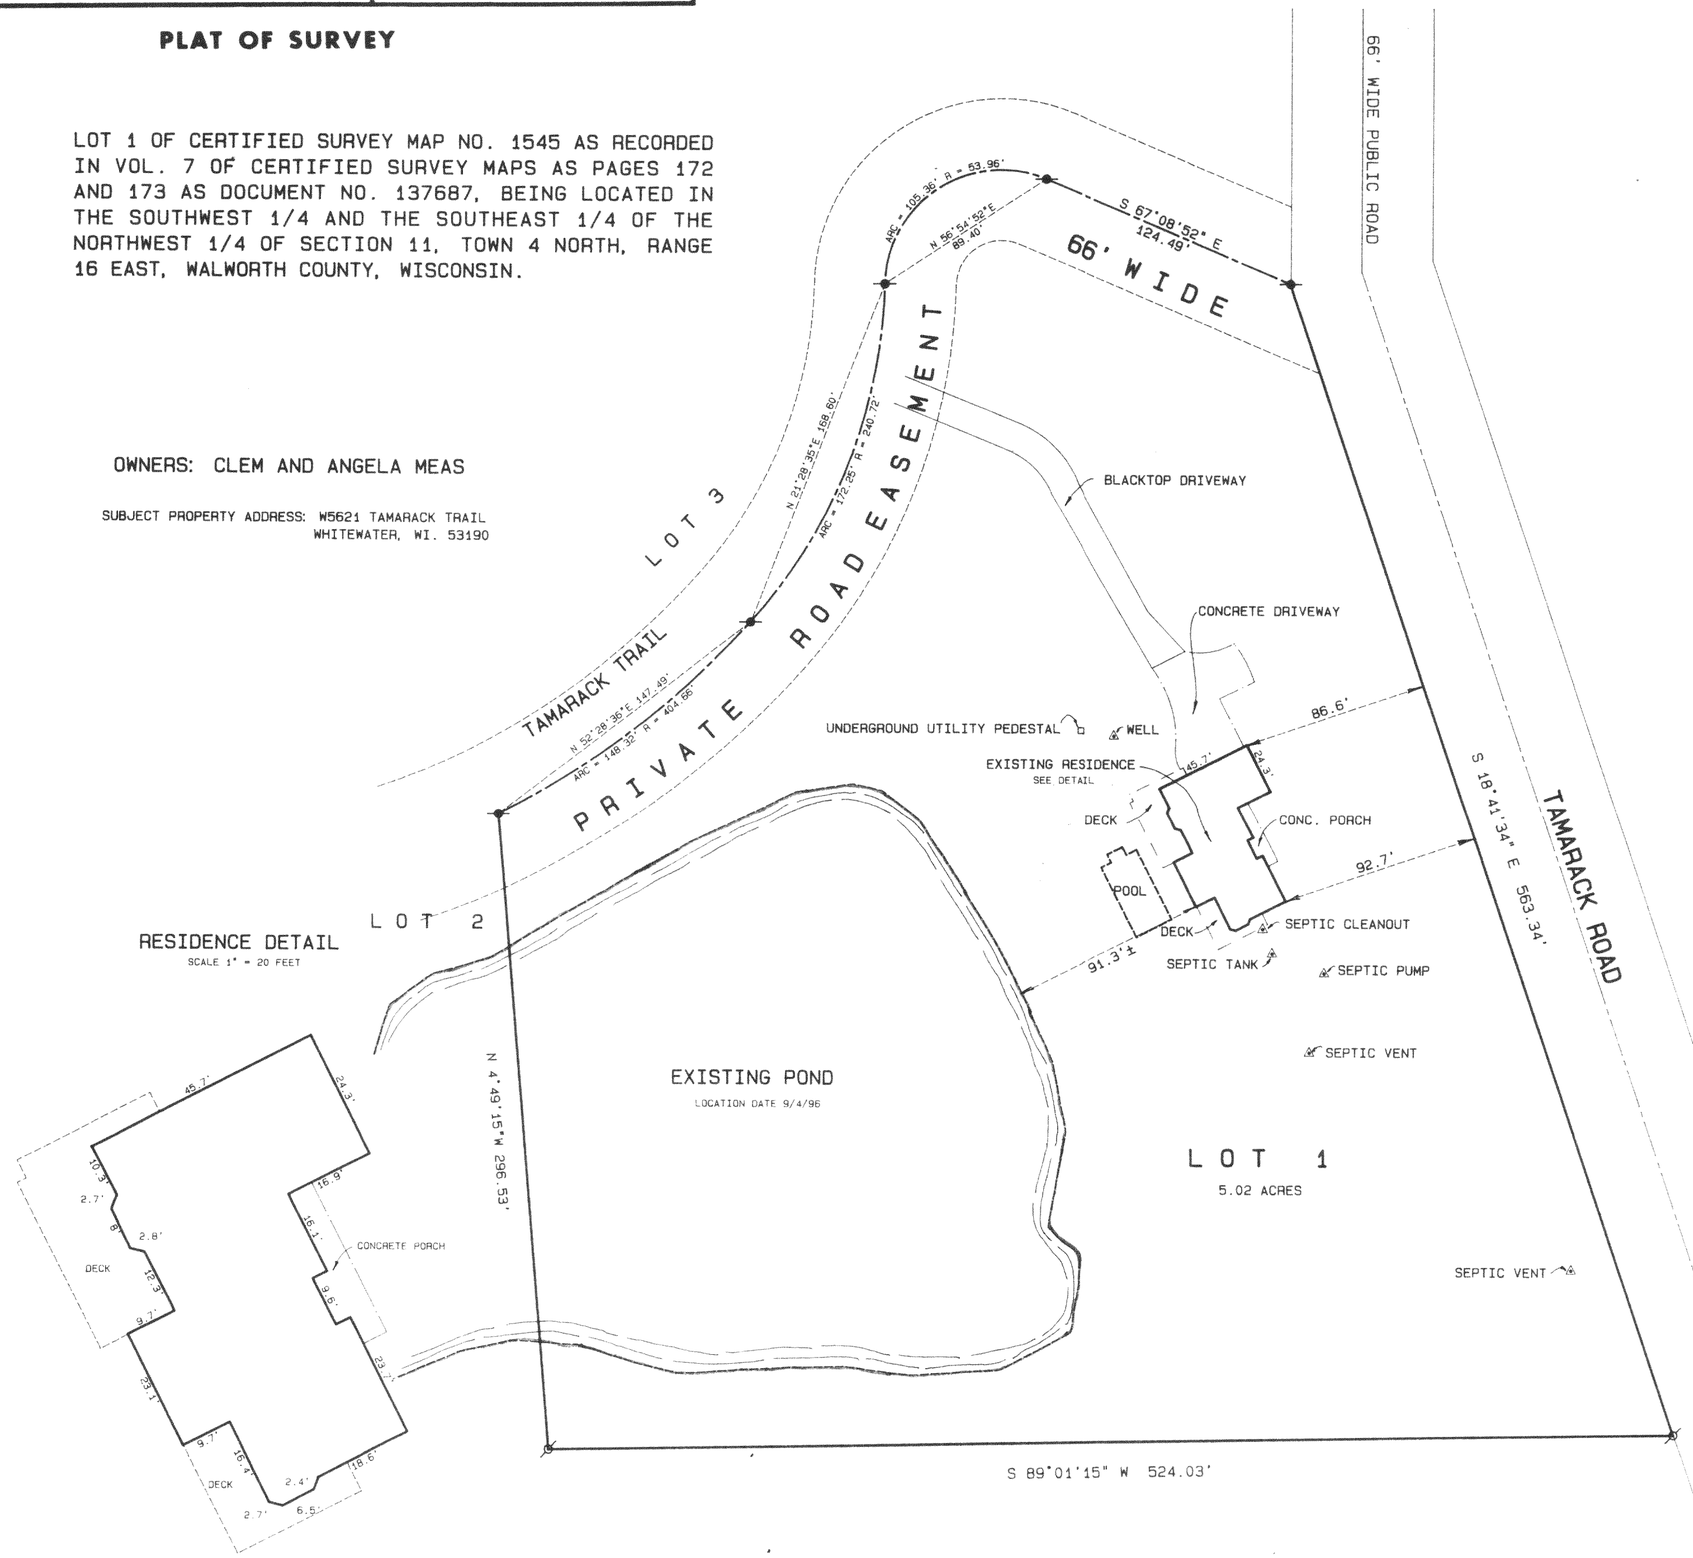

SCALE 1" = 50 FEET

BEARINGS ARE BASED ON CERTIFIED SURVEY MAP NO. 1545

Legend

- FOUND IRON PIPE
- FOUND IRON ROD
- FOUND BRASS CAPPED MONUMENT
- FOUND CONCRETE MONUMENT
- + CHISEL CUT IN CONCRETE
- SET IRON ROD, 24" LONG, WEIGHING 1.5 LBS /LINEAL FT., 3/4" DIA.
- SET IRON ROD, 30" LONG, WEIGHING 4.5 LBS. /LINEAL FT., 1-11/16" DIA.
- (xx) RECORDED AS DIMENSION
- —x—x— EXISTING FENCE

RECEIVED
DEC 27 1996

SCALE: 1"= 50 FEET

I hereby certify that the above described property has been surveyed by me or under my direction and that the above map is a true representation thereof and shows the size and location of the property, its exterior boundaries, the location of all visible structures and dimensions of all principal buildings thereon, boundary fences, apparent easements, roadways and visible encroachments, if any.

This survey is made for the use of the present owners of the property, and upon those who purchase, mortgage, or guarantee the title thereto within one year from date hereof.

WISCONSIN
KENNETH B. ABERNATHY, JR.
S-1594
ELKHORN, WI
LAND SURVEYOR

KENNETH B. ABERNATHY, JR.
WISCONSIN REGISTERED LAND SURVEYOR,
S-1594

Date SEPT. 4, 1996 Job No. 96-816

HA-1545-1

416-1234