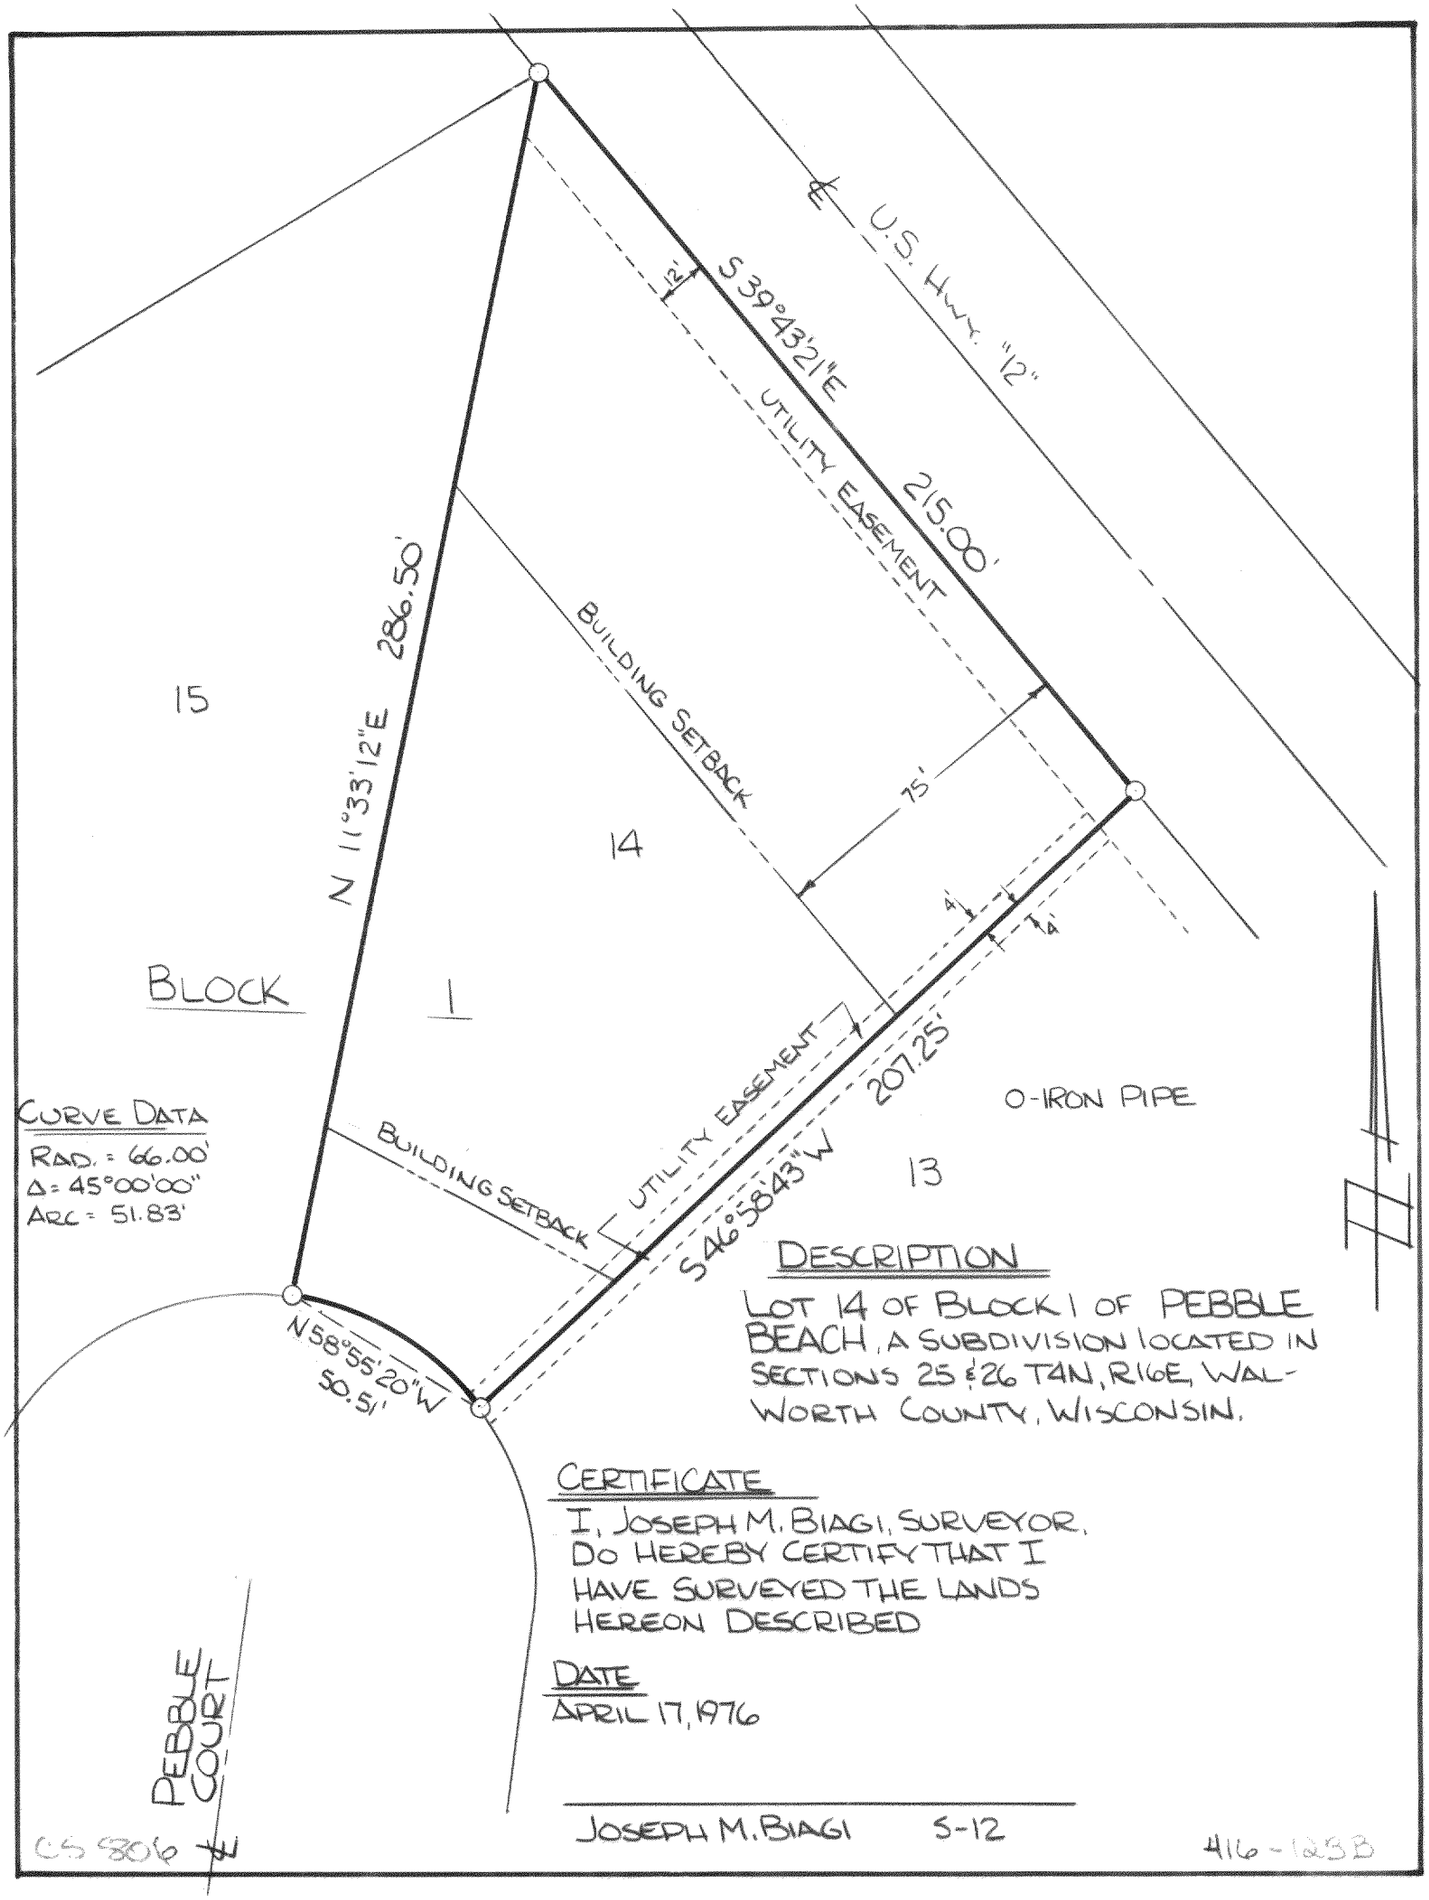

DESCRIPTION

LOT 14 OF BLOCK 1 OF PEBBLE BEACH, A SUBDIVISION LOCATED IN SECTIONS 25 & 26 T4N, R16E, WALWORTH COUNTY, WISCONSIN.

CERTIFICATE

I, JOSEPH M. BIAGI, SURVEYOR, DO HEREBY CERTIFY THAT I HAVE SURVEYED THE LANDS HEREON DESCRIBED

DATE

APRIL 17, 1976

JOSEPH M. BIAGI S-12