
RECEIVED
DEC - 5 1996

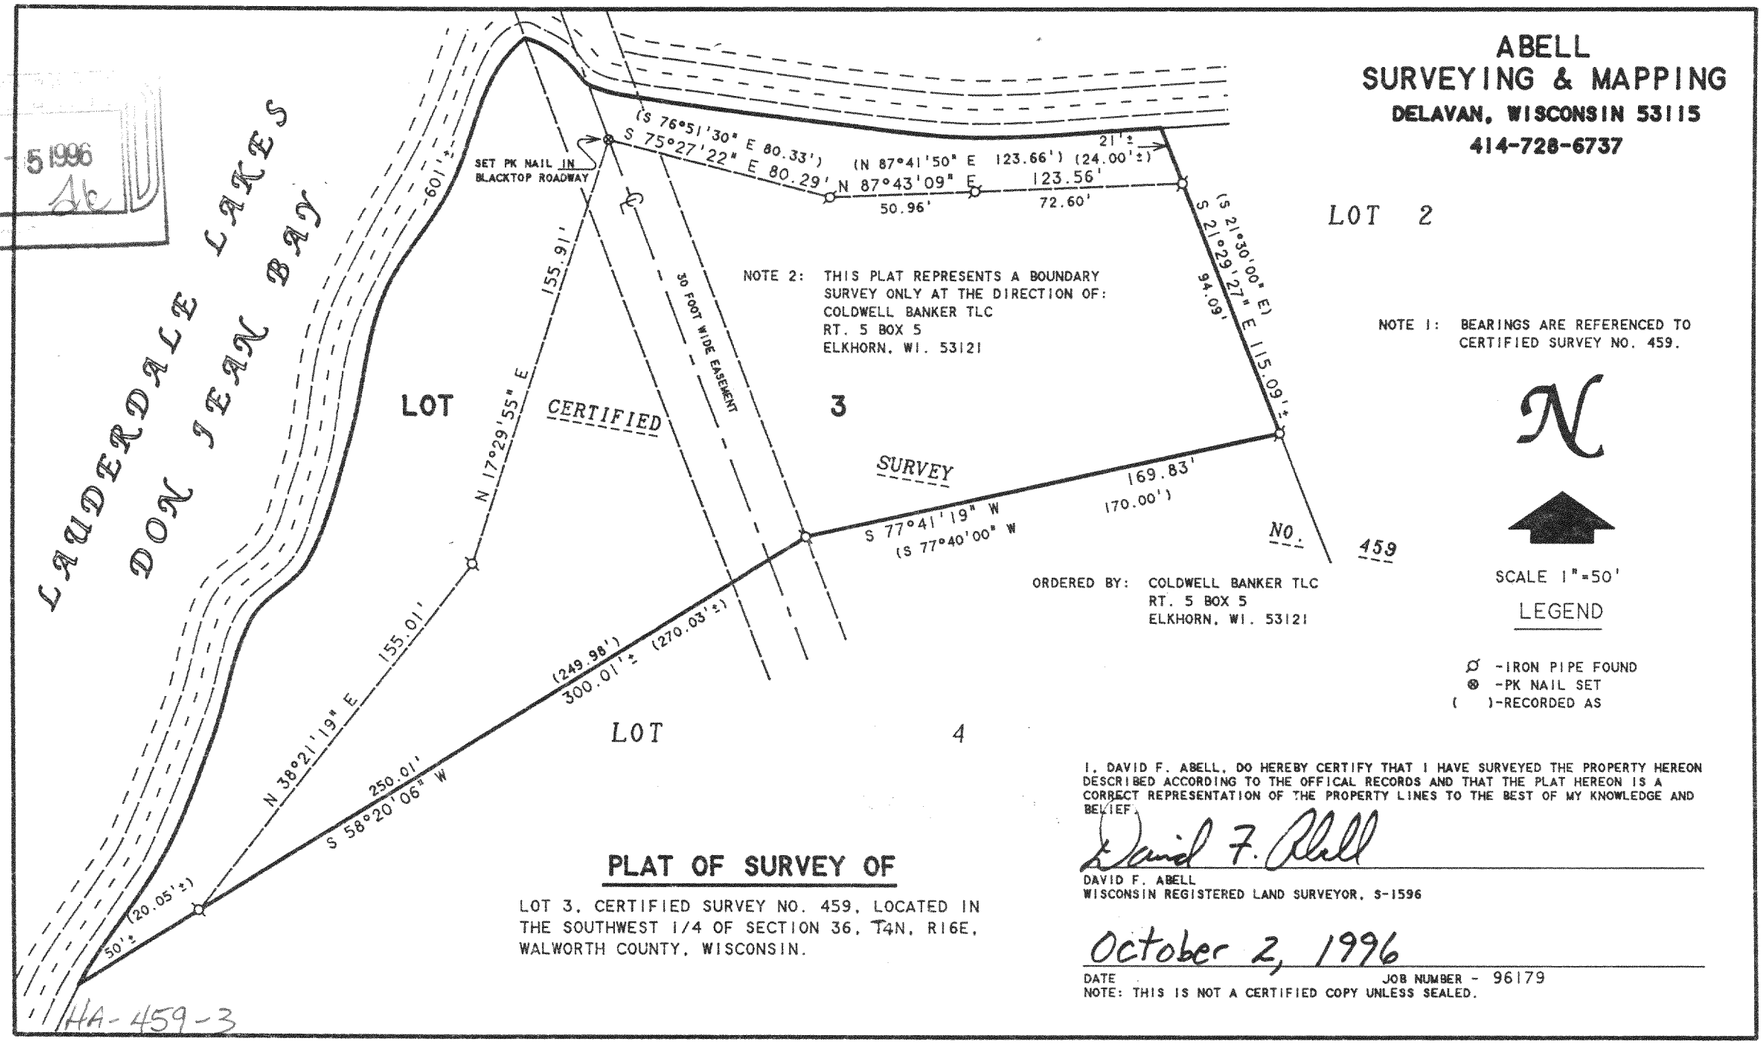

NOTE 2: THIS PLAT REPRESENTS A BOUNDARY SURVEY ONLY AT THE DIRECTION OF:
COLDWELL BANKER TLC
RT. 5 BOX 5
ELKHORN, WI. 53121

ORDERED BY: COLDWELL BANKER TLC
RT. 5 BOX 5
ELKHORN, WI. 53121

PLAT OF SURVEY OF

LOT 3, CERTIFIED SURVEY NO. 459, LOCATED IN THE SOUTHWEST 1/4 OF SECTION 36, T4N, R16E, WALWORTH COUNTY, WISCONSIN.

ABELL
SURVEYING & MAPPING
DELAVAN, WISCONSIN 53115
414-728-6737

LOT 2

NOTE 1: BEARINGS ARE REFERENCED TO CERTIFIED SURVEY NO. 459.

N

SCALE 1"=50'

LEGEND

- ⌀ -IRON PIPE FOUND
- ⊗ -PK NAIL SET
- ( )-RECORDED AS

I, DAVID F. ABELL, DO HEREBY CERTIFY THAT I HAVE SURVEYED THE PROPERTY HEREON DESCRIBED ACCORDING TO THE OFFICAL RECORDS AND THAT THE PLAT HEREON IS A CORRECT REPRESENTATION OF THE PROPERTY LINES TO THE BEST OF MY KNOWLEDGE AND BELIEF.

David F. Abell

DAVID F. ABELL
WISCONSIN REGISTERED LAND SURVEYOR, S-1596

October 2, 1996

DATE JOB NUMBER - 96179
NOTE: THIS IS NOT A CERTIFIED COPY UNLESS SEALED.

HA-459-3

416-1252