
PLAT OF SURVEY

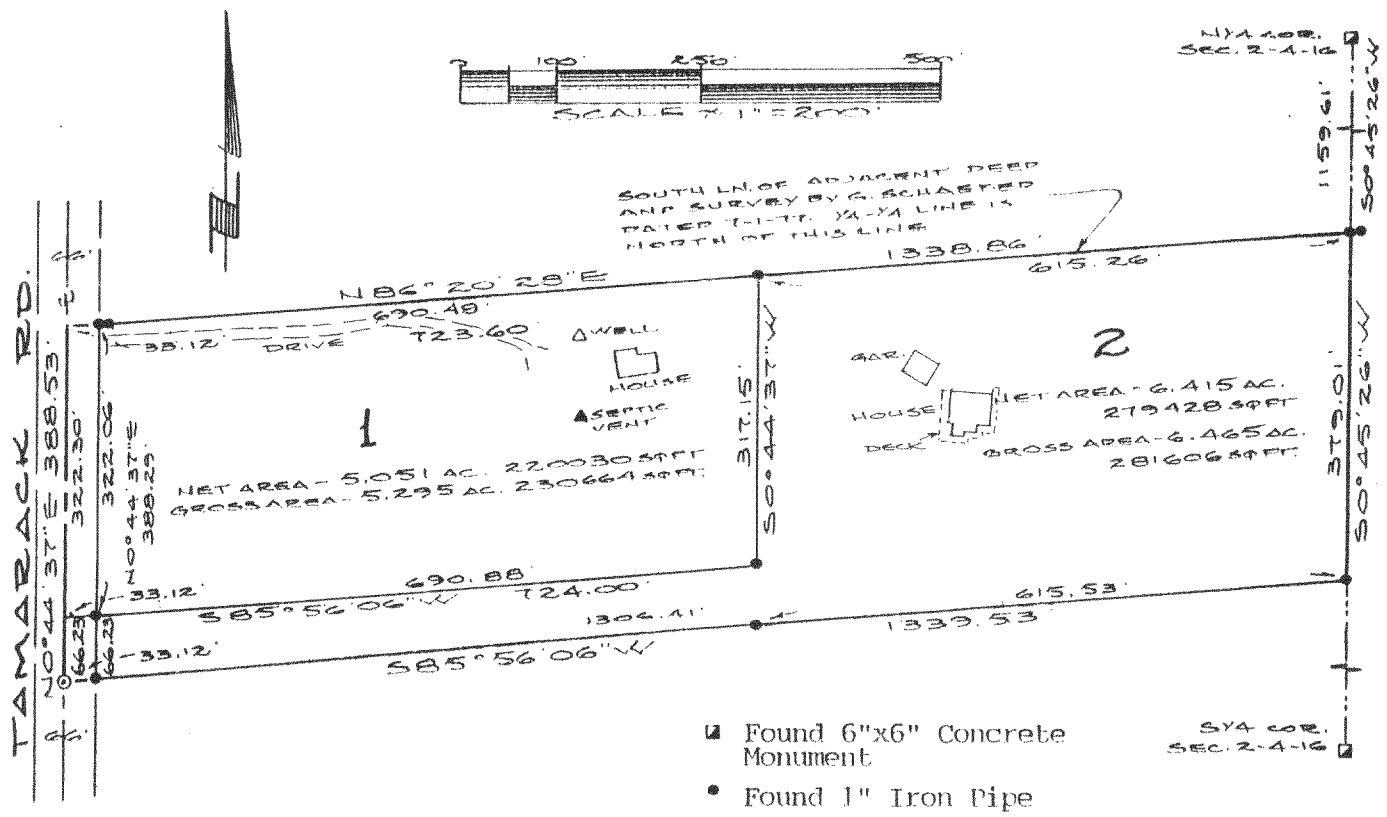

■ Found 6"x6" Concrete Monument

• Found 1" Iron Pipe

⊙ Found Railroad Spike

DESCRIPTION

Lots 1 and 2, Certified Survey Map #2306 recorded in Volume 11 Certified Surveys of Walworth County at pages 160 and 161 in the SE¼ of the NW¼ of Section 2, T4N, R16E, Town of LaGrange, Walworth County, Wisconsin.

CERTIFICATION

I hereby certify that the property described above has been surveyed under my responsible direction and supervision and that this map is an accurate representation of the lot lines and dimensions and the principle lines of the permanent structures thereon.

Date 4-16-96

James B. Woodman
Registered Land Surveyor, S-1239

WISCONSIN JAMES B. WOODMAN S-1239 FORT ATKINSON, WIS. LAND SURVEYOR

RECEIVED MAY 28 1996

OWNER: Randy McDonald
N9596 Tamarack Road
Eagle, WI 53119

HA-2306-1
HA-2306-2

Sheet 1 of 1 JN 92S-32 416-1256

WOODMAN & ASSOCIATES
210 Madison Avenue, Fort Atkinson, WI 53538

Registered Land Surveyors
Phone (414) 563-8162