
ABELL
SURVEYING & MAPPING

1140 SEQUOIA STREET • DELAVAN, WISCONSIN 53115
414-728-6737

RECEIVED
SEP 17 1997

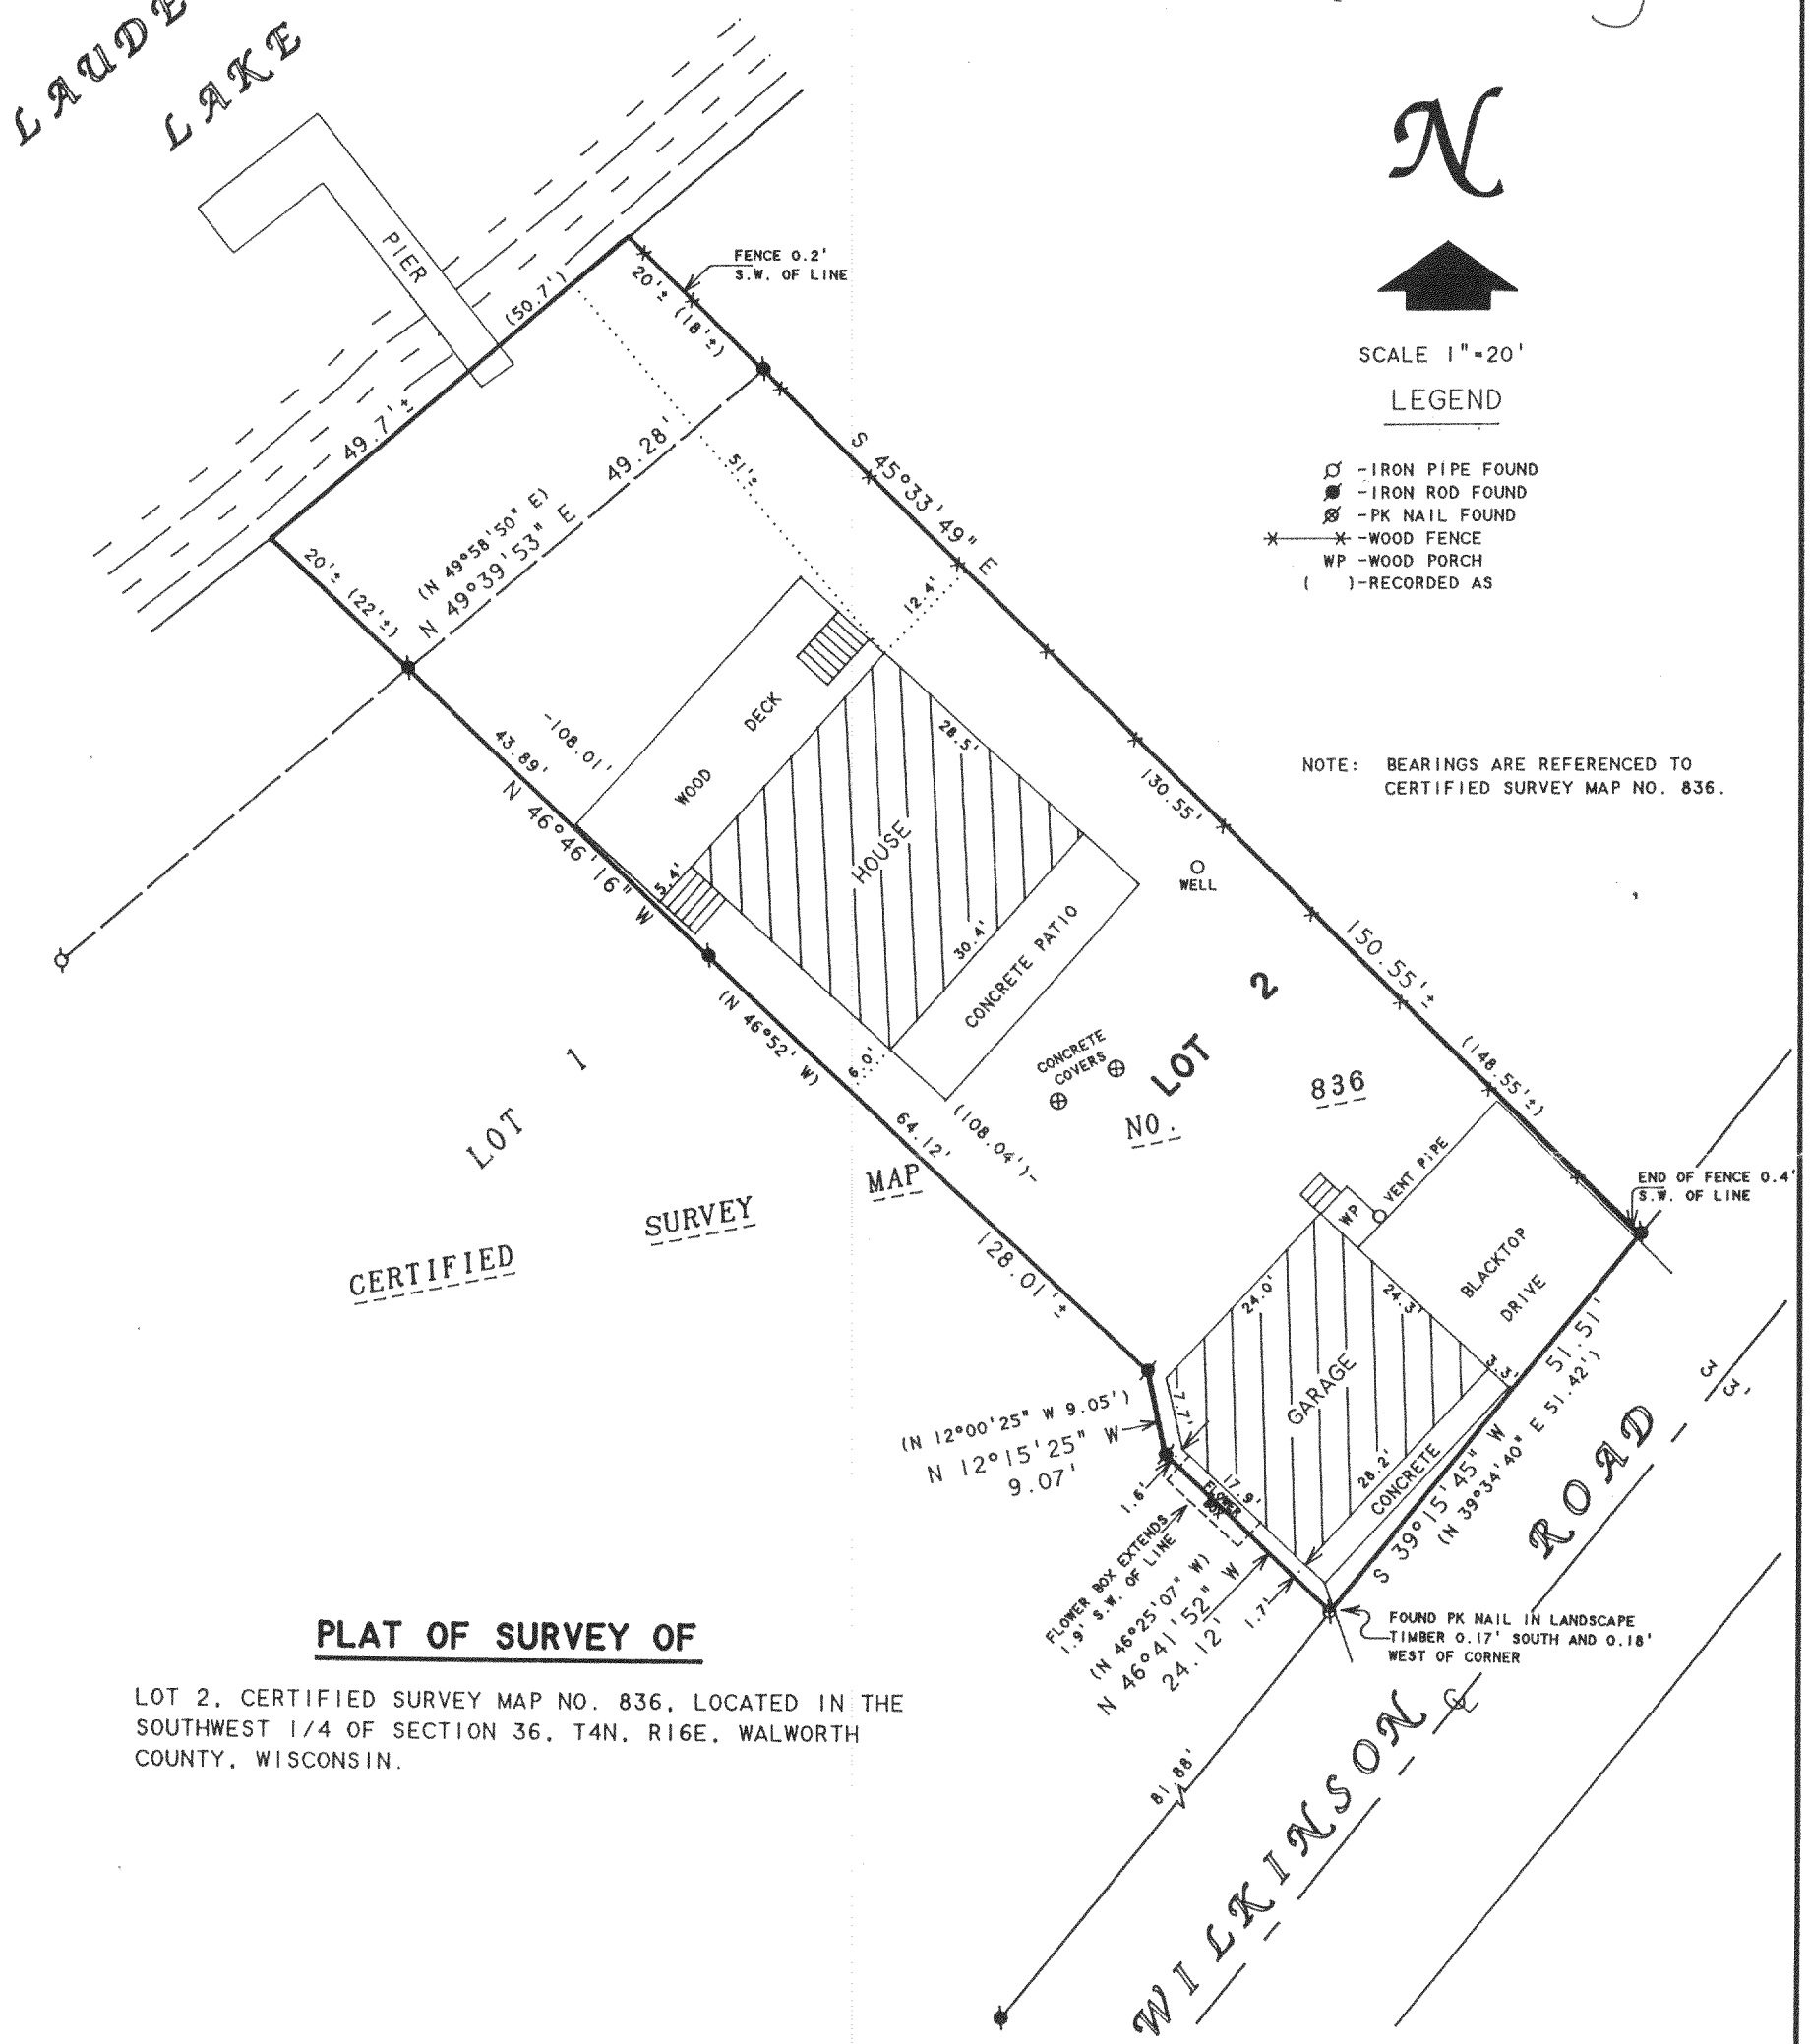

N

SCALE 1"=20'

LEGEND

- -IRON PIPE FOUND
- -IRON ROD FOUND
- -PK NAIL FOUND
- -WOOD FENCE
- WP -WOOD PORCH
- ( )-RECORDED AS

NOTE: BEARINGS ARE REFERENCED TO CERTIFIED SURVEY MAP NO. 836.

PLAT OF SURVEY OF

LOT 2, CERTIFIED SURVEY MAP NO. 836, LOCATED IN THE SOUTHWEST 1/4 OF SECTION 36, T4N, R16E, WALWORTH COUNTY, WISCONSIN.

ORDERED BY: COLDWELL BANKER, TLC
5 WEST WALWORTH STREET
ELKHORN, WI 53121

I HEREBY CERTIFY THAT I HAVE SURVEYED THE ABOVE DESCRIBED PROPERTY AND THAT THE ABOVE MAP IS A TRUE REPRESENTATION THEREOF AND SHOWS THE SIZE AND LOCATION OF THE PROPERTY, ITS EXTERIOR BOUNDARIES, THE LOCATION OF ALL VISIBLE STRUCTURES AND DIMENSIONS OF ALL PRINCIPAL BUILDINGS THEREON, BOUNDARY FENCES, APPARENT EASEMENTS, ROADWAYS AND VISIBLE ENCROACHMENTS, IF ANY, TO THE BEST OF MY KNOWLEDGE AND BELIEF.

THIS SURVEY IS MADE FOR THE USE OF THE PRESENT OWNERS OF THE PROPERTY, AND ALSO THOSE WHO PURCHASE, MORTGAGE, OR GUARANTEE THE TITLE THERETO WITHIN ONE (1) YEAR FROM DATE HEREON.

David F. Abell

DAVID F. ABELL
WISCONSIN REGISTERED LAND SURVEYOR, S-1596

May 20, 1997

DATE JOB NUMBER - 97087

NOTE: THIS IS NOT A CERTIFIED COPY UNLESS SEALED.

HA-836-2
416-1312