
DESIGN PRODUCTS 087547

ABERNATHY and ASSOCIATES
Kenneth B. Abernathy Jr.
Wisconsin Registered Land Surveyor S-1594

W4056 Bray Road
Elkhorn, Wisconsin 53121
Phone: (414) 723-4260 (office)
(414) 723-7209 (fax)

PLAT OF SURVEY

LOT 7 AND THE EAST 1/2 OF LOT 8 OF MORRIS PARK SUBDIVISION, LOCATED IN SECTION 26, TOWN 4 NORTH, RANGE 16 EAST, WALWORTH COUNTY, WISCONSIN.

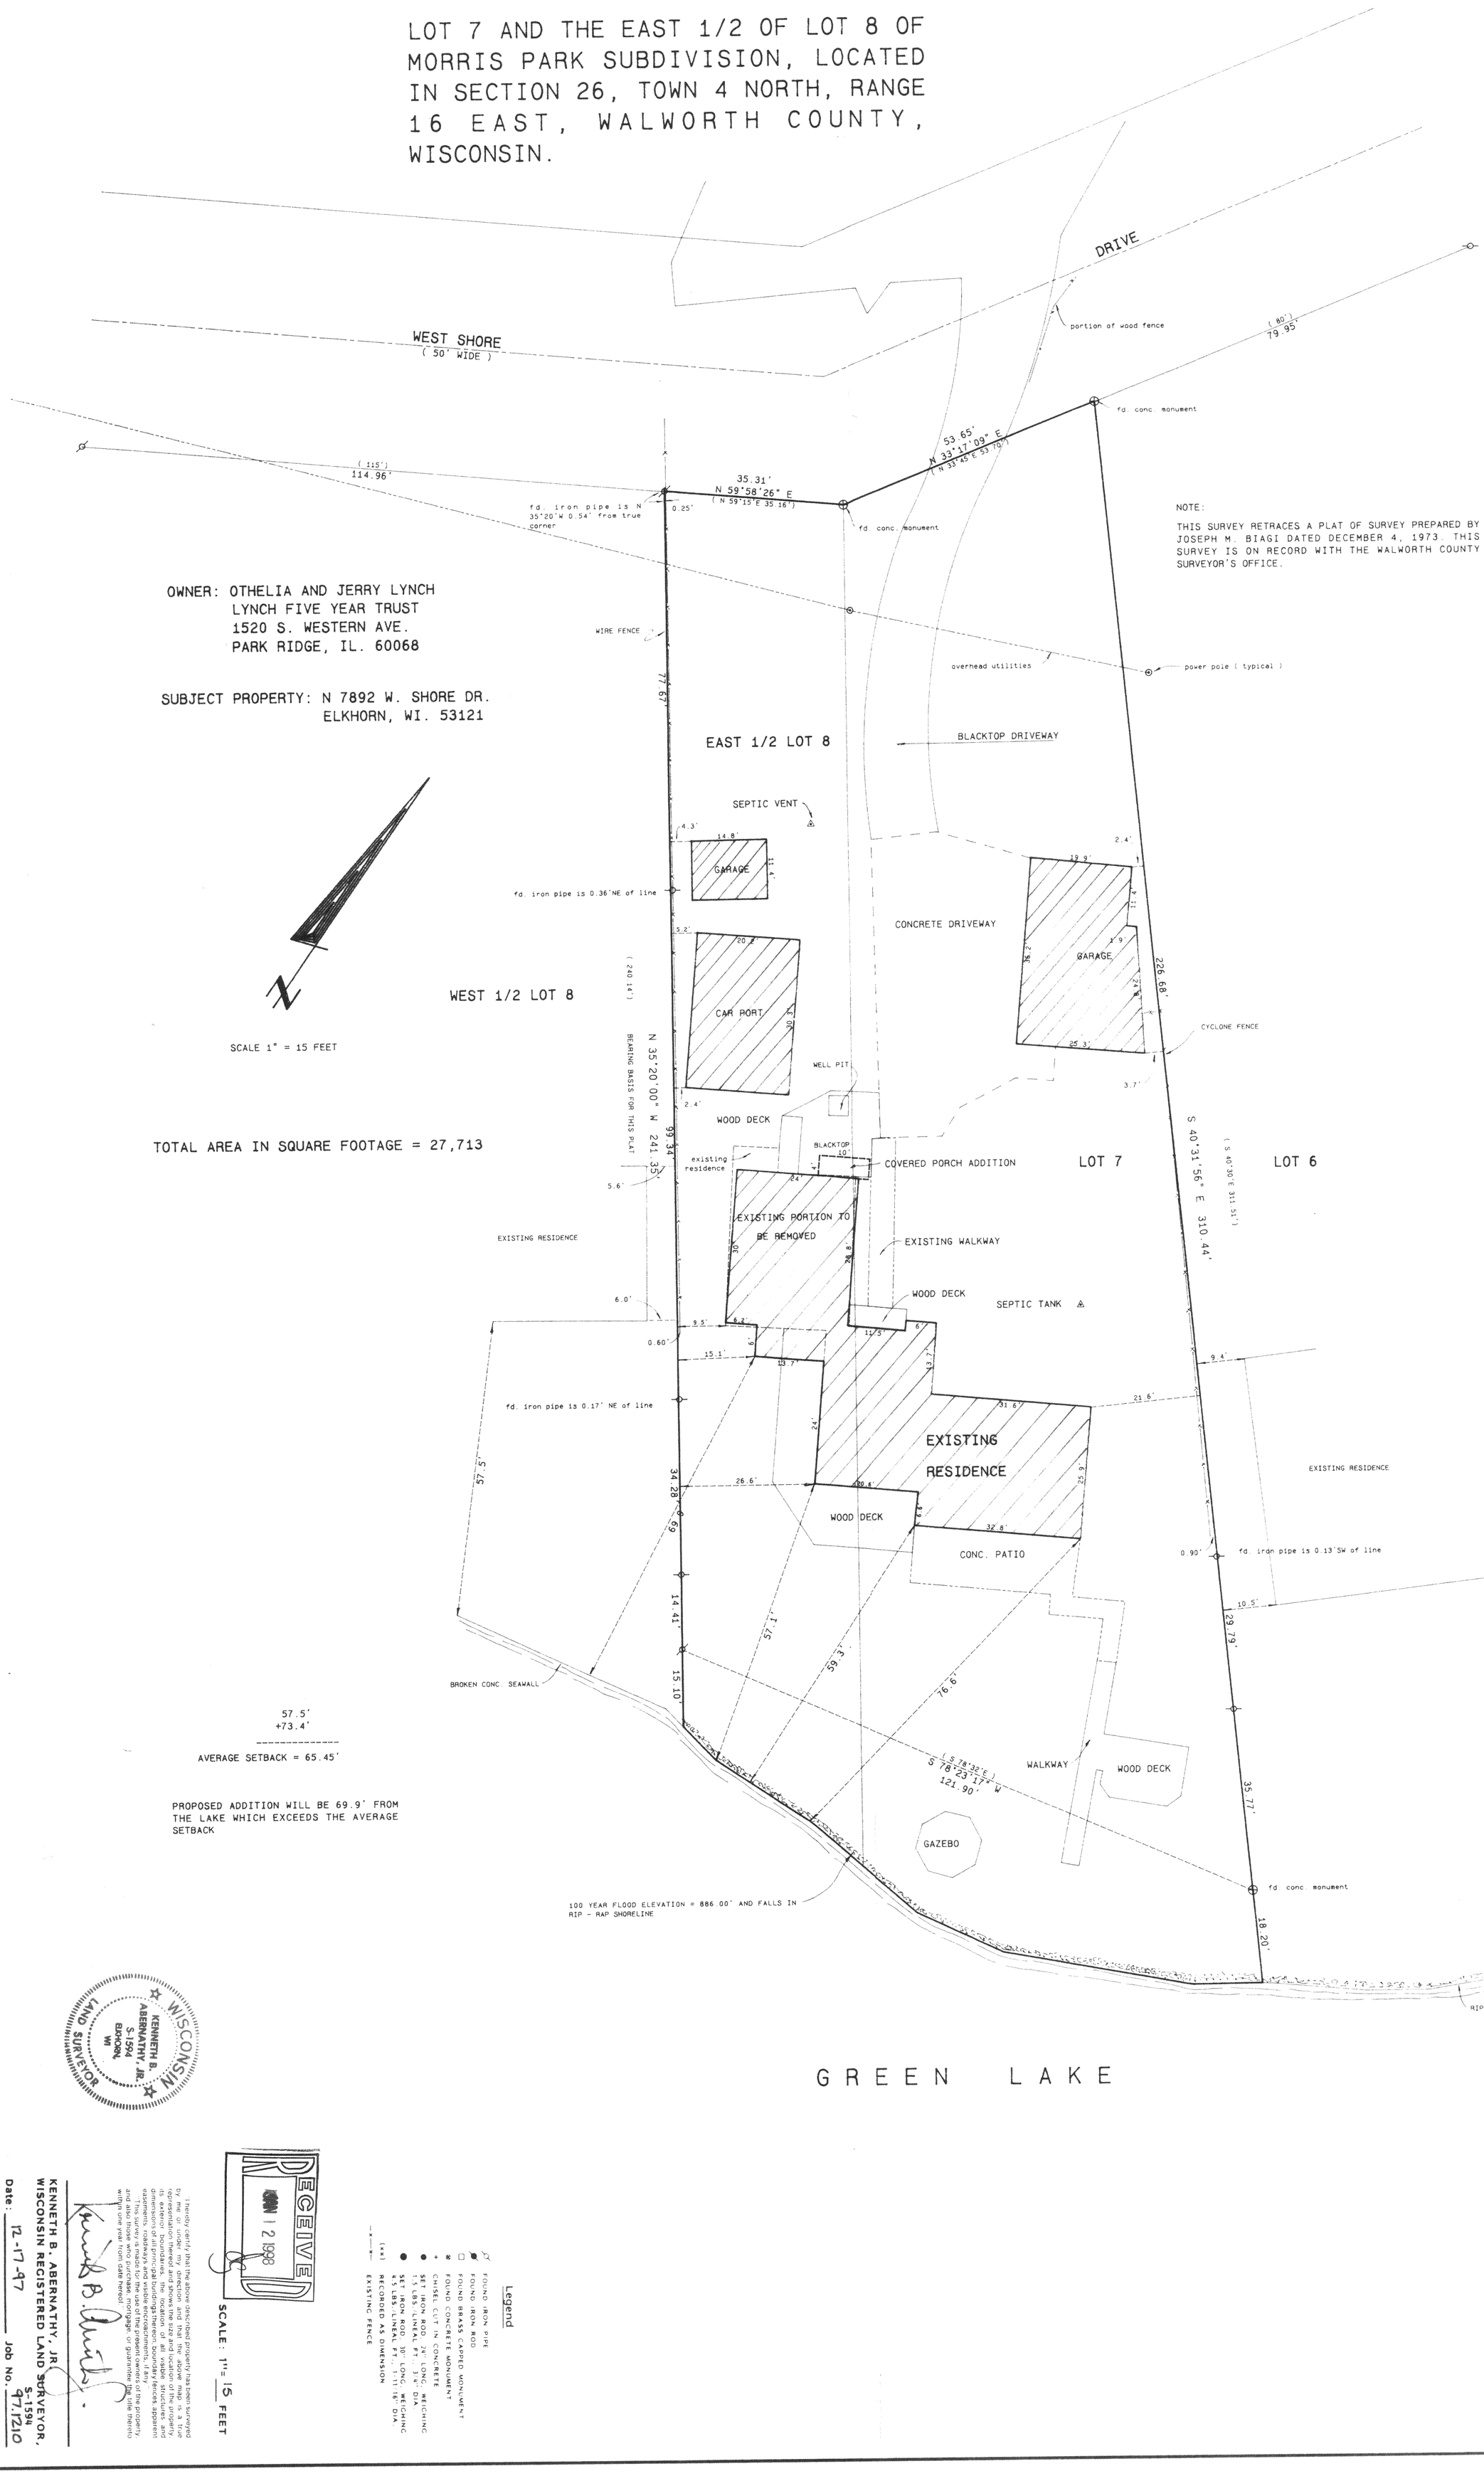

SCALE 1" = 15 FEET

TOTAL AREA IN SQUARE FOOTAGE = 27,713

57.5'
+73.4'

AVERAGE SETBACK = 65.45'

PROPOSED ADDITION WILL BE 69.9' FROM THE LAKE WHICH EXCEEDS THE AVERAGE SETBACK

KENNETH B. ABERNATHY, JR. S-1594 ELKHORN, WI

RECEIVED
DEC 12 1998

SCALE: 1"= 15 FEET

I hereby certify that the above described property has been surveyed by me or under my direction and that the above map is a true representation thereof and shows the size and location of the property, its exterior boundaries, the location of all visible structures, and dimensions of all principal buildings thereon, boundary fences apparent easements, roadways and visible encroachments, if any.
This survey is made for the use of the present owners of the property and also those persons or parties acquiring mortgage or guarantee title thereto within one year from date hereof.

KENNETH B. ABERNATHY, JR.
WISCONSIN REGISTERED LAND SURVEYOR, S-1594
Date: 12-17-97 Job No. 97.1210

Legend

- FOUND IRON PIPE
- FOUND IRON ROD
- FOUND BRASS CAPPED MONUMENT
- FOUND CONCRETE MONUMENT
- CHISEL CUT IN CONCRETE
- SET IRON ROD, 24" LONG, WEIGHING 1.5 LBS./LINEAL FT., 3/4" DIA.
- SET IRON ROD, 30" LONG, WEIGHING 4.5 LBS./LINEAL FT., 1-11/16" DIA.
- [xx] RECORDED AS DIMENSION
- -x-x- EXISTING FENCE

HMP-4B 416-1342