

PATHFINDER SURVEYING
FORMERLY KOLB LAND CONSULTING
929 WILLIAMS STREET LAKE GENEVA, WI. 53147
(414) 870-1894

DATE: 2/ 17 / 1998

SCALE 1" = 60'

LAUDERDALE LAKE

EXISTING HOUSE

DECK

ASPHALT DRIVE

RADIUS = 66.00'

N 12°46'11" W 56.56'

20.5'

125.4'

17.2'

N 77°17'20" E

(368.49' ±) 367.19'

346.66'

51.91'

N 3°25'42" E 50.58' (N 3°36'36" E 50.51')

119.97'

(120.00' N 13°15'16" W)

N 13°13'56" W

32.6'

N 13°17'22" W 59.98'

N 76°12'30" E 166.00'

(132.80) 133.41'

18.1'

N 58°07'21" E 209.75' (N 58°09'03" E 210.00')

LEGEND

⊞ SEPTIC VENT

● WELL

● FOUND 5/8" DIA. REBAR


○ FOUND 1" DIA. IRON PIPE

○ FOUND 2" DIA. IRON PIPE

(XXXX) RECORDED AS

PH PLAY HOUSE

John P Krott
JOHN P. KROTT, R.L.S. 2258

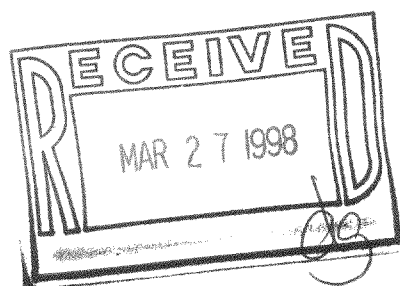

NOTE: THIS IS NOT A CERTIFIED COPY
UNLESS SEAL IS IN RED.

JOB NUMBER 4-16-00049 98013

HPE-49
416-1354