
PLAT OF SURVEY

PATHFINDER SURVEYING
FORMERLY KOLB LAND CONSULTING
929 WILLIAMS STREET LAKE GENEVA, WI. 53147
(414) 248-3697

DATE: 7-13-1999

ORDERED BY: CENTURY 21 ZENK REALTY LLC
804 N WISCONSIN
ELKHORN, WI. 53121

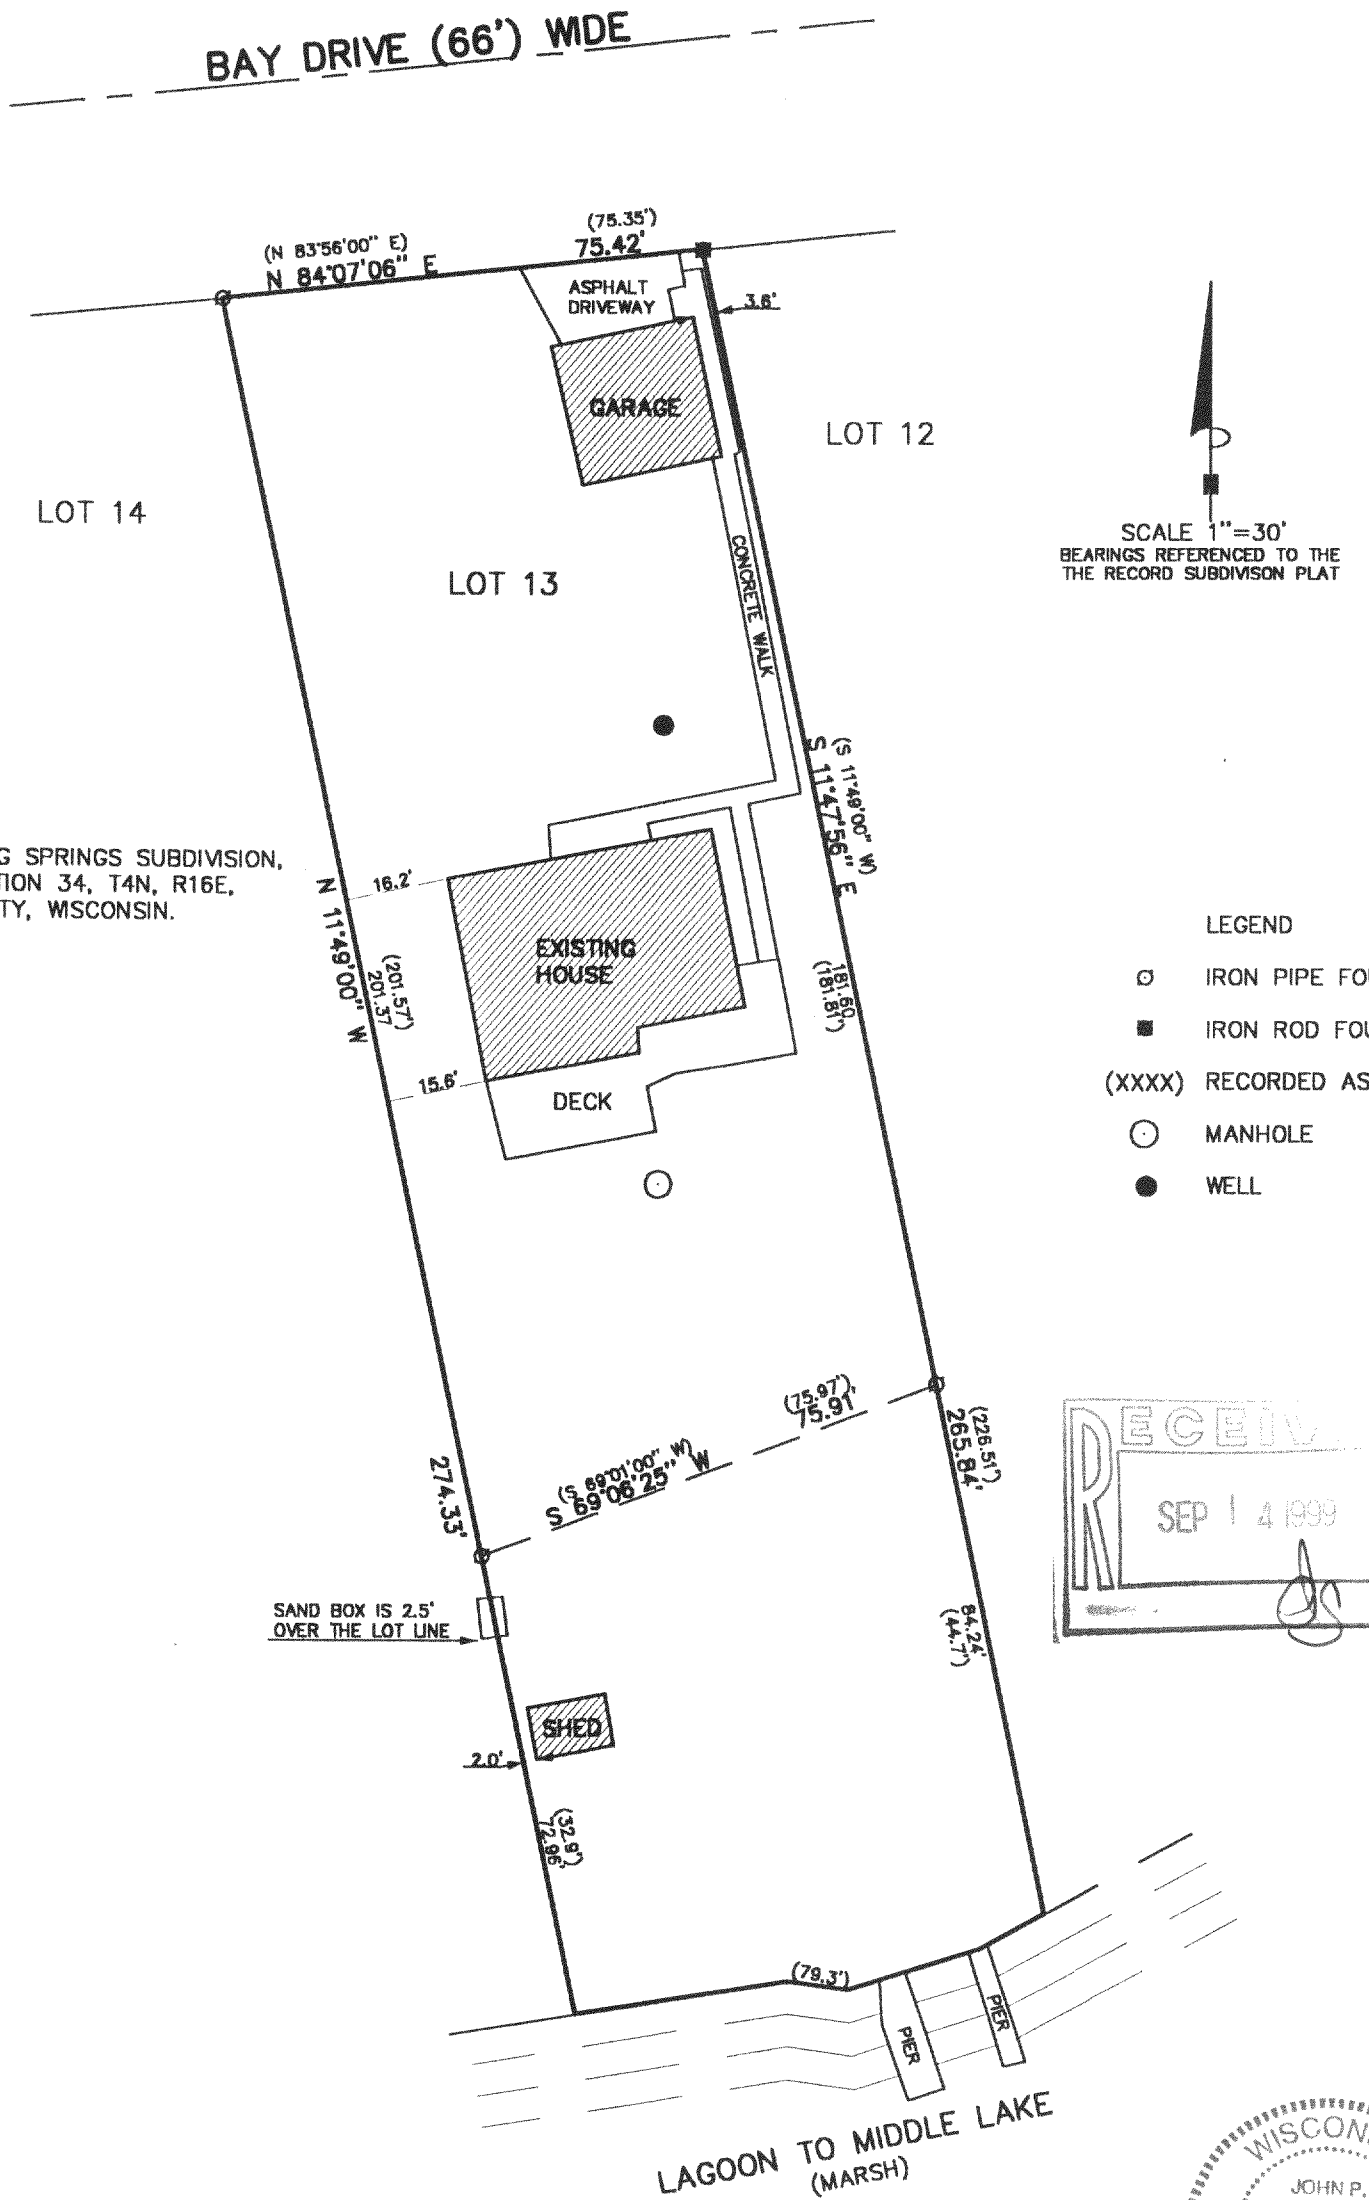

SCALE 1"=30'
BEARINGS REFERENCED TO THE THE RECORD SUBDIVISON PLAT

LEGEND

ø	IRON PIPE FOUND
■	IRON ROD FOUND
(XXXX)	RECORDED AS
⊙	MANHOLE
●	WELL

DESCRIPTION:

LOT 13, BUBBLING SPRINGS SUBDIVISION, LOCATED IN SECTION 34, T4N, R16E, WALWORTH COUNTY, WISCONSIN.

RECEIVED
SEP 14 1999

THE ABOVE MAP IS A TRUE REPRESENTATION THEREOF AND SHOWS THE SIZE AND LOCATION OF ALL THE PROPERTY, EXTERIOR BOUNDARIES, THE LOCATION OF ALL VISIBLE BOUNDARY FENCES, APPARENT EASEMENTS, ROADWAYS AND VISIBLE ENCROACHMENTS, IF ANY

THIS SURVEY IS MADE FOR THE USE OF THE PRESENT OWNERS OF THE PROPERTY, AND ALSO THOSE WHO PURCHASE, MORTGAGE OR GURANTEE TITLE THERETO WITHIN ONE (1) YEAR FROM DATE HERETO.

John P Krott

JOHN P. KROTT, R.L.S. 2258

WISCONSIN
JOHN P. KROTT
S-2258
MUKWONAGO, WIS.
LAND SURVEYOR

NOTE: THIS IS NOT A CERTIFIED COPY UNLESS SEAL IS IN RED.

JOB NUMBER #99144 4-16 HBS00013

HBS-13
416-1489