
61-*13

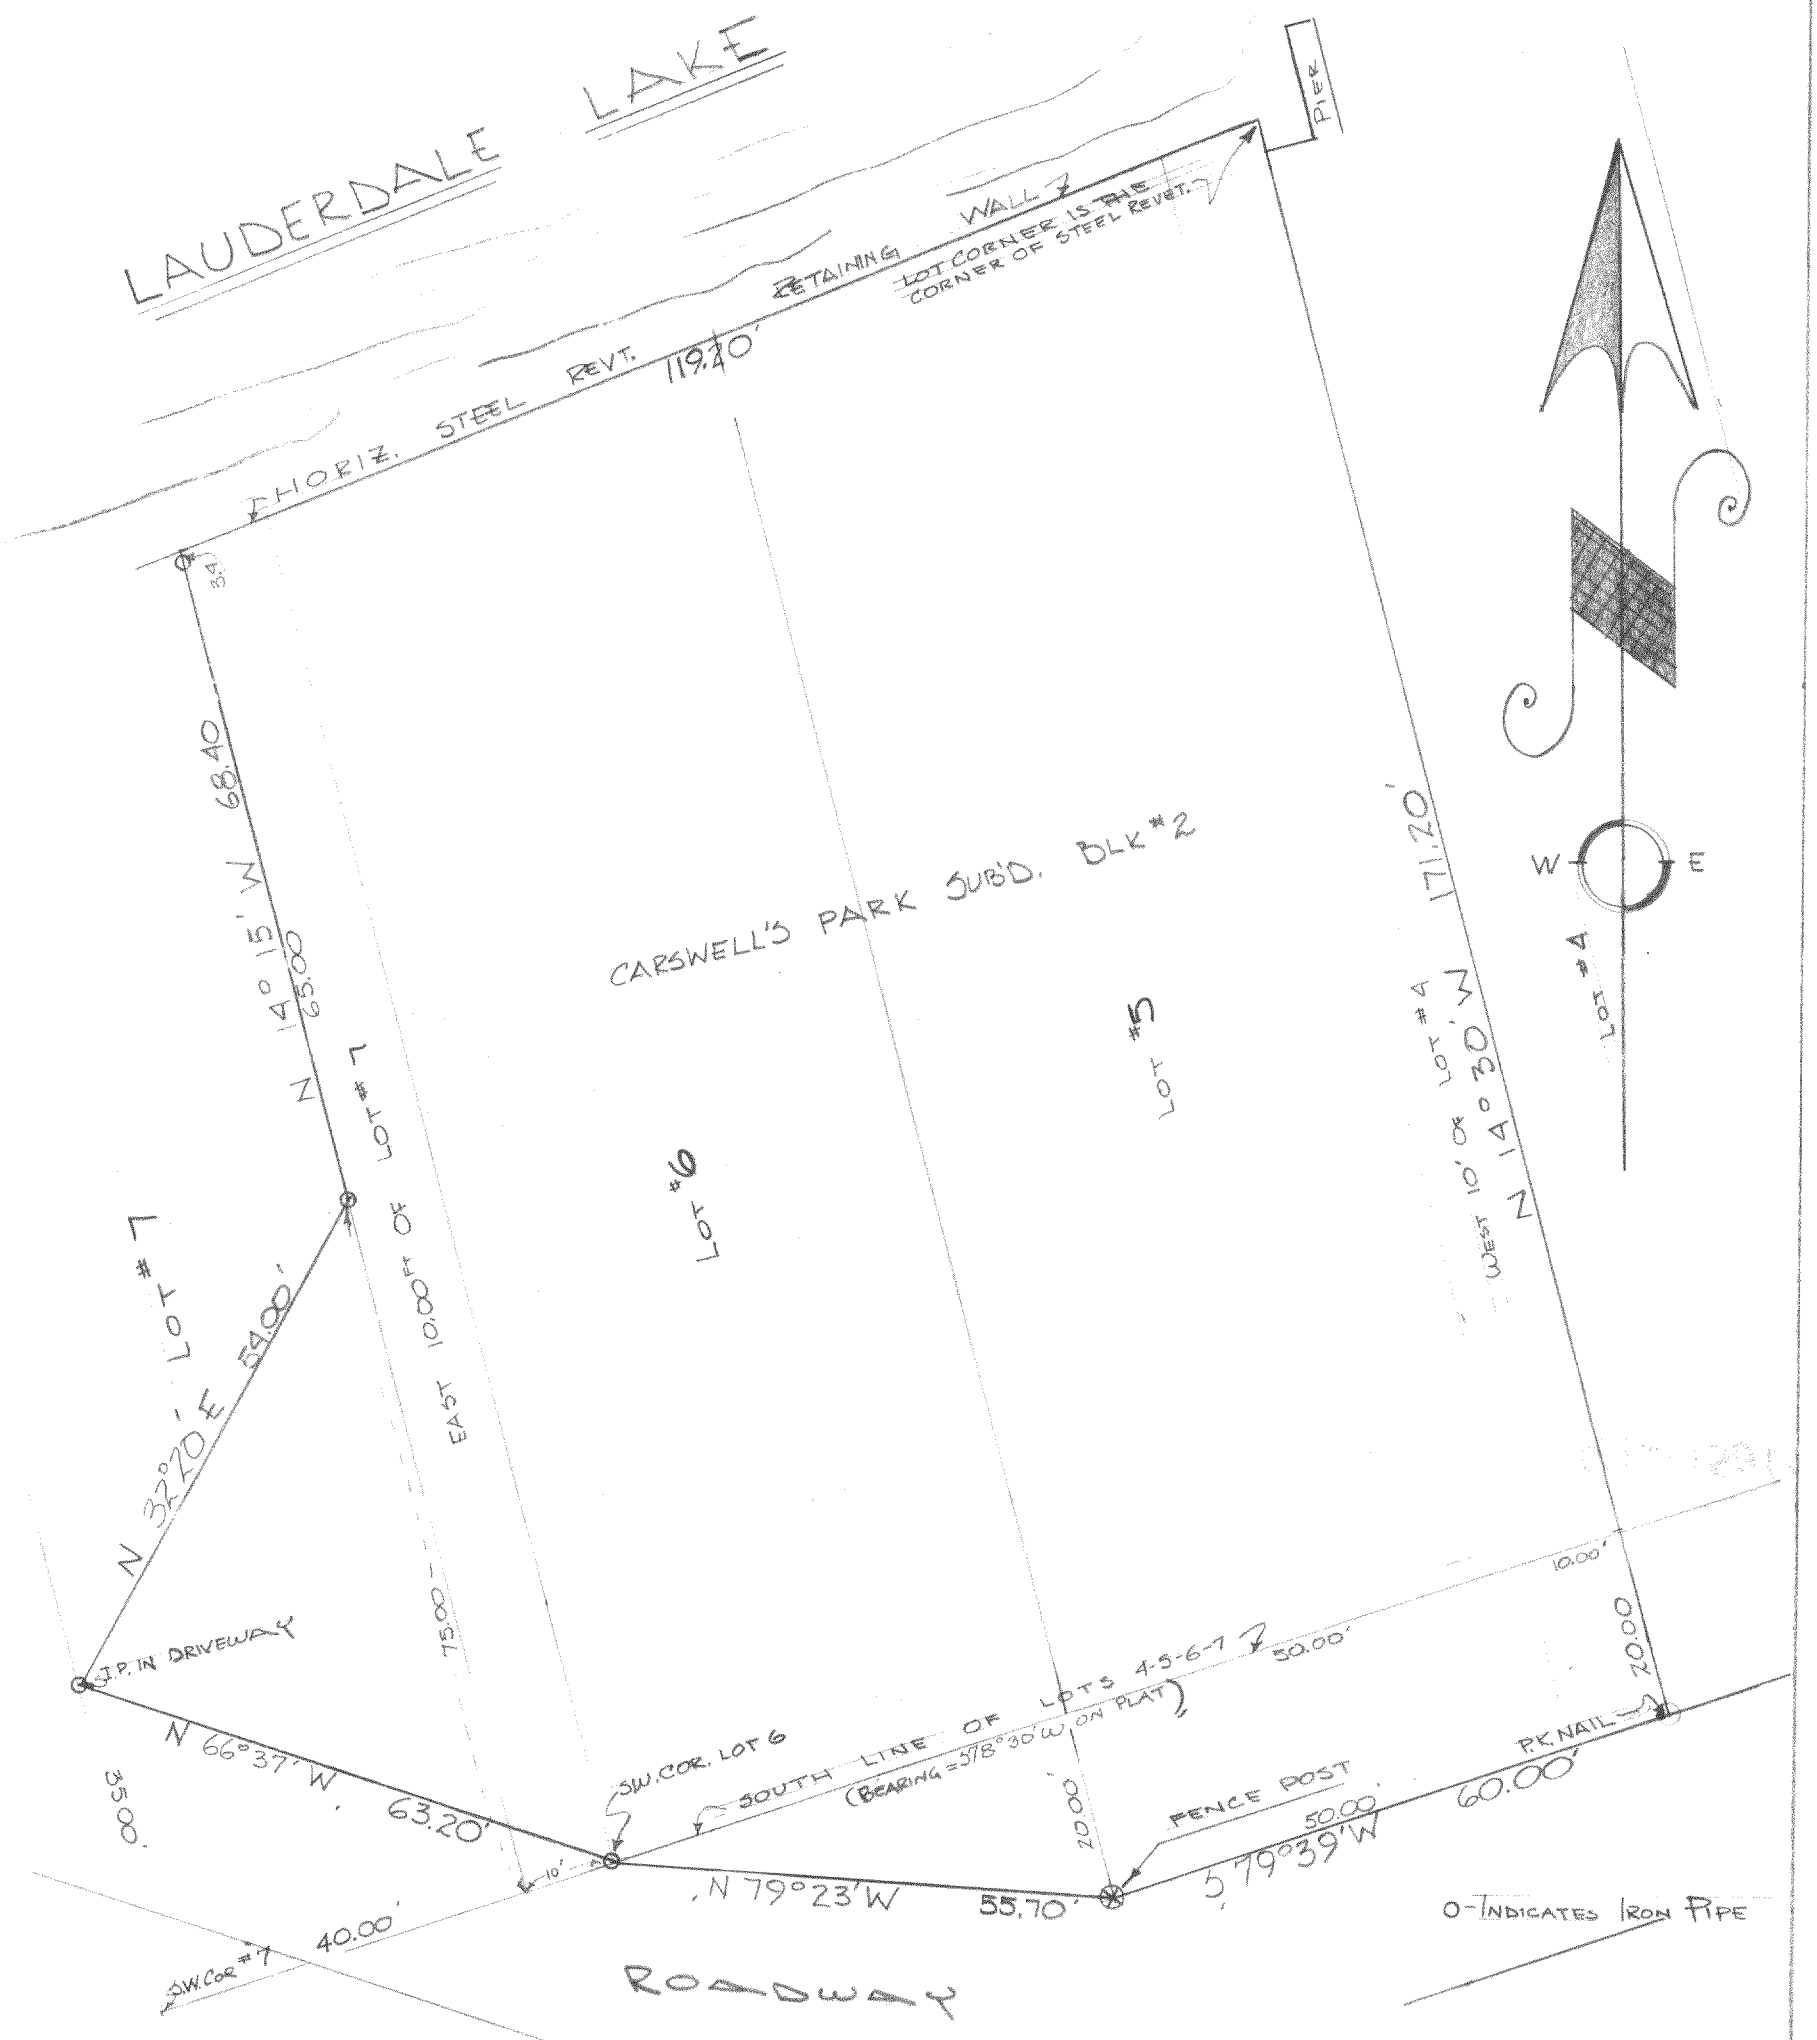

DESCRIPTION: The westerly 10.00 feet of lot #4, all of lots 5 and 6 in Block 2 of Carswell's Park, located in Section 35, T. 4 N., R. 16 E., Walworth County, Wisconsin. Also commencing at the Southeasterly corner of Lot 7 of said subdivision, thence N.W.'ly to a point in the Westerly line of lot 7, 35 feet northerly of the SWly corner of lot 7; thence NEly to a point 75.00 feet northerly of the south line of Lot 7 and 10.00 feet west of the easterly line of lot 7; thence northerly parallel to the easterly line of lot 7, 68.30 feet to the southerly shore line of Middle Lake at the low water mark; thence easterly along said low water line to the northeasterly corner of lot 7; thence southerly along the easterly line of lot 7, 145 feet more of less to the place of beginning. Also commencing at a point in the southerly line of lot 4 of said subdivision, that is 10.00 feet easterly from the southwesterly corner of lot 4; thence S 14° 30' E 20.00 feet; thence westerly parallel with the southerly line of block #2 to a point S 14° 15' E 20.00 feet from the SEly corner of lot 6; thence westerly to the SWly corner of lot 6; thence easterly to the place of beginning.

CERTIFICATE: I, James F. Biagi, surveyor, do hereby certify that I have surveyed the property hereon described on this 23rd day of August, 1961.

WISCONSIN
JAMES F.
BIAGI
MILWAUKEE,
WIS.
LAND SURVEYOR

James F. Biagi

James F. Biagi RLS 272

CA-22A

61-130B