
#101-63

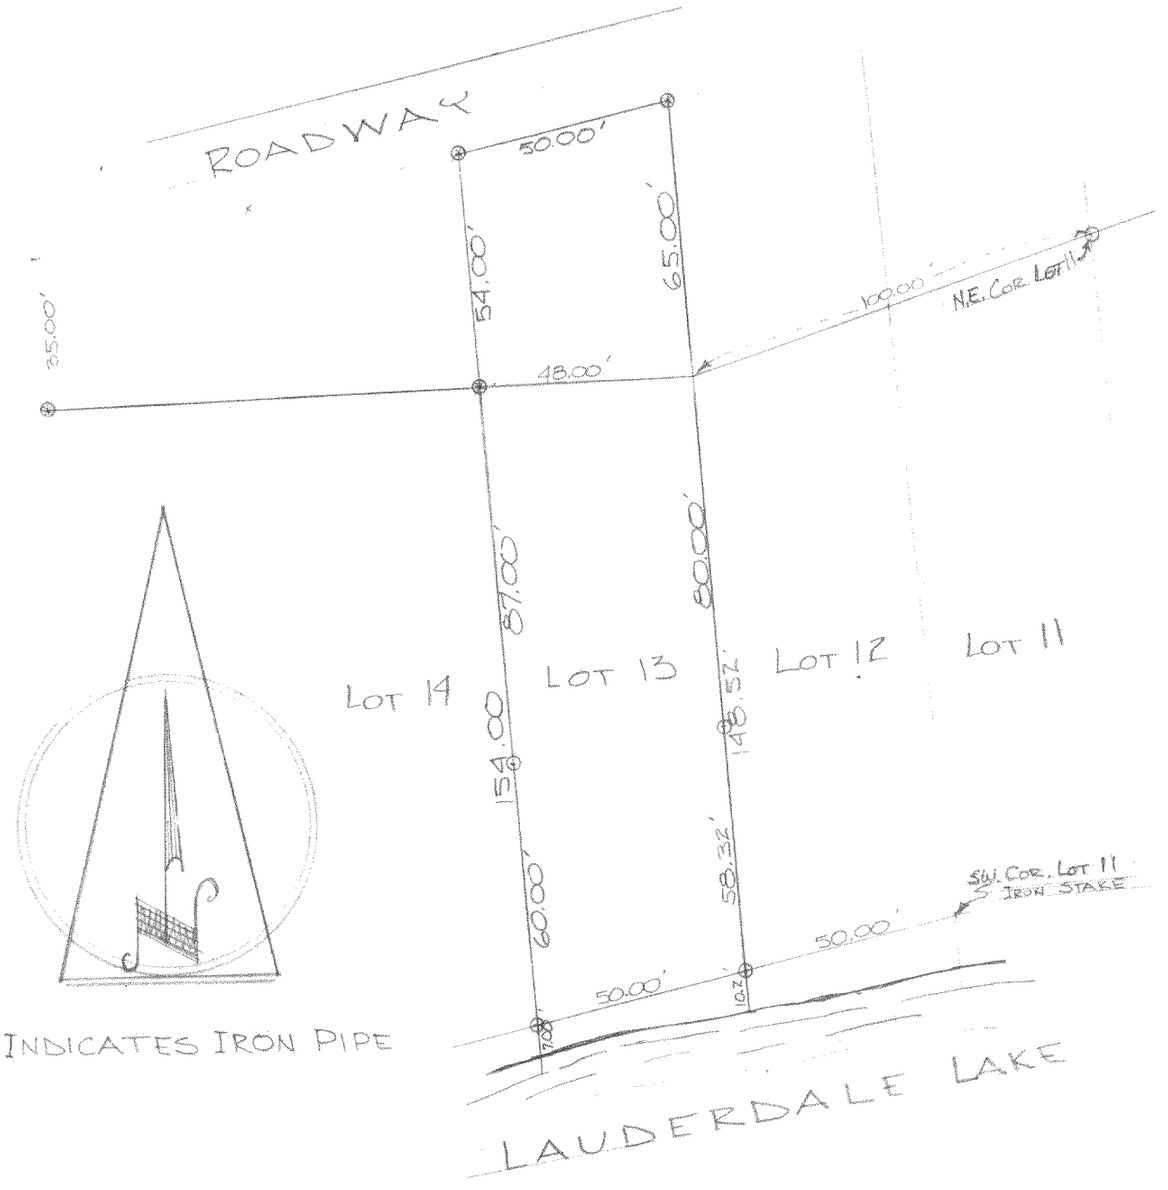

o-INDICATES IRON PIPE

DESCRIPTION: Lot 13 of Block 3 in Carswell's Park Subdivision in Section 35, T. 4 N., R. 16 E. Walworth County, Wisconsin. Also Commencing at the NW corner of said lot 13, thence N'ly 54.00 feet on the extension of the west line of said lot, thence E'ly 50.00 feet, thence S'ly to the NE corner of said lot 13, thence W'ly along the north line of said lot to the place of beginning.

WISCONSIN
JAMES F. BIAGI
MILWAUKEE, WIS.
LAND SURVEYOR

CERTIFICATE: I, James F. Biagi, surveyor, do hereby certify that I have surveyed the property hereon described.

August 26, 1963.

James F. Biagi

James F. Biagi RLS 272

HCA-34A

4116-151B