
#119-68

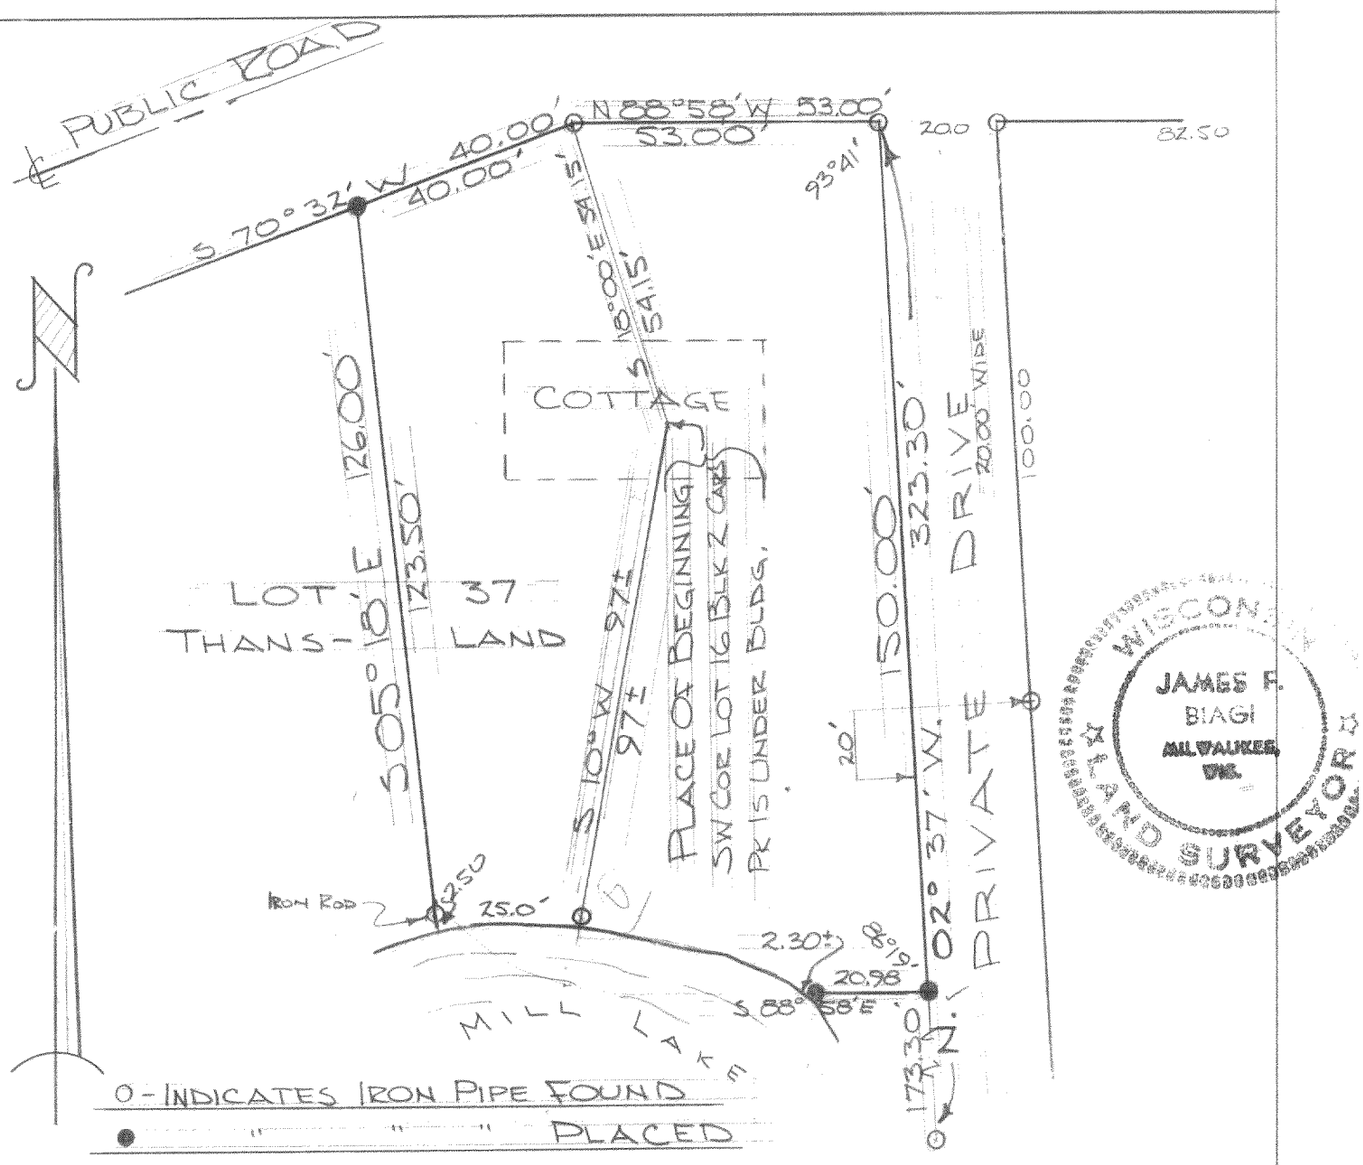

DESCRIPTION: The North 150.00 feet of the following parcel: Beginning at the SW corner of Lot 16 Block 2 of Carswells Park Subdivision located in Sections 35 and 36 of T.4 N., R. 16 E.; thence S. 10° W. 97 feet more or less to the shore of Mill Lake, thence S'ly along said shore 100 feet more or less to the NW'ly corner of A.G.Olsen lands, thence S. 39° 08' E 126 feet more or less to an iron pipe located on the west line of a private drive, thence N. 02° 37' W. along the W. line of said Drive 323.30 feet to an iron pipe, thence W'ly 53 feet more or less to an iron pipe on the W'ly line of said Lot 16, thence S. 18° E. along said Lot line 54.15 feet to the place of beginning. Also a strip of land off of the East side of Lot 37 in Block 1 of Thansland, said strip to be 25 ft. in width on the lake (from east lot line) and running to a point on the existing Road 40 feet from the east line of Lot 37.

CERTIFICATE: I, James F. Biagi, surveyor, do hereby certify that I have surveyed the property hereon described.

Sept. 26, 1968.

James F. Biagi

James F. Biagi, RLS 272

TL-12A1
UCA-55B

41/6-152B