FARRIS, HANSEN, & ASSOCIATES, INC.

ENGINEERING, ARCHITECTURE, SURVEYING

7 RIDGWAY COURT – P.O. BOX 437, ELKHORN, WISCONSIN, 53121

PHONE: (414) 723–2098 FAX: (414) 723–5886


PLAT OF SURVEY


LOTS 15 & 16 OF THANSLAND SUBDIVISION

LOCATED IN PART OF SECTION 35
TOWN 4 NORTH, RANGE 16 EAST,
WALWORTH COUNTY, WISCONSIN

– WORK ORDERED BY –
CENTURY 21 ZENK REALTY
804 NORTH WISCONSIN STREET
ELKHORN, WI. 53121

● = FOUND IRON REBAR STAKE
○ = FOUND IRON PIPE STAKE
(XXX) = RECORDED AS

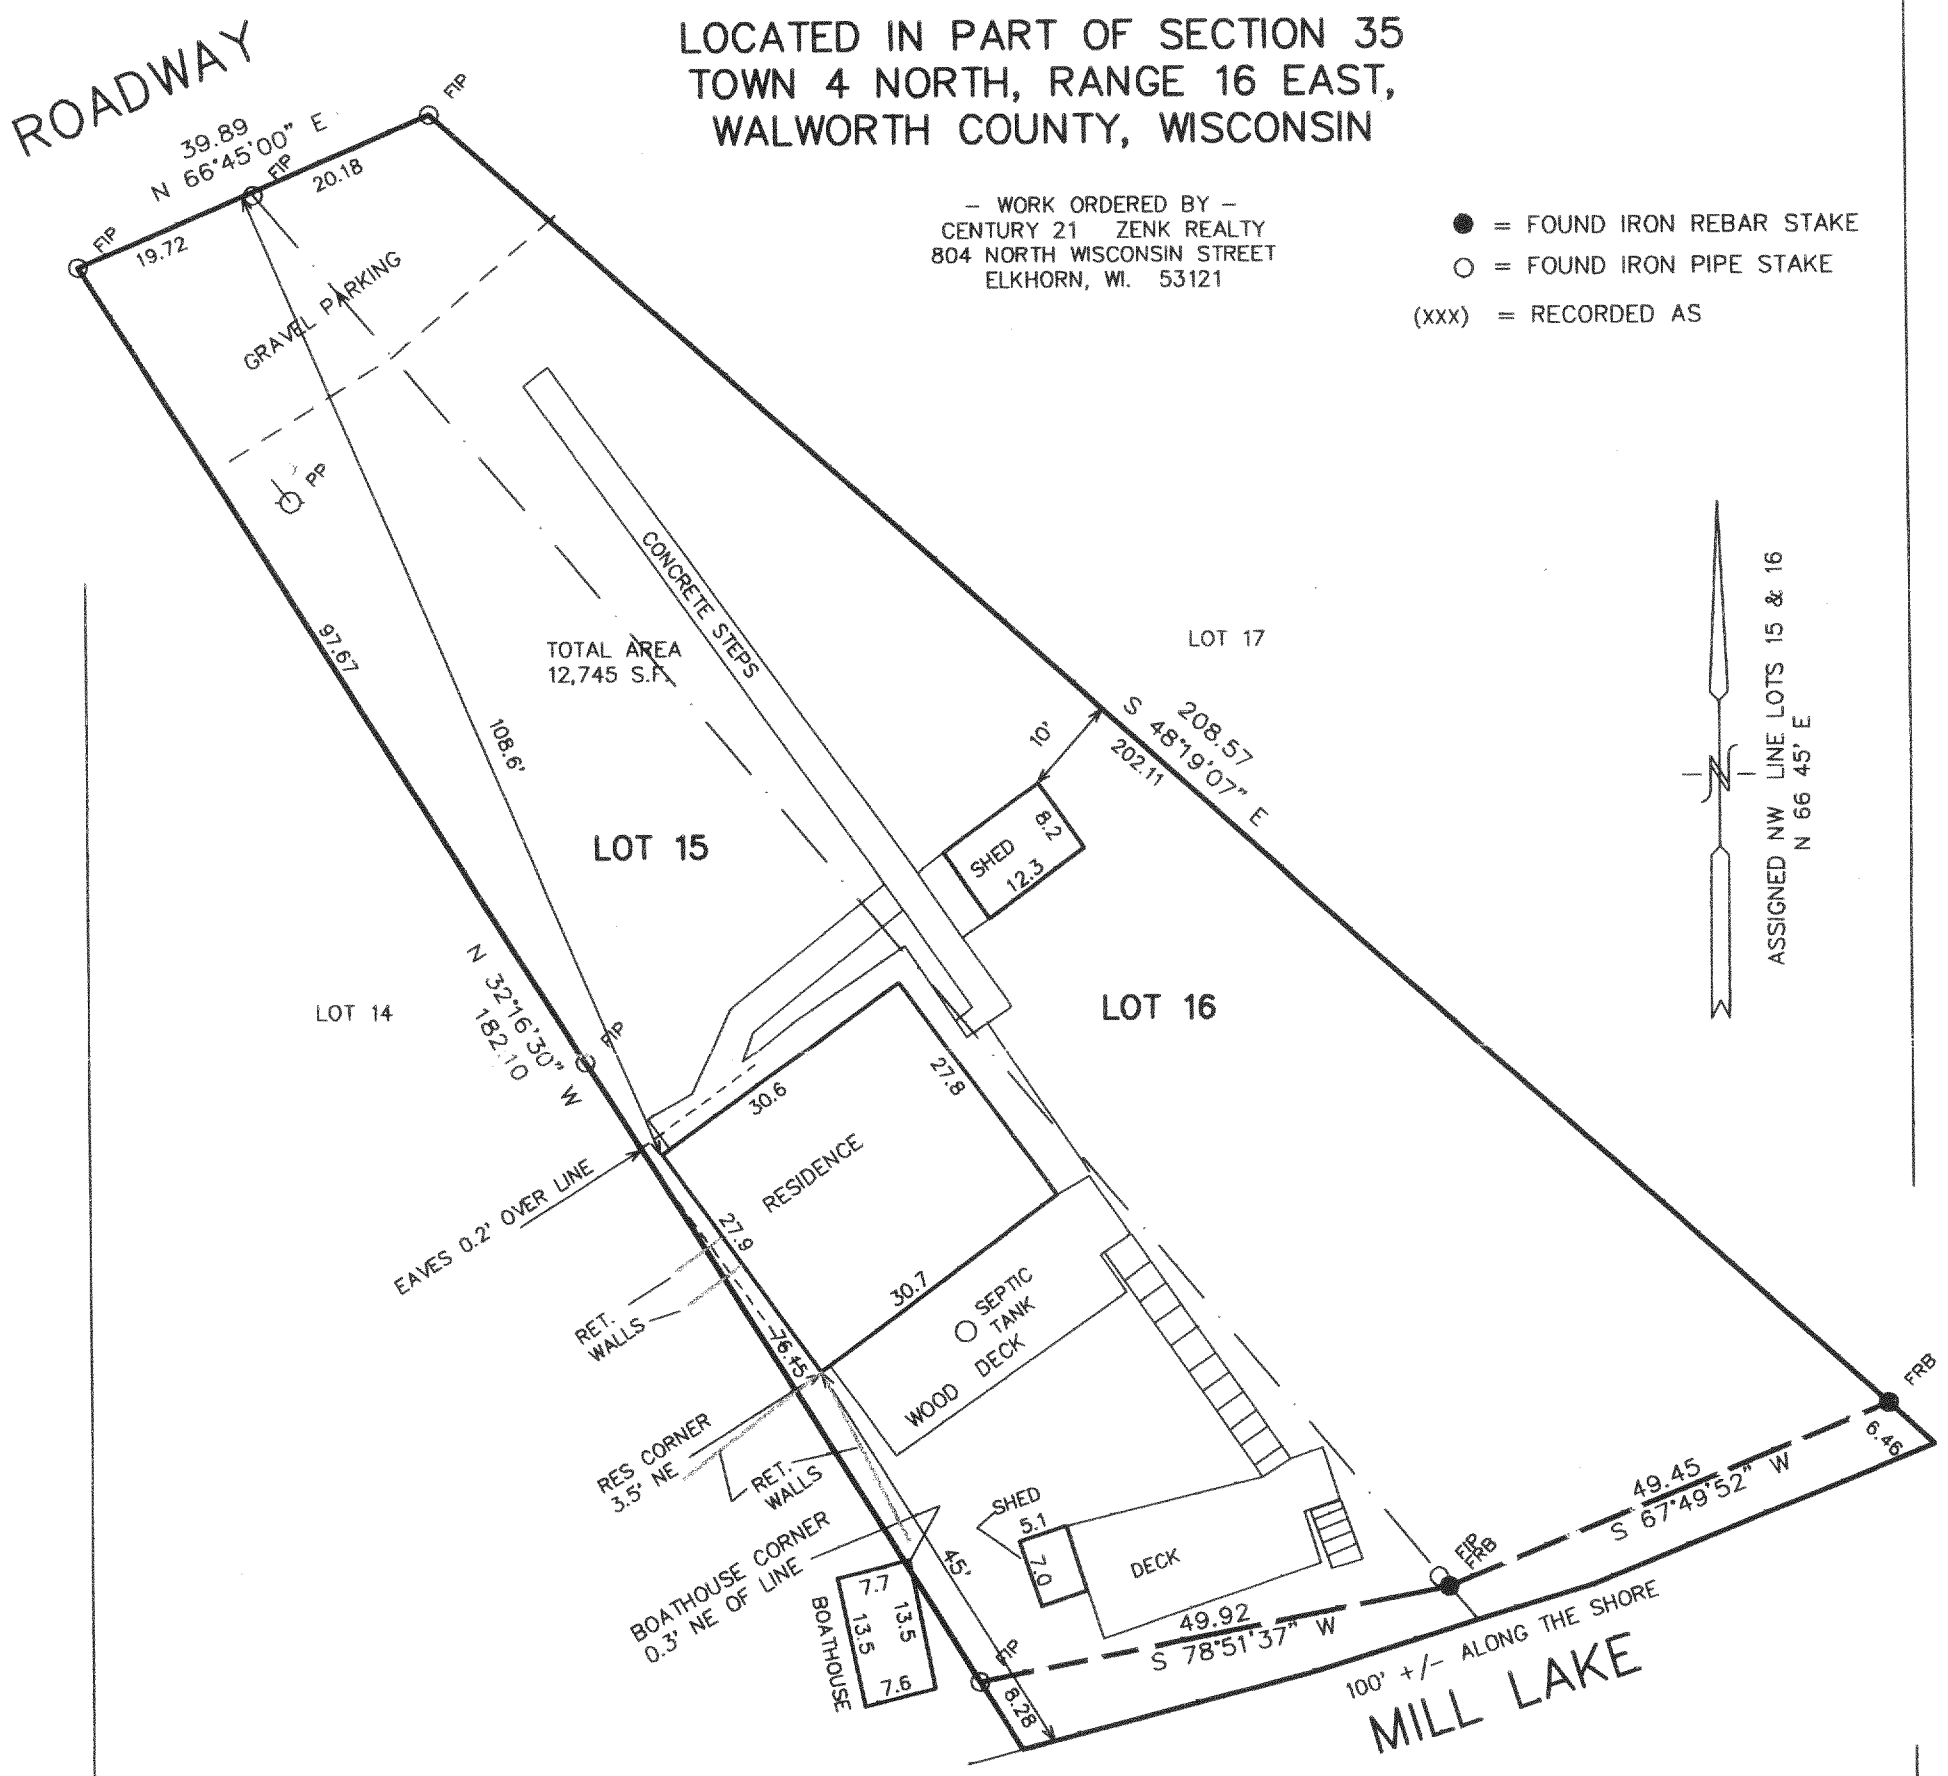

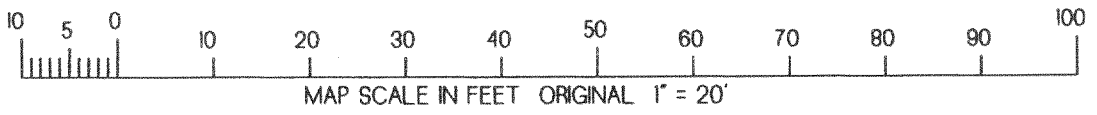

NOTE: COPIES OF THIS MAP TO WHICH THE FOLLOWING CERTIFICATE WILL APPLY SHOW SURVEYOR'S ORIGINAL SEAL AND SIGNATURE IN RED INK. COPIES BY ANY OTHER MEANS MAY HAVE ALTERATIONS WHICH DO NOT REPRESENT THE SURVEYOR'S WORK PRODUCT.

I HEREBY CERTIFY THAT THE ABOVE DESCRIBED PROPERTY HAS BEEN SURVEYED UNDER MY DIRECTION AND THAT THE ABOVE MAP IS A TRUE REPRESENTATION THEREOF AND SHOWS THE SIZE AND LOCATION OF THE PROPERTY AND ITS EXTERIOR BOUNDARIES. THIS SURVEY IS MADE FOR THE USE OF THE PRESENT OWNERS OF THE PROPERTY, AND ALSO THOSE WHO PURCHASE, MORTGAGE, OR GUARANTEE THE TITLE THERETO WITHIN ONE YEAR FROM THE DATE HEREOF.

DATED: 4-7-2000

PETER S. GORDON R.L.S. 2101

WISCONSIN PETER S. GORDON S-2101 ELKHORN WI LAND SURVEYOR

RECEIVED MAY 10 2000

PROJECT 5559
DATE: 04–05–2000
SHEET 1 OF 1

HTL-5 H16-1577

APR 07 2000