
AMBIT LAND SURVEYING
P. O. Box 42
Bassett, WI. 53101

PLAT OF SURVEY
OF

PHONE 262-537-4874
FAX 262-537-4221

Lots 7 and 8 of Strawberry Banke Plantation, a subdivision located in the Southwest Quarter of Section 36, Town 4 North, Range 16 East, Town of LaGrange, Walworth County, Wisconsin and in the Northwest Quarter of Section 1, Town 3 North, Range 16 East, Town of Sugar Creek, Walworth County, Wisconsin

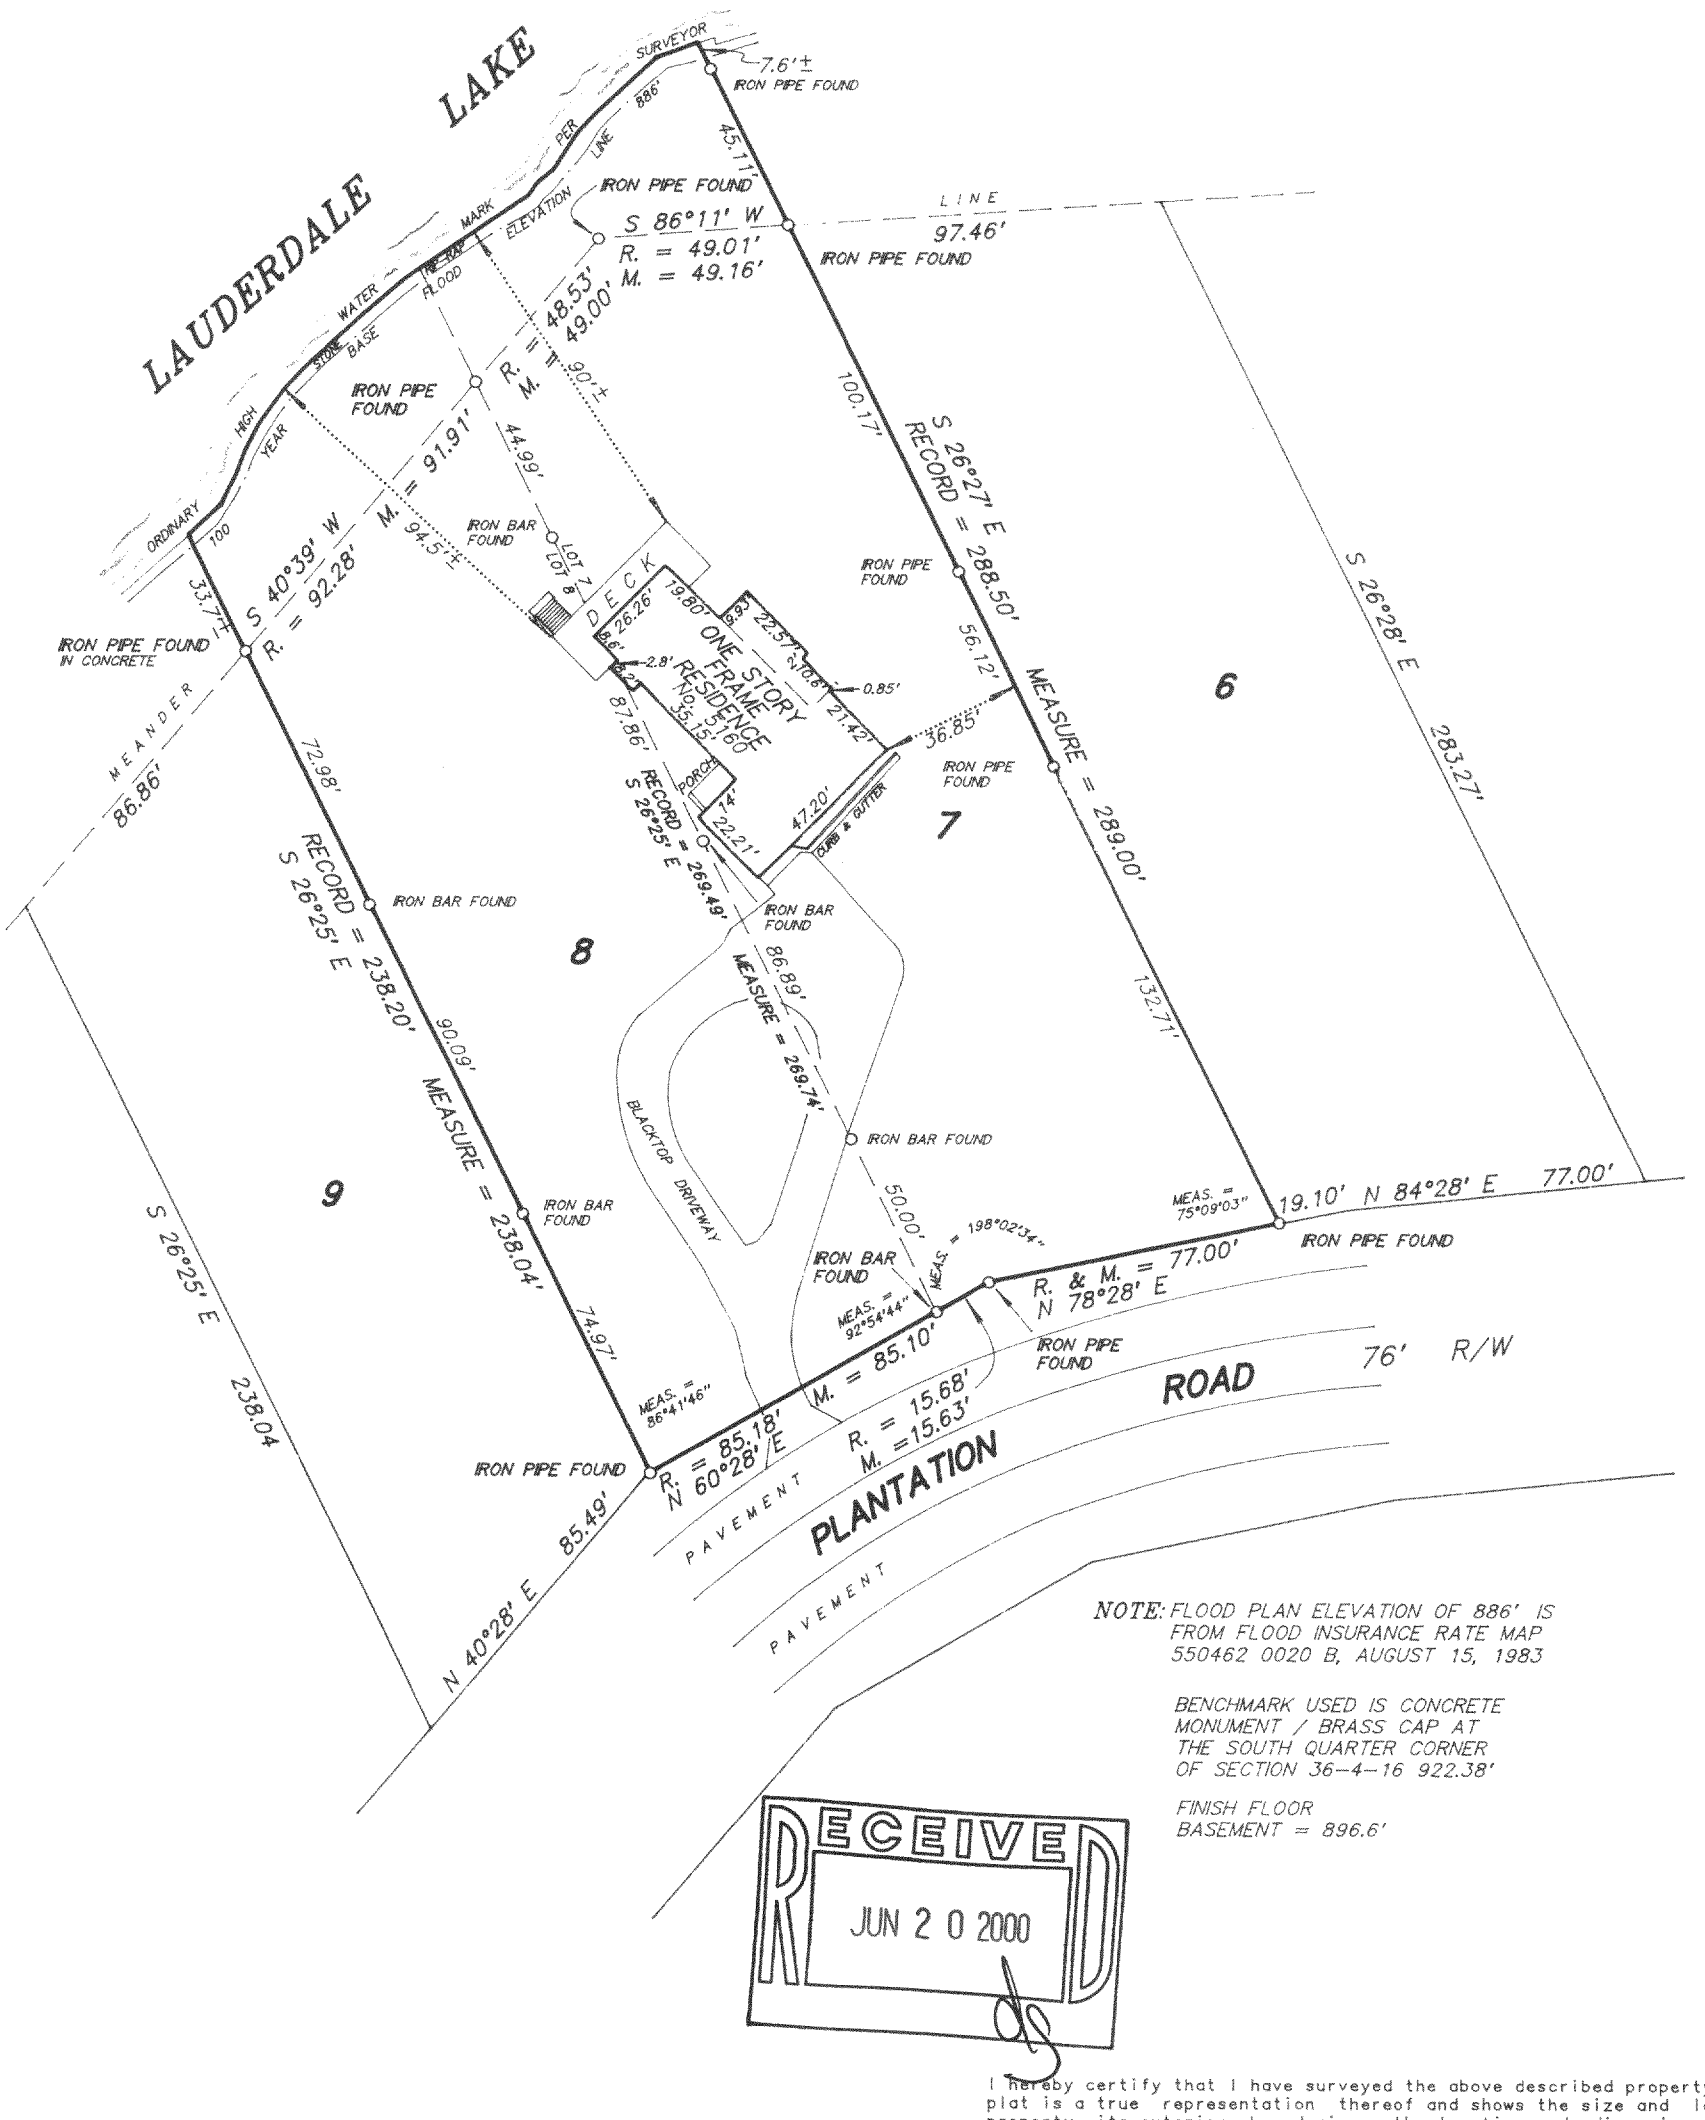

NOTE: FLOOD PLAN ELEVATION OF 886' IS FROM FLOOD INSURANCE RATE MAP 550462 0020 B, AUGUST 15, 1983

BENCHMARK USED IS CONCRETE MONUMENT / BRASS CAP AT THE SOUTH QUARTER CORNER OF SECTION 36-4-16 922.38'

FINISH FLOOR
BASEMENT = 896.6'

RECEIVED
JUN 2 0 2000

N

SCALE 1 inch = 50 feet

ORDERED BY D. Schiltz / Davis, Mulligan and Schiltz, LTD.

JOB NO. 0 0 0 2 0

I hereby certify that I have surveyed the above described property and the above plat is a true representation thereof and shows the size and location of the property, its exterior boundaries, the location and dimensions of all visible structures thereon, boundary fences, apparent easements and roadways and visible encroachments, if any.

This survey is made for the exclusive use of the present owners of the property, and also those who purchase, mortgage, or guarantee the title thereto within one year from the date hereof.

Dated at Bassett, Wisconsin this _____ day of _____ 2000.

Mark A. Bolender
Wisconsin Registered Land Surveyor S - 1784

HSP-7
HSP-8

416-1580