
Plat of Survey


of

Lot 12 of Green Lake Subdivision,
located in the Northwest 1/4 of Section 25, Town 4 North,
Range 16 East, Town of LaGrange, Walworth County, Wisconsin.

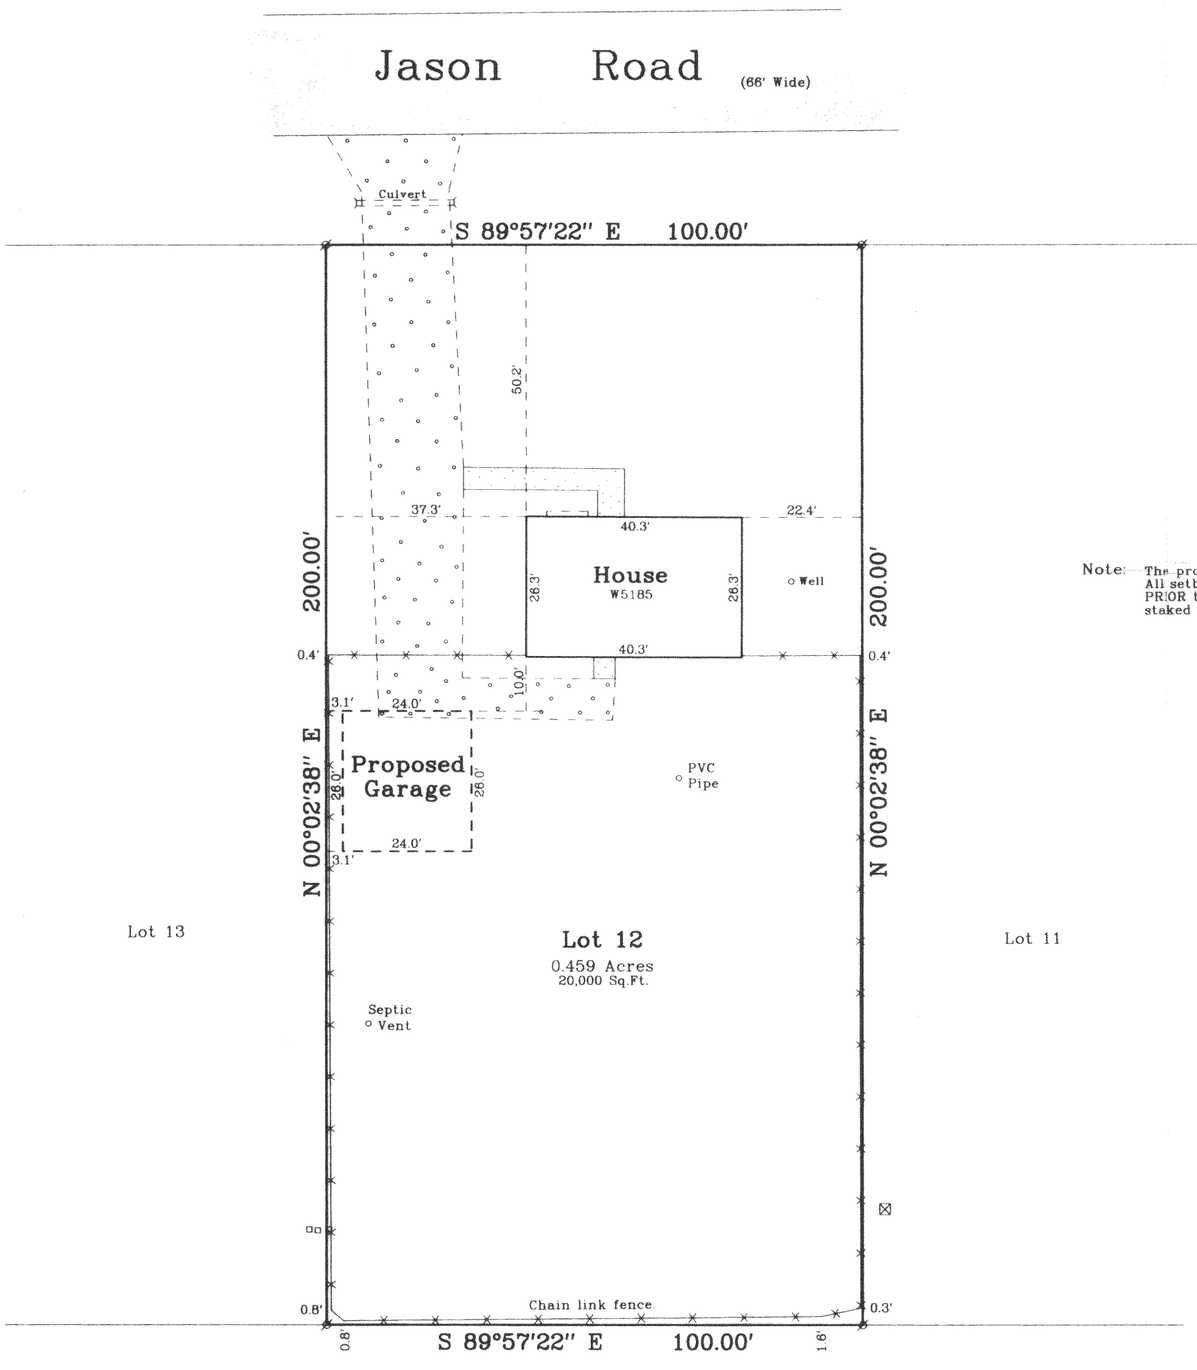


Surveyed for: **Sue Rush**
W5185 Jason Road
Elkhorn, Wisconsin. 53121

Note: The proposed garage is shown as instructed by the owner. All setbacks must be approved by the Building Inspector PRIOR to construction. The proposed garage was not staked in the field.

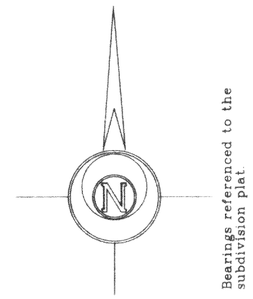

Bearings referenced to the subdivision plat

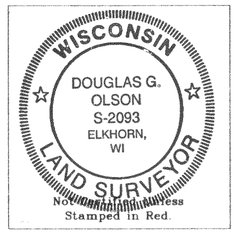

Notes:
1) This survey plat is not certified unless signed and sealed in red ink.
2) This survey is subject to Wisconsin lien laws. This Plat of Survey is the notice of intent to file lien. Lien waiver required.

RECEIVED
JUL 13 2000

Copyright c 1999 by Jensen & Olson Land Surveying, LLC.

All rights reserved. No part of this survey plat may be reproduced or transmitted in any form by any means - graphic, electronic, or mechanical, including photocopying, tracing, or information storage and retrieval systems - without permission in writing from Douglas G. Olson, Jensen & Olson Land Surveying, LLC.

I, Douglas G. Olson, Wisconsin Registered Land Surveyor, do hereby certify that this survey was performed by me or under my direction in full compliance with owners / agents instructions and Chapter A-E 7 of the Wisconsin Administrative Code Minimum Standards for Property Surveys; and that this map is an accurate representation thereof to the best of my knowledge and belief.

Date: 11-26-99

Douglas G. Olson
Wisconsin Registered Land Surveyor - 2093

Survey Date: Nov. 26, 1999
Revisions:

Scale in Feet
1" = 20'
0' 10' 20' 40'

Jensen & Olson Land Surveying, LLC
45 South Wisconsin Street P.O. Box 322
Elkhorn, Wisconsin. 53121
Telephone (262) 723-3434
Facsimile (262) 723-8044

Legend
- Found Iron Rod
- Recorded Information
- Utility Box
- Utility Pedestal
- Concrete Surface
- Asphalt Surface
- Gravel Surface

Sheet 1 of 1 Sheets

Job Reference Number 1999.135

1999.135

H65-12
H16-1592