

BOUNDARY & TOPOGRAPHIC MAPPING

PART OF LOT 1 OF CSM 813
LOCATED IN THE NW 1/4 OF SEC. 36 &
THE NE 1/4 OF SEC 35
TOWN 4 NORTH, RANGE 16 EAST
WALWORTH COUNTY, WISCONSIN

RECEIVED
OCT 18 2000

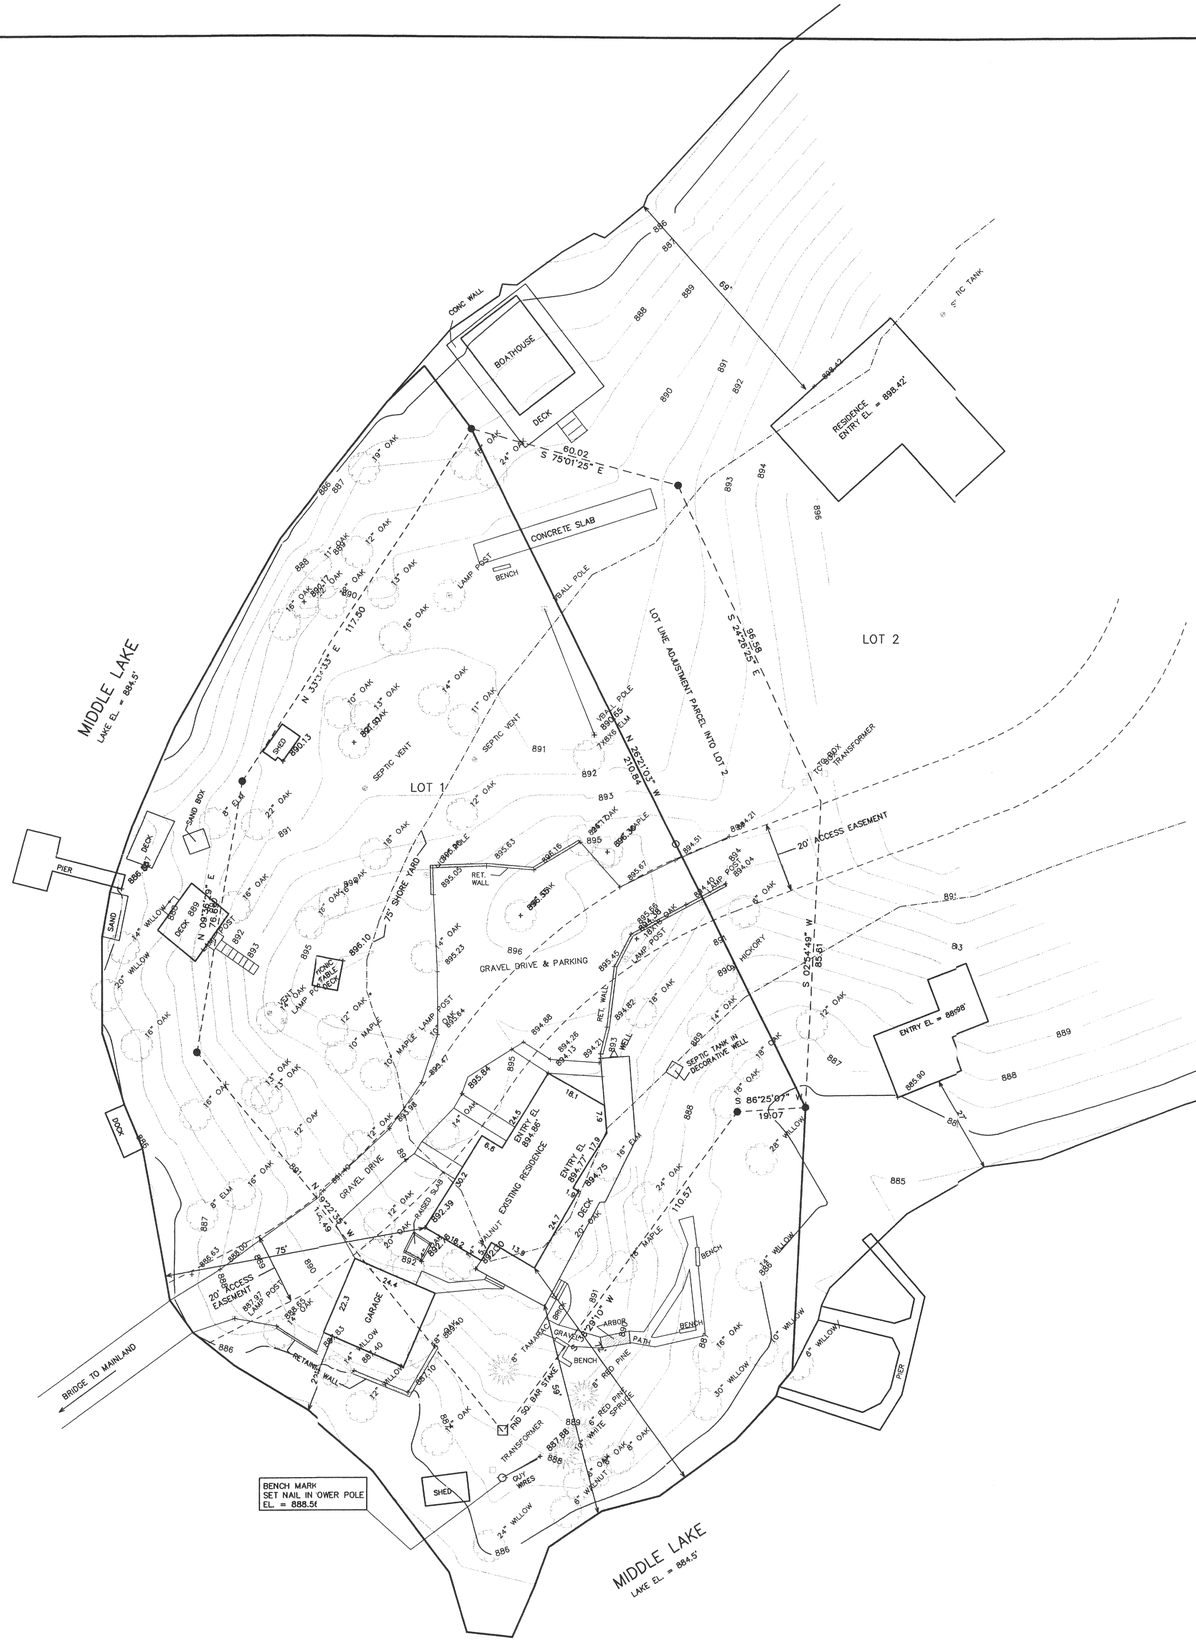

○ = FOUND IRON PIPE STAKE
● = FOUND IRON REBAR STAKE
⊞ = LAMP POLE
○ = POWER POLE

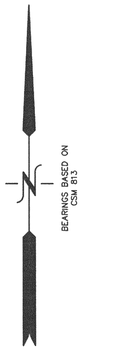

10 5 0 10 20 30 40 50 60 70 80 90 100
MAP SCALE IN FEET ORIGINAL 1" = 20'

NOTE: COPIES OF THIS MAP TO WHICH THE FOLLOWING CERTIFICATE WILL APPLY SHOW SURVEYOR'S ORIGINAL SEAL AND SIGNATURE IN RED INK. COPIES BY ANY OTHER MEANS MAY HAVE ALTERATIONS WHICH DO NOT REPRESENT THE SURVEYOR'S WORK PRODUCT.

I HEREBY CERTIFY THAT THE ABOVE DESCRIBED PROPERTY HAS BEEN SURVEYED UNDER MY DIRECTION AND THAT THE ABOVE MAP IS A TRUE REPRESENTATION THEREOF AND SHOWS THE SIZE AND LOCATION OF THE PROPERTY AND ITS EXTERIOR BOUNDARIES. THIS SURVEY IS MADE FOR THE USE OF THE PRESENT OWNERS OF THE PROPERTY AND ALSO THOSE WHO PURCHASE, MORTGAGE, OR GUARANTEE THE TITLE THERETO WITHIN ONE YEAR FROM THE DATE HEREOF.

DATED: SEPT. 14, 2000

PETER S. GORDON R.L.S. 2101

WORK ORDERED BY: ELLEN FRYMIRE
1605 AUTUMN DRIVE
RACINE, WISCONSIN 53402

FARRIS, HANSEN & ASSOCIATES, INC.
ENGINEERING – ARCHITECTURE – SURVEYING
7 RIDGWAY COURT P.O. BOX 437
ELKHORN, WISCONSIN 53121
OFFICE: (262) 723-2098 FAX: (262) 723-5886

REVISIONS

PROJECT NO.
5659

DATE
09-13-00

SHEET NO.
1 OF 1

SEP 14 2000

HA 81300001

4116-1626