
Plat of Survey

of


Lot 26 of Cali Acres Subdivision,

located in the Southwest 1/4 of Section 35, Town 4 North, Range 16 East, Town of LaGrange, Walworth County, Wisconsin.

Surveyed for: **Thelen Total Construction, Inc.**
N5896 US Highway 12
P.O. Box 17
Elkhorn, Wisconsin. 53121

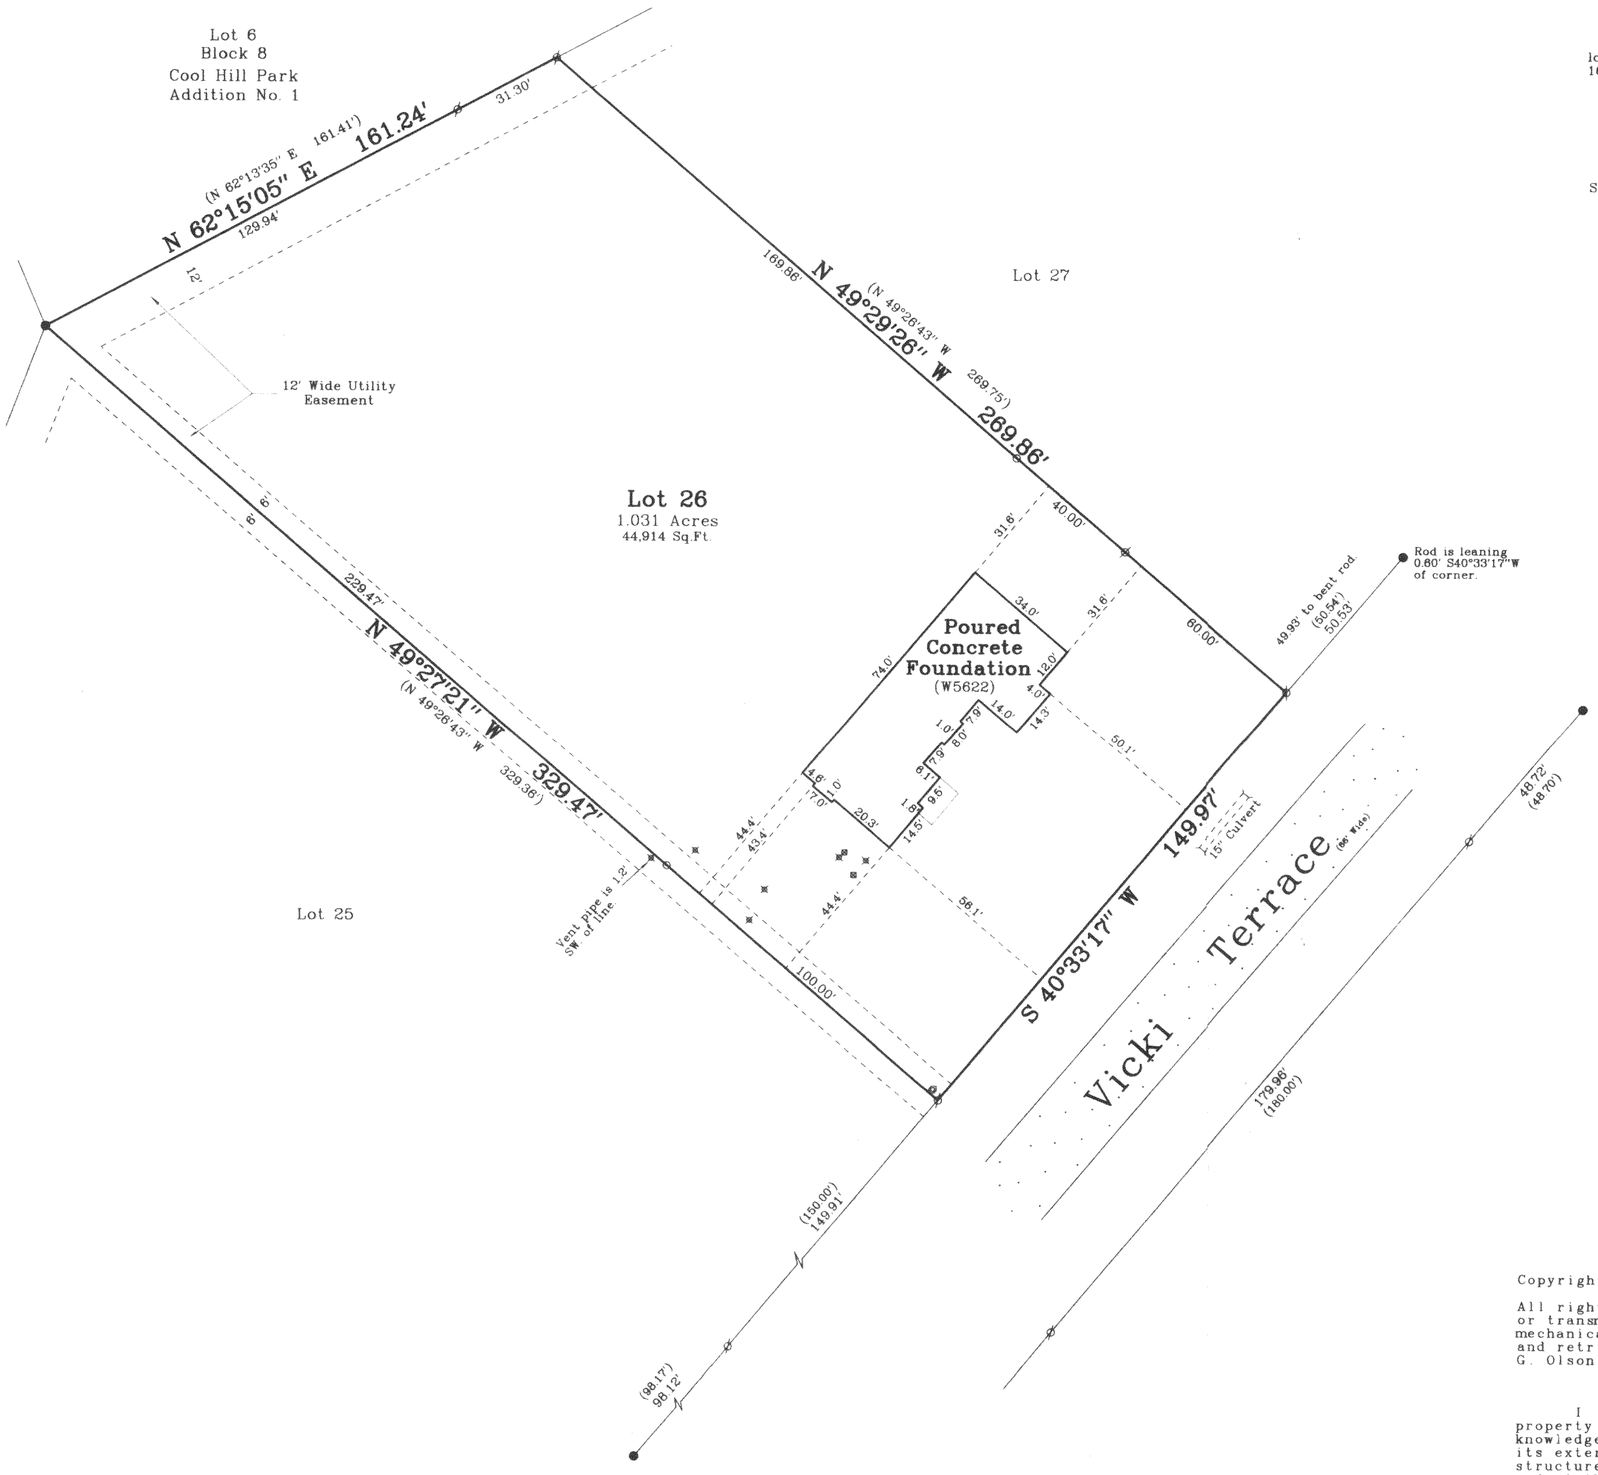

Bearings referenced to the plat of Cali Acres Subdivision.

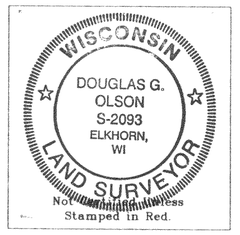

Notes: 1) This survey plat is not certified unless signed and sealed in red ink.

2) This survey is subject to Wisconsin lien laws. This Plat of Survey is the notice of intent to file lien. Lien waiver required.



Copyright c 2000 by Jensen & Olson Land Surveying, LLC.

All rights reserved. No part of this survey plat may be reproduced or transmitted in any form by any means - graphic, electronic, or mechanical, including photocopying, tracing, or information storage and retrieval systems - without permission in writing from Douglas G. Olson, Jensen & Olson Land Surveying, LLC.

I hereby certify that I have surveyed the above described property and the map hereon is correct to the best of my professional knowledge and belief and shows the size and location of the property, its exterior boundaries, the location and dimensions of all visible structures thereon, boundary fences, apparent easements and roadways and visible encroachments, if any.

This survey is made for the exclusive use of the present owners of property, and also those who purchase, mortgage or guarantee title thereto, within one year from the date hereof.

Douglas G. Olson
Wisconsin Registered Land Surveyor - 2093

Survey Date: Nov. 3, 2000
Revisions:

Scale in Feet
1" = 30'
0' 15' 30' 60'

Jensen & Olson Land Surveying, LLC
45 South Wisconsin Street P.O. Box 322
Elkhorn, Wisconsin. 53121
Telephone (262) 723-3434
Facsimile (262) 723-8044

Legend
- ● Found Iron Rod 1 3/16" dia.
- ⊗ Found Iron Rod 3/4" dia.
- ○ Set Iron Rod 3/4" dia.
- () Recorded Information
- □ Utility Pedestal
- ▭ Asphalt Surface
- ✖ PVC Pipe
- ▪ Concrete Cover

Sheet 1 of 1 Sheets

Job Reference Number
2000.146

2000.146

HC-26
416-16666