
ABELL
SURVEYING & MAPPING
1140 SEQUOIA STREET • DELAVAN, WISCONSIN 53115
262-728-6737

NOTE: BEARINGS ARE REFERENCED TO THE RECORDED SUBDIVISION PLAT.

REC'D
MAY 10 2002

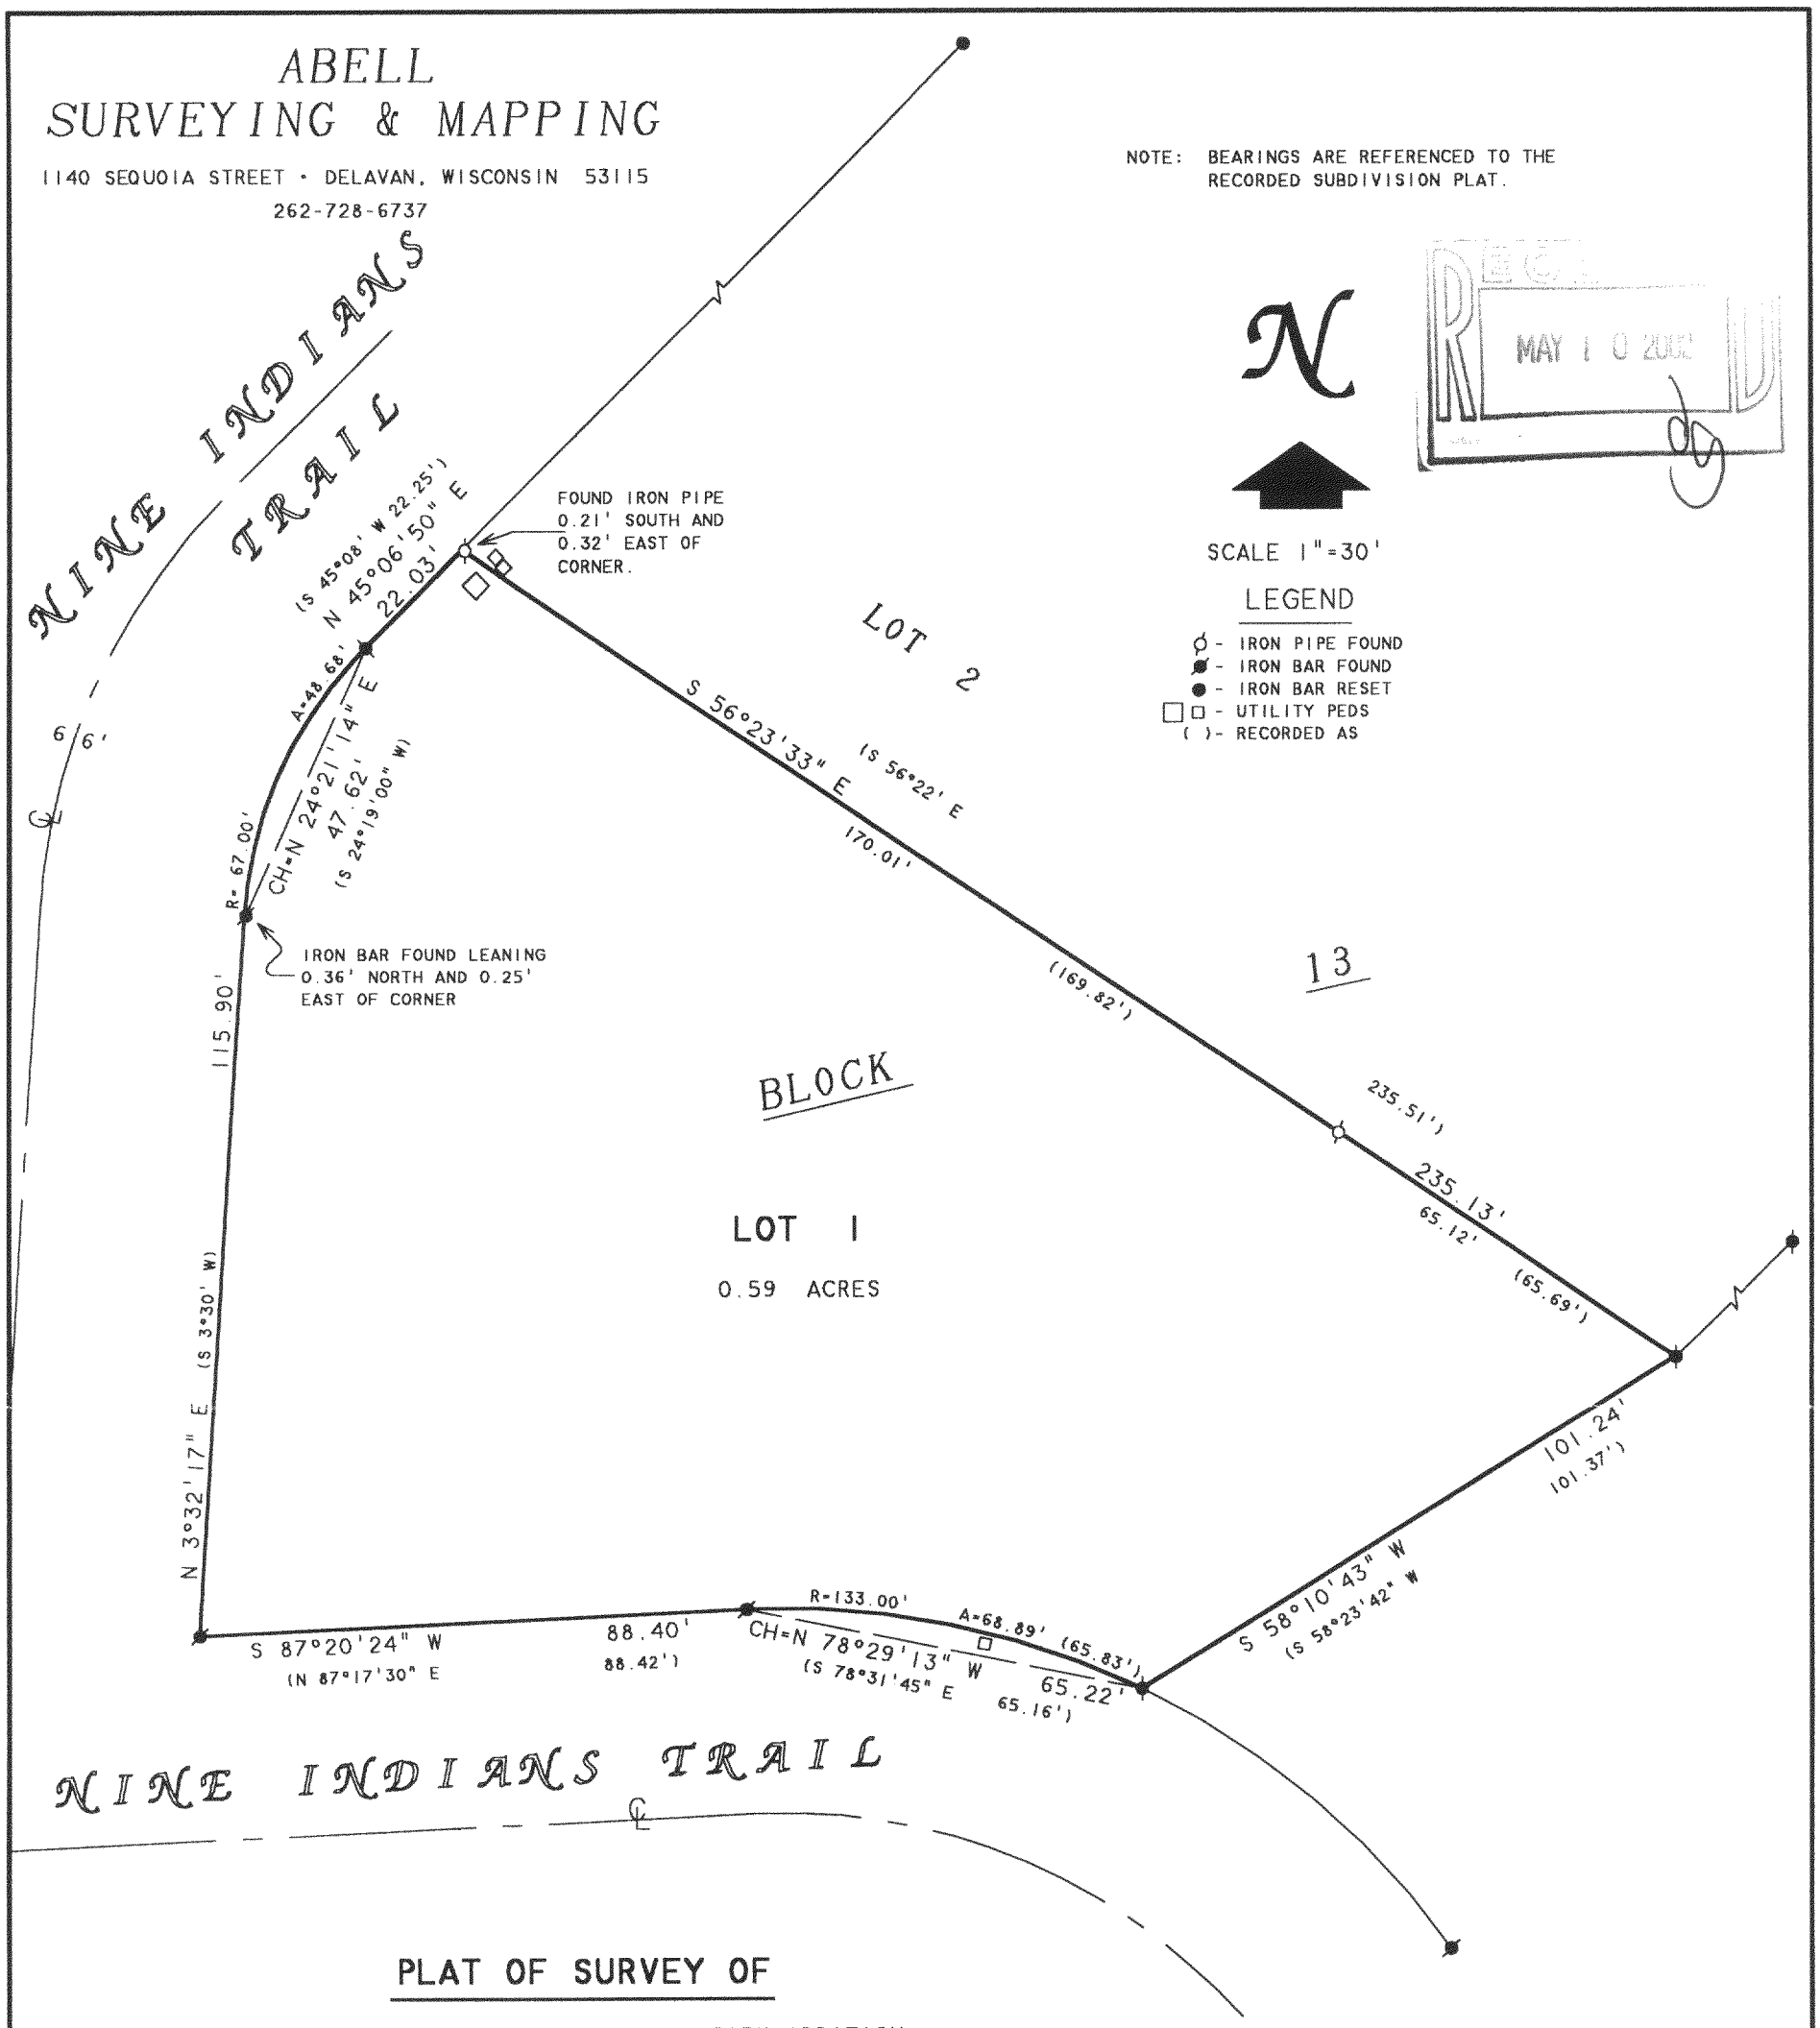

SCALE 1"=30'

LEGEND

- ○ - IRON PIPE FOUND
- ◉ - IRON BAR FOUND
- ● - IRON BAR RESET
- □□ - UTILITY PEDS
- ( ) - RECORDED AS

PLAT OF SURVEY OF

LOT 1, BLOCK 13, COOL HILL PARK ADDITION NO. 2, LOCATED IN THE SOUTHEAST 1/4 OF SECTION 34, T4N,R16E, WALWORTH COUNTY, WISCONSIN.

I HEREBY CERTIFY THAT I HAVE SURVEYED THE ABOVE DESCRIBED PROPERTY AND THAT THE ABOVE MAP IS A TRUE REPRESENTATION THEREOF AND SHOWS THE SIZE AND LOCATION OF THE PROPERTY, ITS EXTERIOR BOUNDARIES, THE LOCATION OF ALL VISIBLE STRUCTURES AND DIMENSIONS OF ALL PRINCIPAL BUILDINGS THEREON, BOUNDARY FENCES, APPARENT EASEMENTS, ROADWAYS AND VISIBLE ENCROACHMENTS, IF ANY, TO THE BEST OF MY KNOWLEDGE AND BELIEF.

THIS SURVEY IS MADE FOR THE USE OF THE PRESENT OWNERS OF THE PROPERTY, AND ALSO THOSE WHO PURCHASE, MORTGAGE, OR GUARANTEE THE TITLE THERETO WITHIN ONE (1) YEAR FROM DATE HEREON.

David F. Abell

DAVID F. ABELL
WISCONSIN REGISTERED LAND SURVEYOR, S-1596

ORDERED BY: KEEFE REAL ESTATE
P.O. BOX 460
LAKE GENEVA, WI 53147

RECERTIFIED: DEC. 27, 2001

September 9, 2000
DATE

JOB NUMBER - 00144

NOTE: THIS IS NOT A CERTIFIED COPY UNLESS SEALED.

416-1772

HCH 2-3