
55-17 (3)

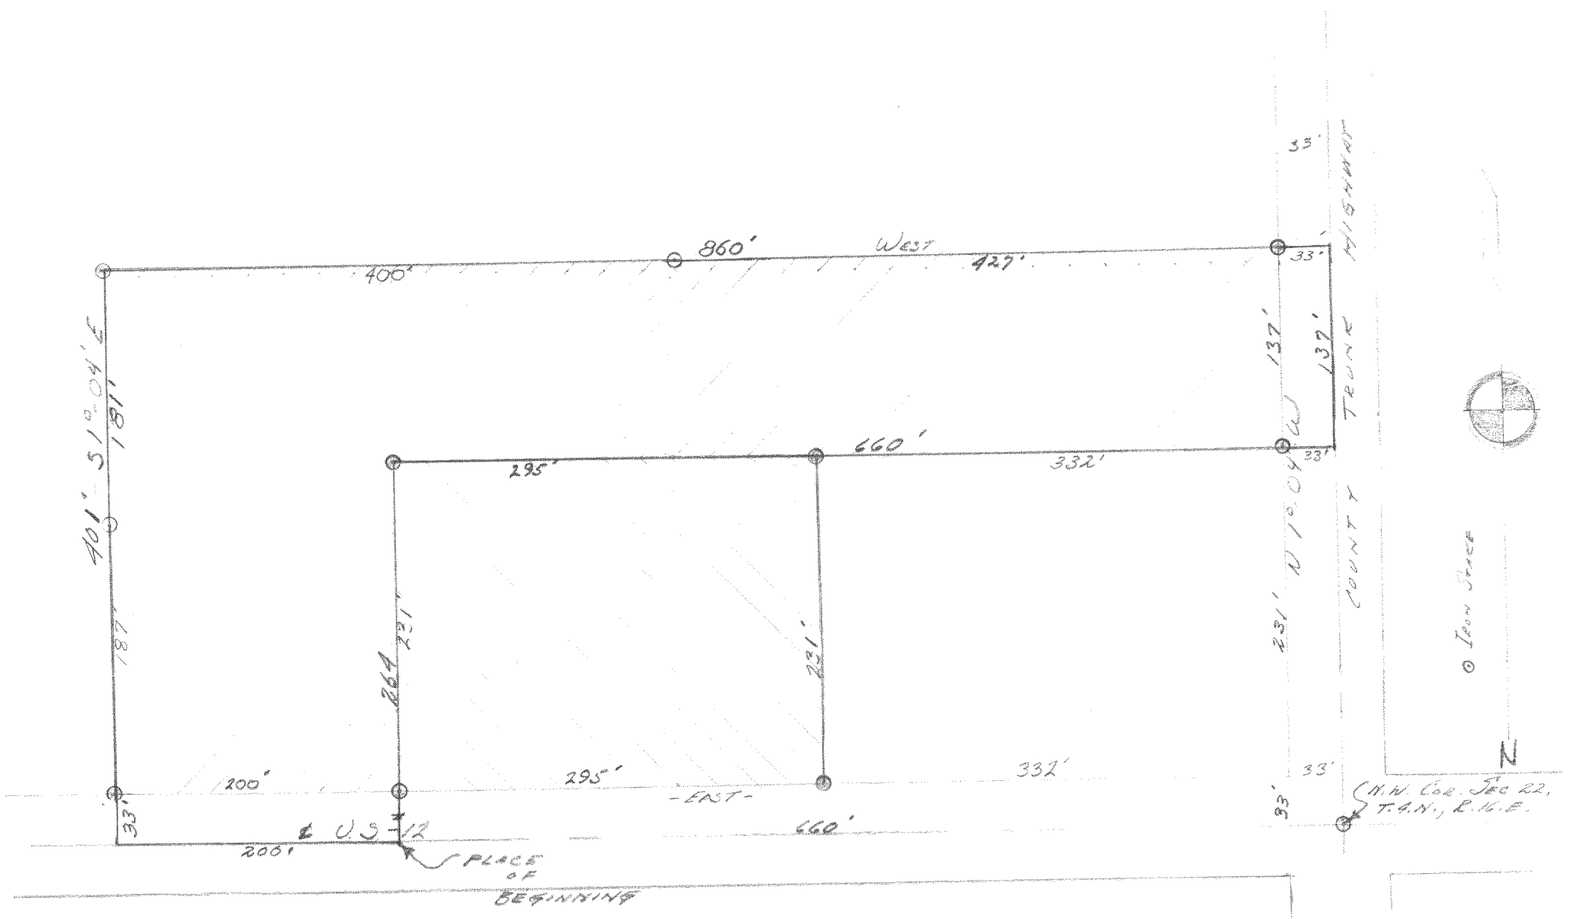

DESCRIPTION:

Commencing at a point in the centerline of U.S. Highway #12, that is 660 feet, East of the Northwest corner of Section 22, Town 4, north, Range 16 east of the 4th P.M., thence East along the centerline of said highway 200 feet to a point, thence South 1° 04' East, 401 feet to an iron stake, thence West 860 feet to a point in the centerline of the County Trunk Highway, thence North 1° 04' West, along the centerline of said County Trunk Highway, 137 feet to a point, thence East 660 feet to an iron stake, thence North 1° 04' West, 264 feet to the place of beginning. Containing 1 acre more or less.

CERTIFICATE: I, hereby certify that I have on this the 14th day of May 1955, surveyed the above described property, and find that no encroachments exist.
SIGNED AND SEALED ON THIS THE 2ND DAY OF JUNE 1955.

Joseph M. Biagi. Professional Engineer.
Elkhorn Wisconsin.

L-22-3 (part of)
~~22-8A, 3B~~
< s 656

416-17 B

