
# ABELL
# SURVEYING & MAPPING

1140 SEQUOIA STREET · DELAVAN, WISCONSIN 53115
262-728-6737

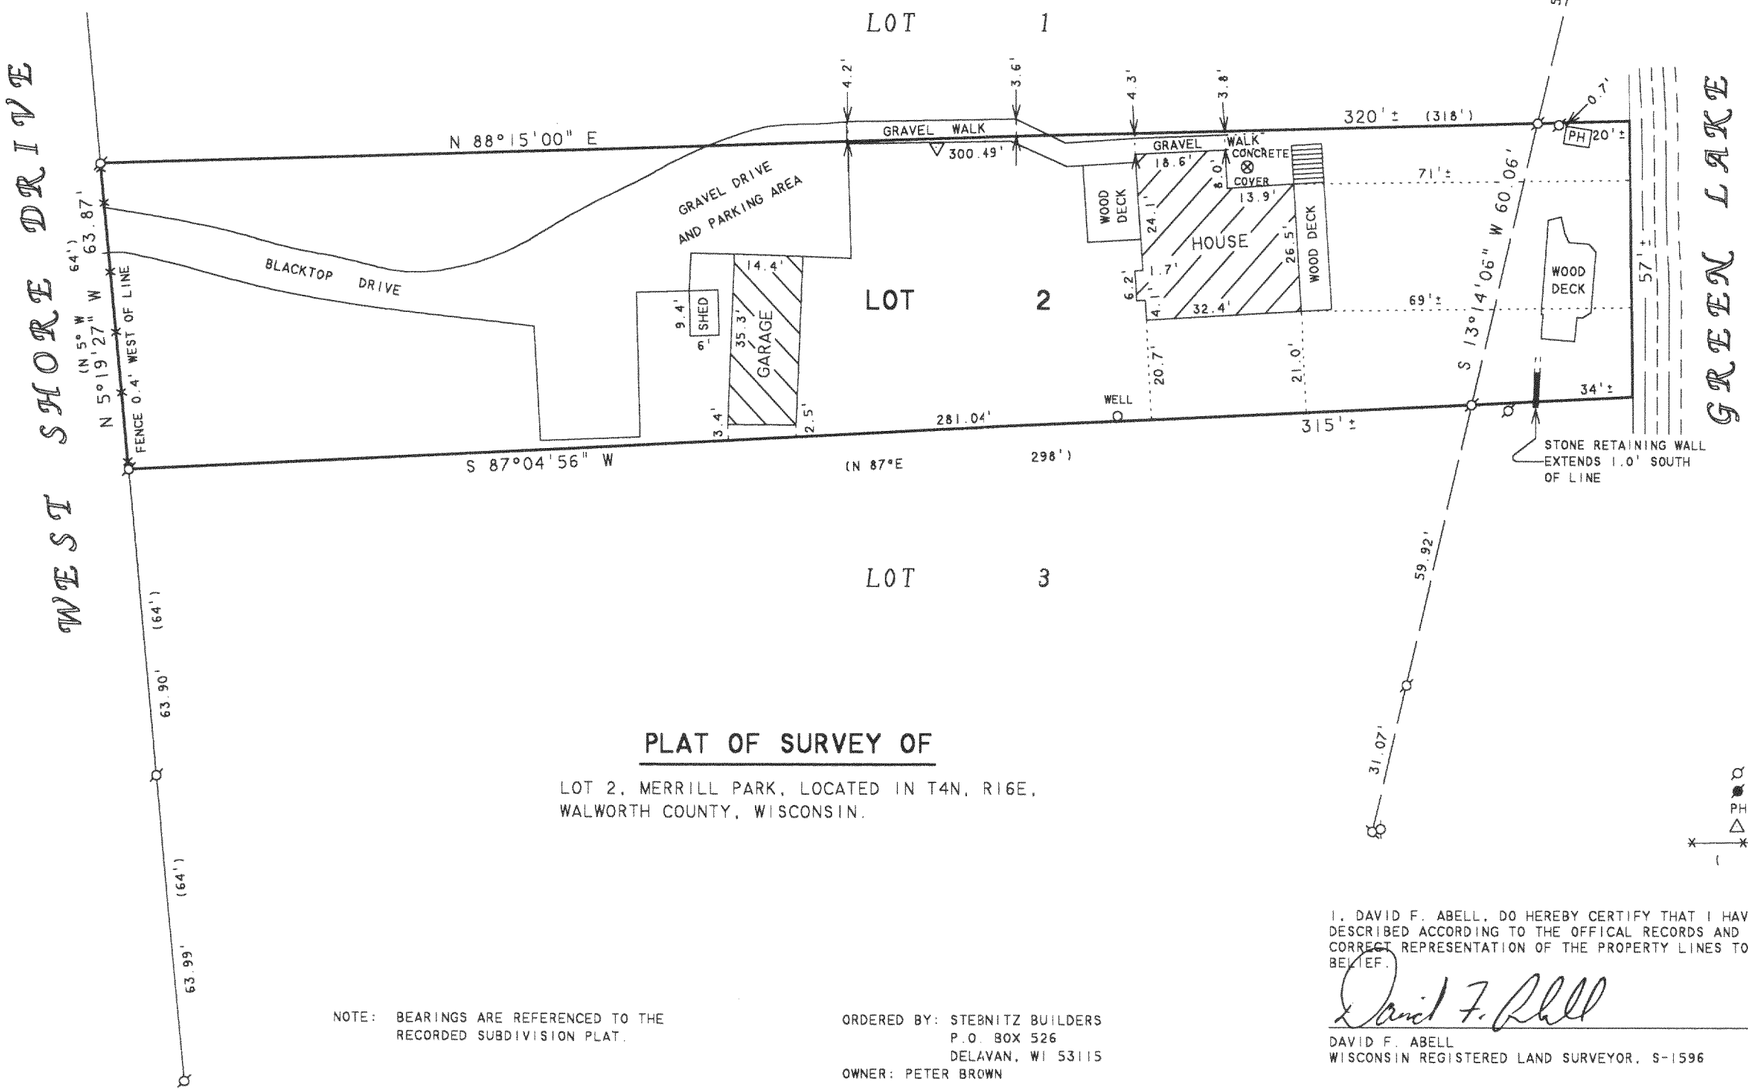


## PLAT OF SURVEY OF

LOT 2, MERRILL PARK, LOCATED IN T4N, R16E, WALWORTH COUNTY, WISCONSIN.

NOTE: BEARINGS ARE REFERENCED TO THE RECORDED SUBDIVISION PLAT.

ORDERED BY: STEBNITZ BUILDERS
P.O. BOX 526
DELAVAN, WI 53115
OWNER: PETER BROWN

REVISED: MAY 7, 2002 TO SHOW WOOD DECK AT THE SHORE ONLY.
ORDERED BY: PRAIRIE TREE LANDSCAPE CENTER
N6411 HIGHWAY "12"
ELKHORN, WI 53121

N

SCALE 1"=30'

LEGEND

- -IRON PIPE FOUND
- -IRON ROD FOUND
- PH -PUMP HOUSE
- -UTILITY POLE
- -WOOD FENCE
- ( )-RECORDED AS

I, DAVID F. ABELL, DO HEREBY CERTIFY THAT I HAVE SURVEYED THE PROPERTY HEREON DESCRIBED ACCORDING TO THE OFFICAL RECORDS AND THAT THE PLAT HEREON IS A CORRECT REPRESENTATION OF THE PROPERTY LINES TO THE BEST OF MY KNOWLEDGE AND BELIEF.

David F. Abell

DAVID F. ABELL
WISCONSIN REGISTERED LAND SURVEYOR, S-1596

May 1, 2000

DATE JOB NUMBER - 00042A
NOTE: THIS IS NOT A CERTIFIED COPY UNLESS SEALED.

RECEIVED
AUG 26 2002

HME 2

416-1806