
ABERNATHY and ASSOCIATES
Kenneth B. Abernathy Jr.
Wisconsin Registered Land Surveyor S-1594

W4056 BRAY RD.
ELKHORN, WI. 53121
PHONE: (262) 723-4260 (OFFICE)
(262) 723-7209 (FAX)
Email: abernathy@elknet.net

PLAT OF SURVEY

LOT 3, BLOCK 2 OF COOPERS'S MID-LAKES SUBDIVISION LOCATED IN THE NORTHWEST 1/4 OF SECTION 35, TOWN 4 NORTH, RANGE 16 EAST, LAGRANGE TOWNSHIP, WALWORTH COUNTY, WISCONSIN.

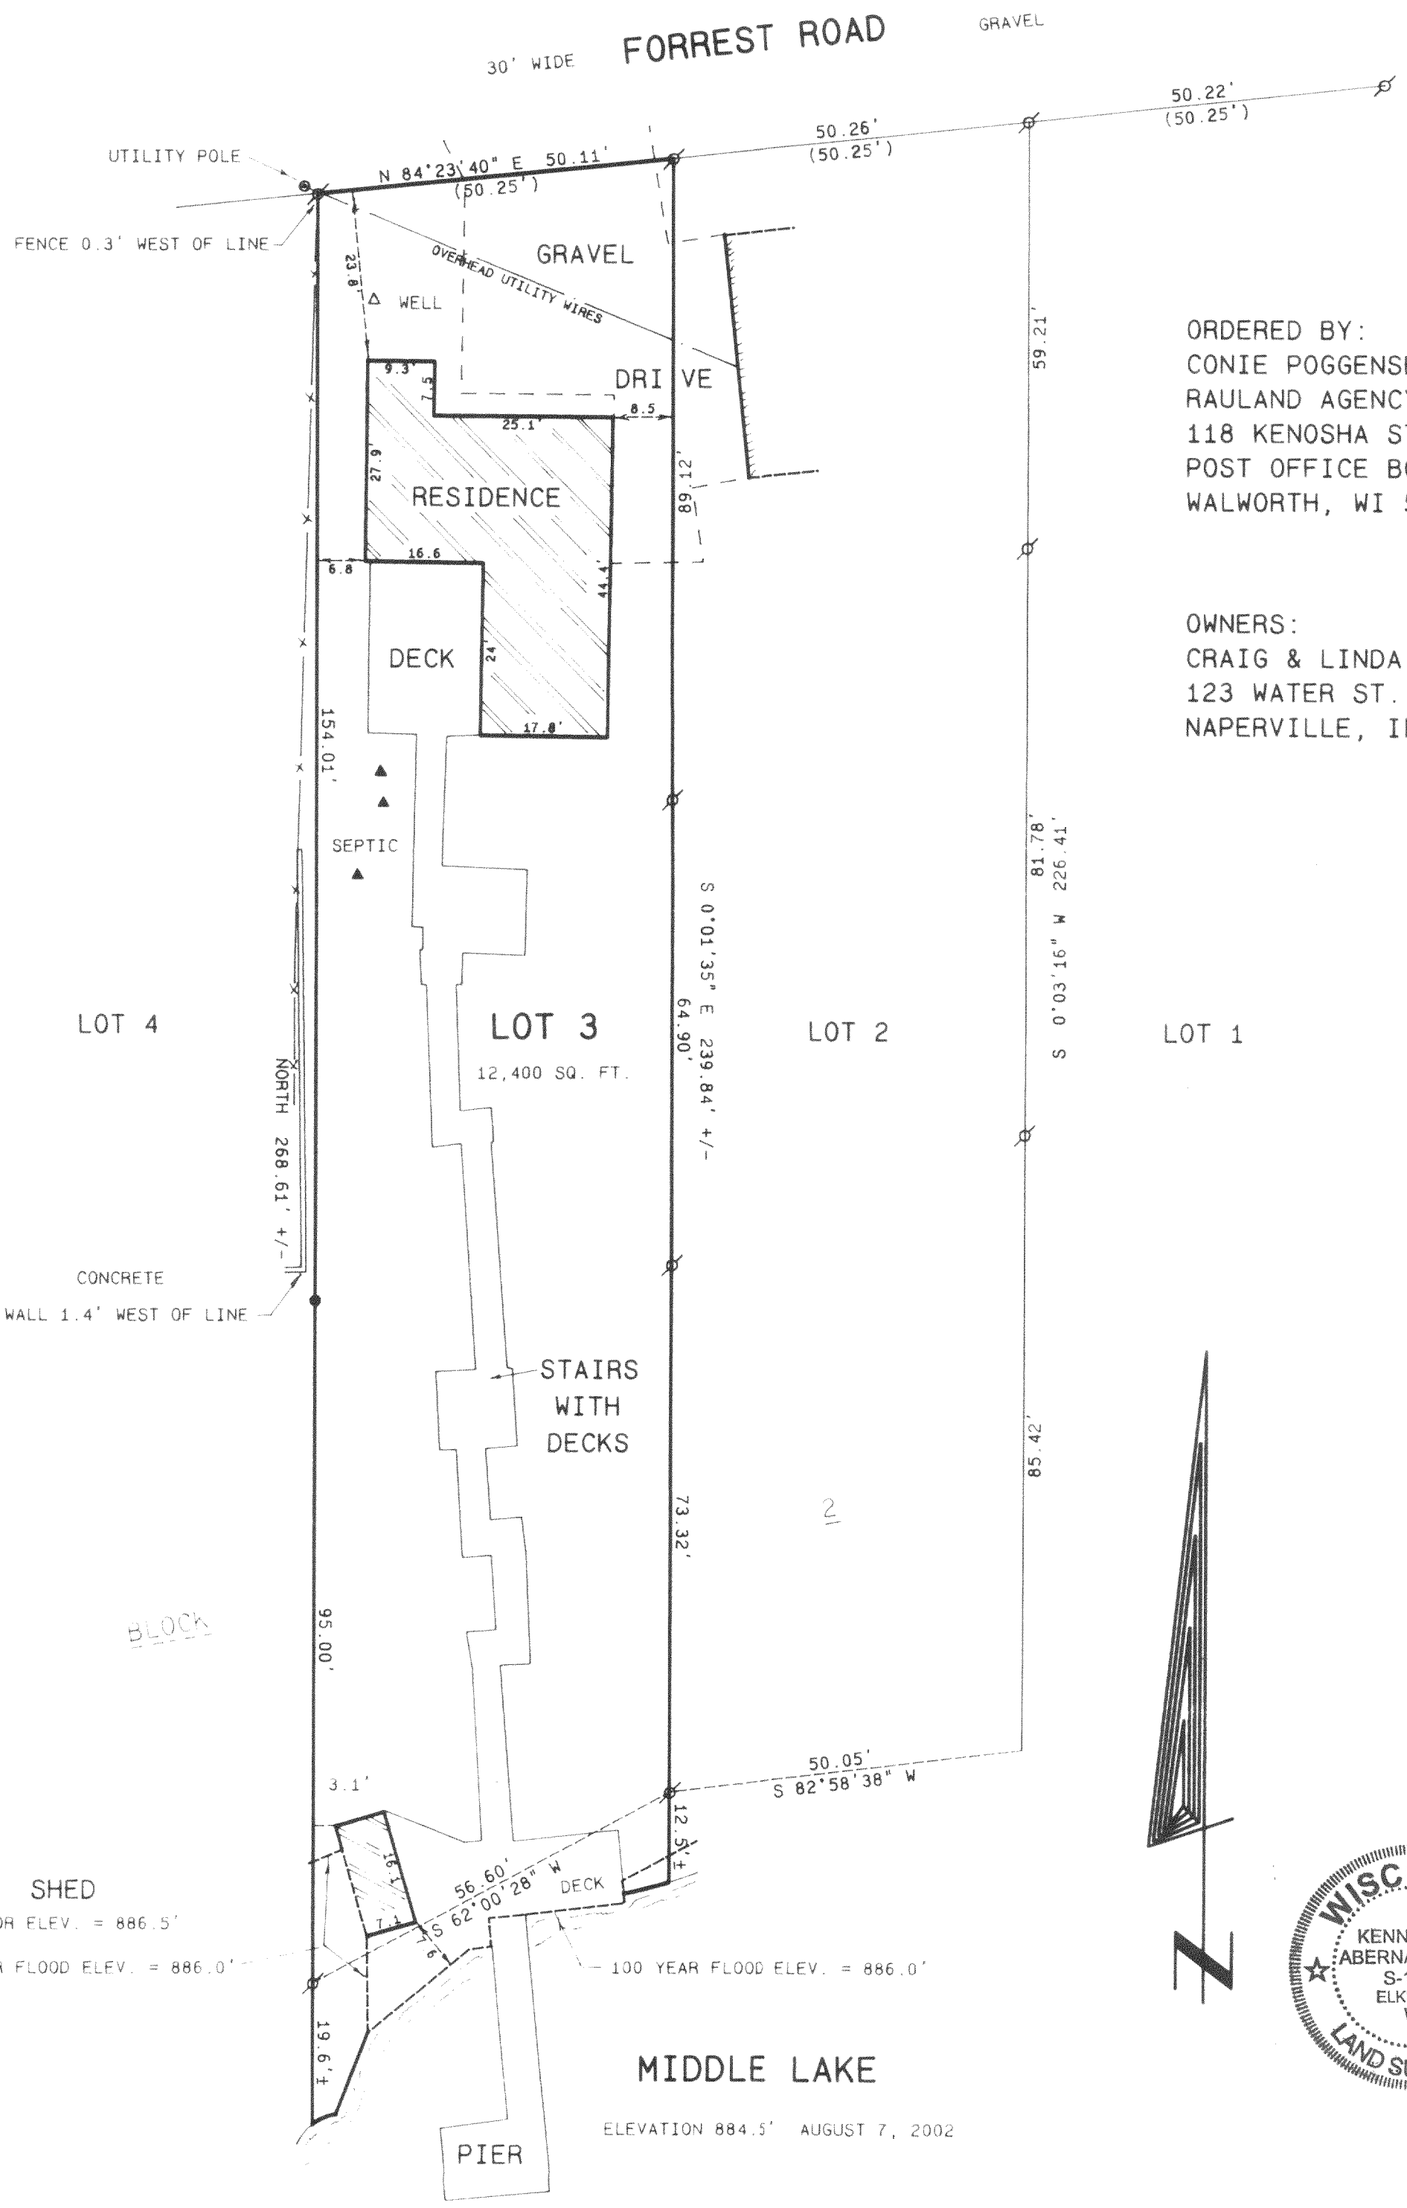

ORDERED BY:
CONIE POGGENSEE
RAULAND AGENCY
118 KENOSHA STREET
POST OFFICE BOX 159
WALWORTH, WI 53184

OWNERS:
CRAIG & LINDA COBINE
123 WATER ST.
NAPERVILLE, IL 60540

SHED
1ST FLOOR ELEV. = 886.5'
100 YEAR FLOOD ELEV. = 886.0'

MIDDLE LAKE
ELEVATION 884.5' AUGUST 7, 2002

Legend
- FOUND IRON PIPE
- FOUND IRON ROD
- FOUND BRASS CAPPED MONUMENT
- FOUND CONCRETE MONUMENT
- CHISEL CUT IN CONCRETE
- SET IRON ROD, 24" LONG, WEIGHING 1.5 LBS. LINEAL FT., 3/4" DIA.
- SET IRON ROD, 30" LONG, WEIGHING 4.5 LBS. LINEAL FT., 1 11/16" DIA.
- (xx) RECORDED AS DIMENSION
- EXISTING FENCE

WISCONSIN
KENNETH B. ABERNATHY, JR.
S-1594
ELKHORN
WI
LAND SURVEYOR

RECEIVED
FEB 26 2003
KW

SCALE: 1" = 20 FEET

I hereby certify, that the above plat is a correct representation of a survey performed by me or under my direction and that the above map is a true representation thereof and shows the size and location of the property, its exterior boundaries, the location of all visible structures and improvements, and public ways and roadways adjoining the property except as indicated. This survey is made for the exclusive use of the present owners of the property, and only those who purchase, mortgage or guarantee title to the property within one year of the date hereof.

Kenneth B. Abernathy Jr.

KENNETH B. ABERNATHY, JR.
WISCONSIN REGISTERED LAND SURVEYOR,
S-1594

Date: 8-9-2002 Job No. 02.80

ACO-6

DESIGN PRODUCTS 1/2011

416-1860