PLAT OF SURVEY


OWNER: JEREMY & KRISTEN MONDAY


BUILDER: ALLAN BUILDERS, INC.
3045 SUMMIT CENTER DR.
OCONOMOWOC, WISCONSIN 53066
(262) 569-1000
(262) 569-1000 (FAX)

LOT 1 OF CERTIFIED SURVEY MAP NO. 3066, LOCATED IN THE NORTHWEST QUARTER (NW 1/4) OF THE SOUTHWEST QUARTER (SW 1/4) OF SECTION 33, TOWN 4 NORTH, RANGE 16 EAST, WALWORTH COUNTY, WISCONSIN.


EXISTING TOP OF FOUNDATION: 100.00

REFERENCE BEARING: THE WEST LINE OF THE SOUTHWEST QUARTER (SW 1/4) OF SECTION 33 WAS ASSUMED NORTH.

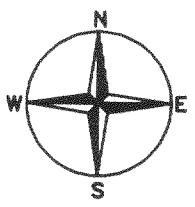

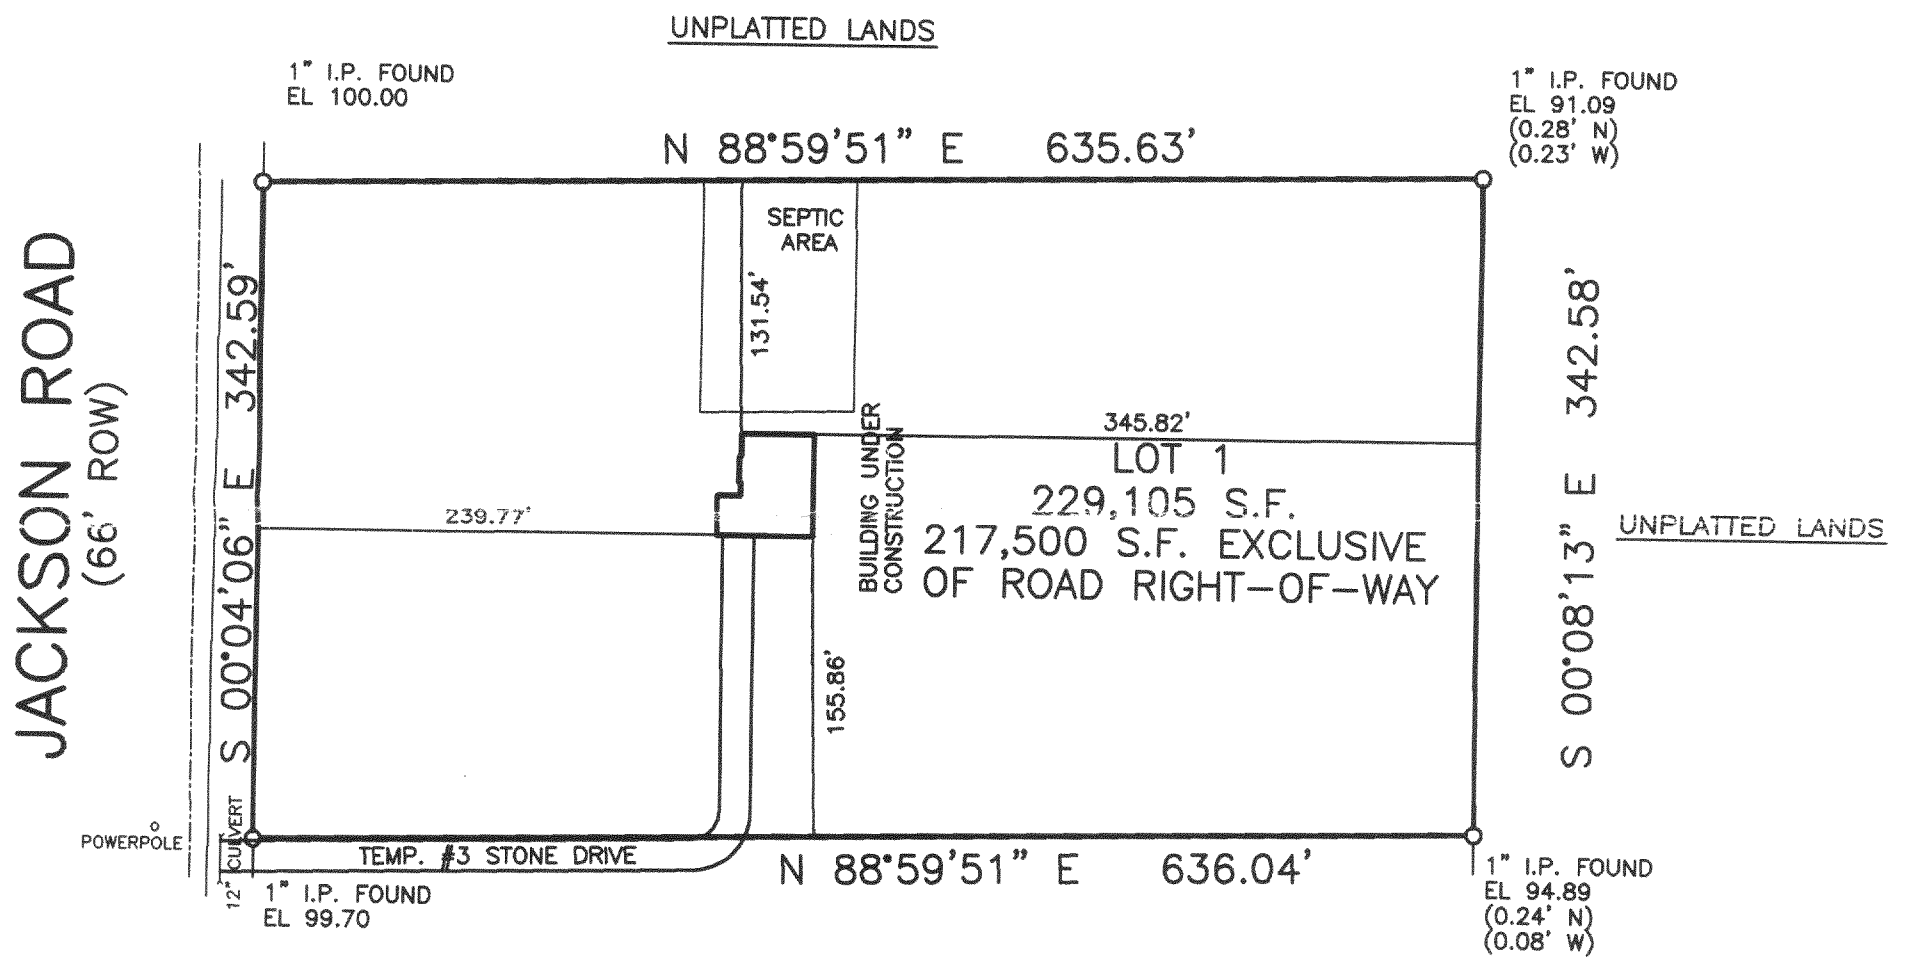


LOT 2

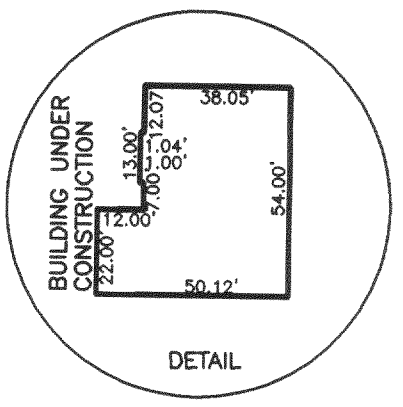

PLAN DATED: FEBRUARY 19, 2001
FILE NO.: D:\0000\00166
PLAN SCALE: 1" = 100'

IF THE SURVEYOR'S SEAL IS NOT RED, THE PLAN IS A COPY THAT SHOULD BE ASSUMED TO CONTAIN UNAUTHORIZED ALTERATIONS. THE CERTIFICATION CONTAINED ON THIS DOCUMENT SHALL NOT APPLY TO ANY COPIES.

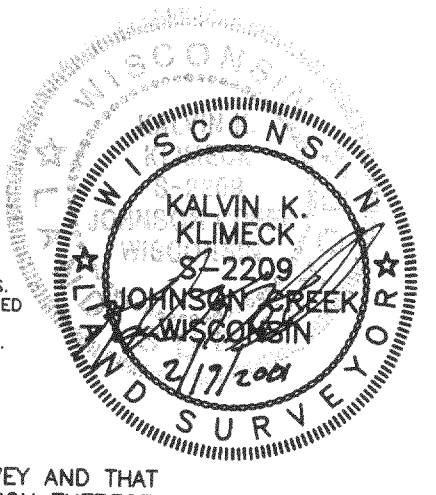

STATE OF WISCONSIN }
COUNTY OF JEFFERSON } SS.

WE, PIONEER ENGINEERING & SURVEYING, DO HEREBY CERTIFY THAT WE HAVE MADE THIS SURVEY AND THAT THE INFORMATION AS SHOWN ON THE ABOVE PLAT OF SURVEY IS TRUE AND CORRECT REPRESENTATION THEREOF.

PIONEER ENGINEERING AND SURVEYING, LLC.
CONSULTANTS IN SUBDIVISIONS AND COMMERCIAL DEVELOPMENTS
3902 C.T.H. "B"
JOHNSON CREEK, WI. 53038
(920) 699 - 3330 FAX: 699 - 3332

#A3066-1

416-1882