


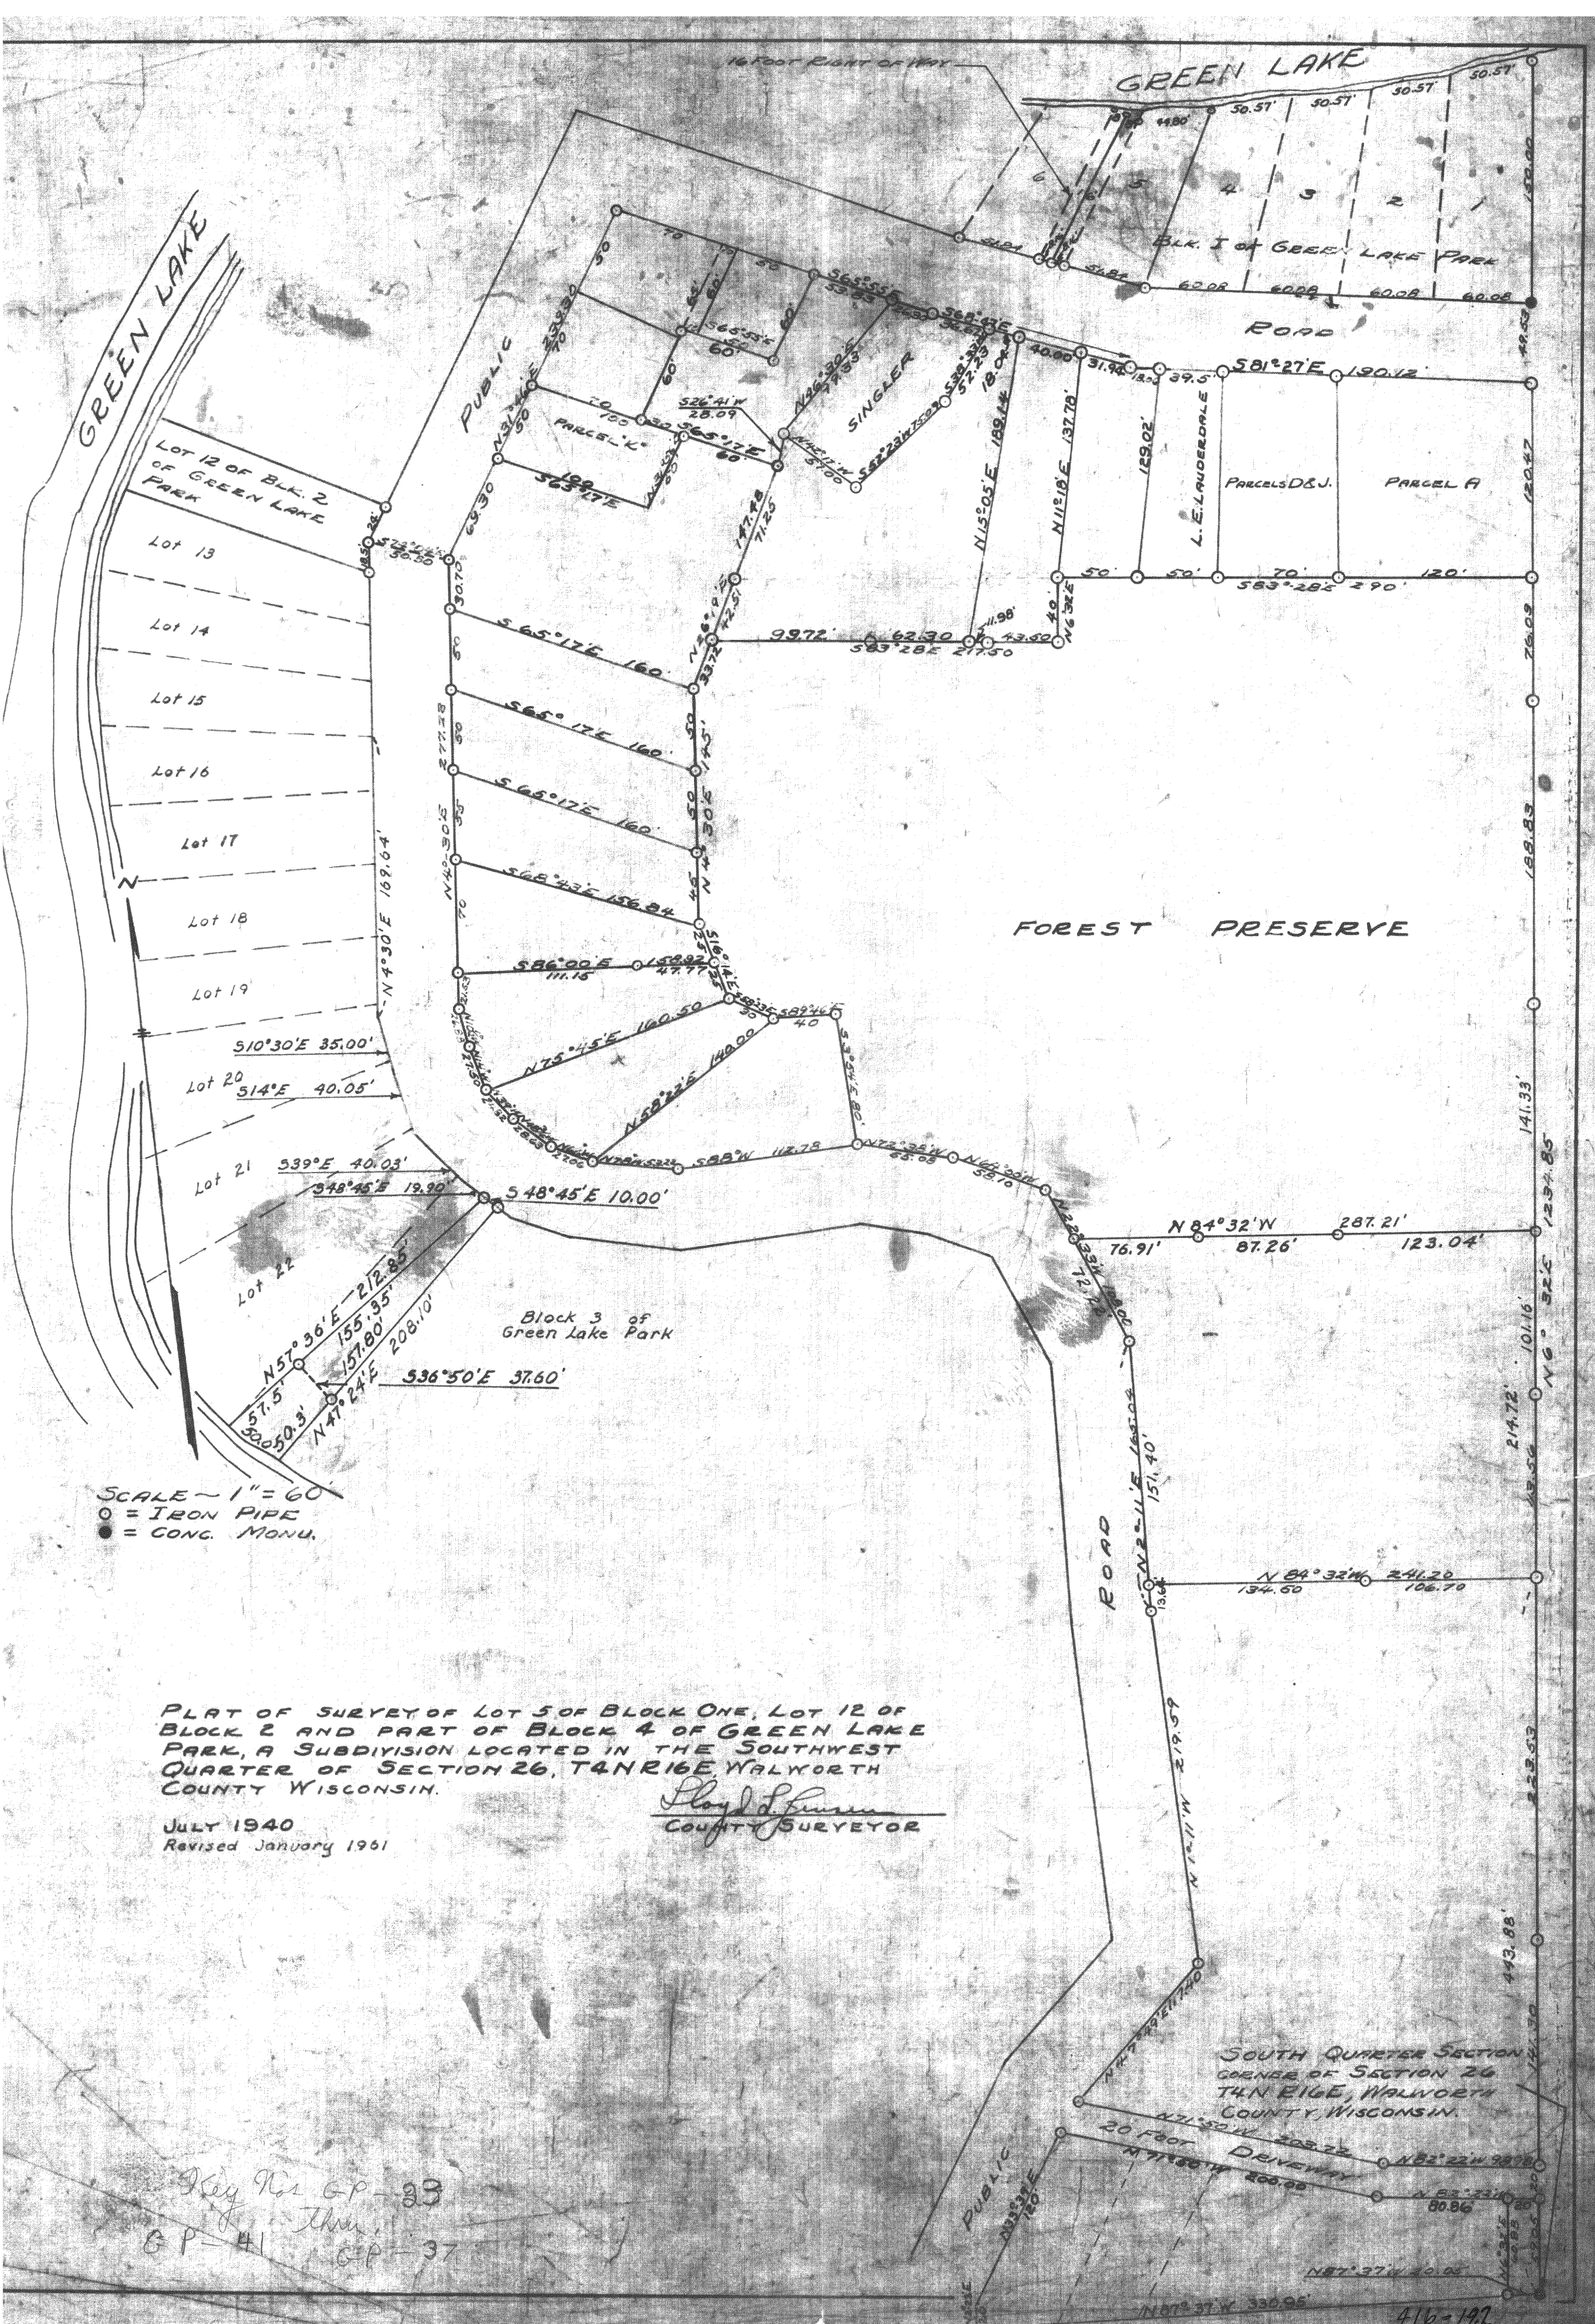

SCALE - 1" = 60'
○ = IRON PIPE
● = CONG. MONU.


JULY 1940
Revised January 1961

Floyd J. Jensen
COUNTY SURVEYOR

Key No. G.P. - 23
G.P. - 41
G.P. - 37

SOUTH QUARTER SECTION 26
CORNER OF SECTION 26
COUNTY WISCONSIN.