
HAROLD H. KOLB

REGISTERED PROFESSIONAL LAND SURVEYOR
LAKE GENEVA, WISCONSIN

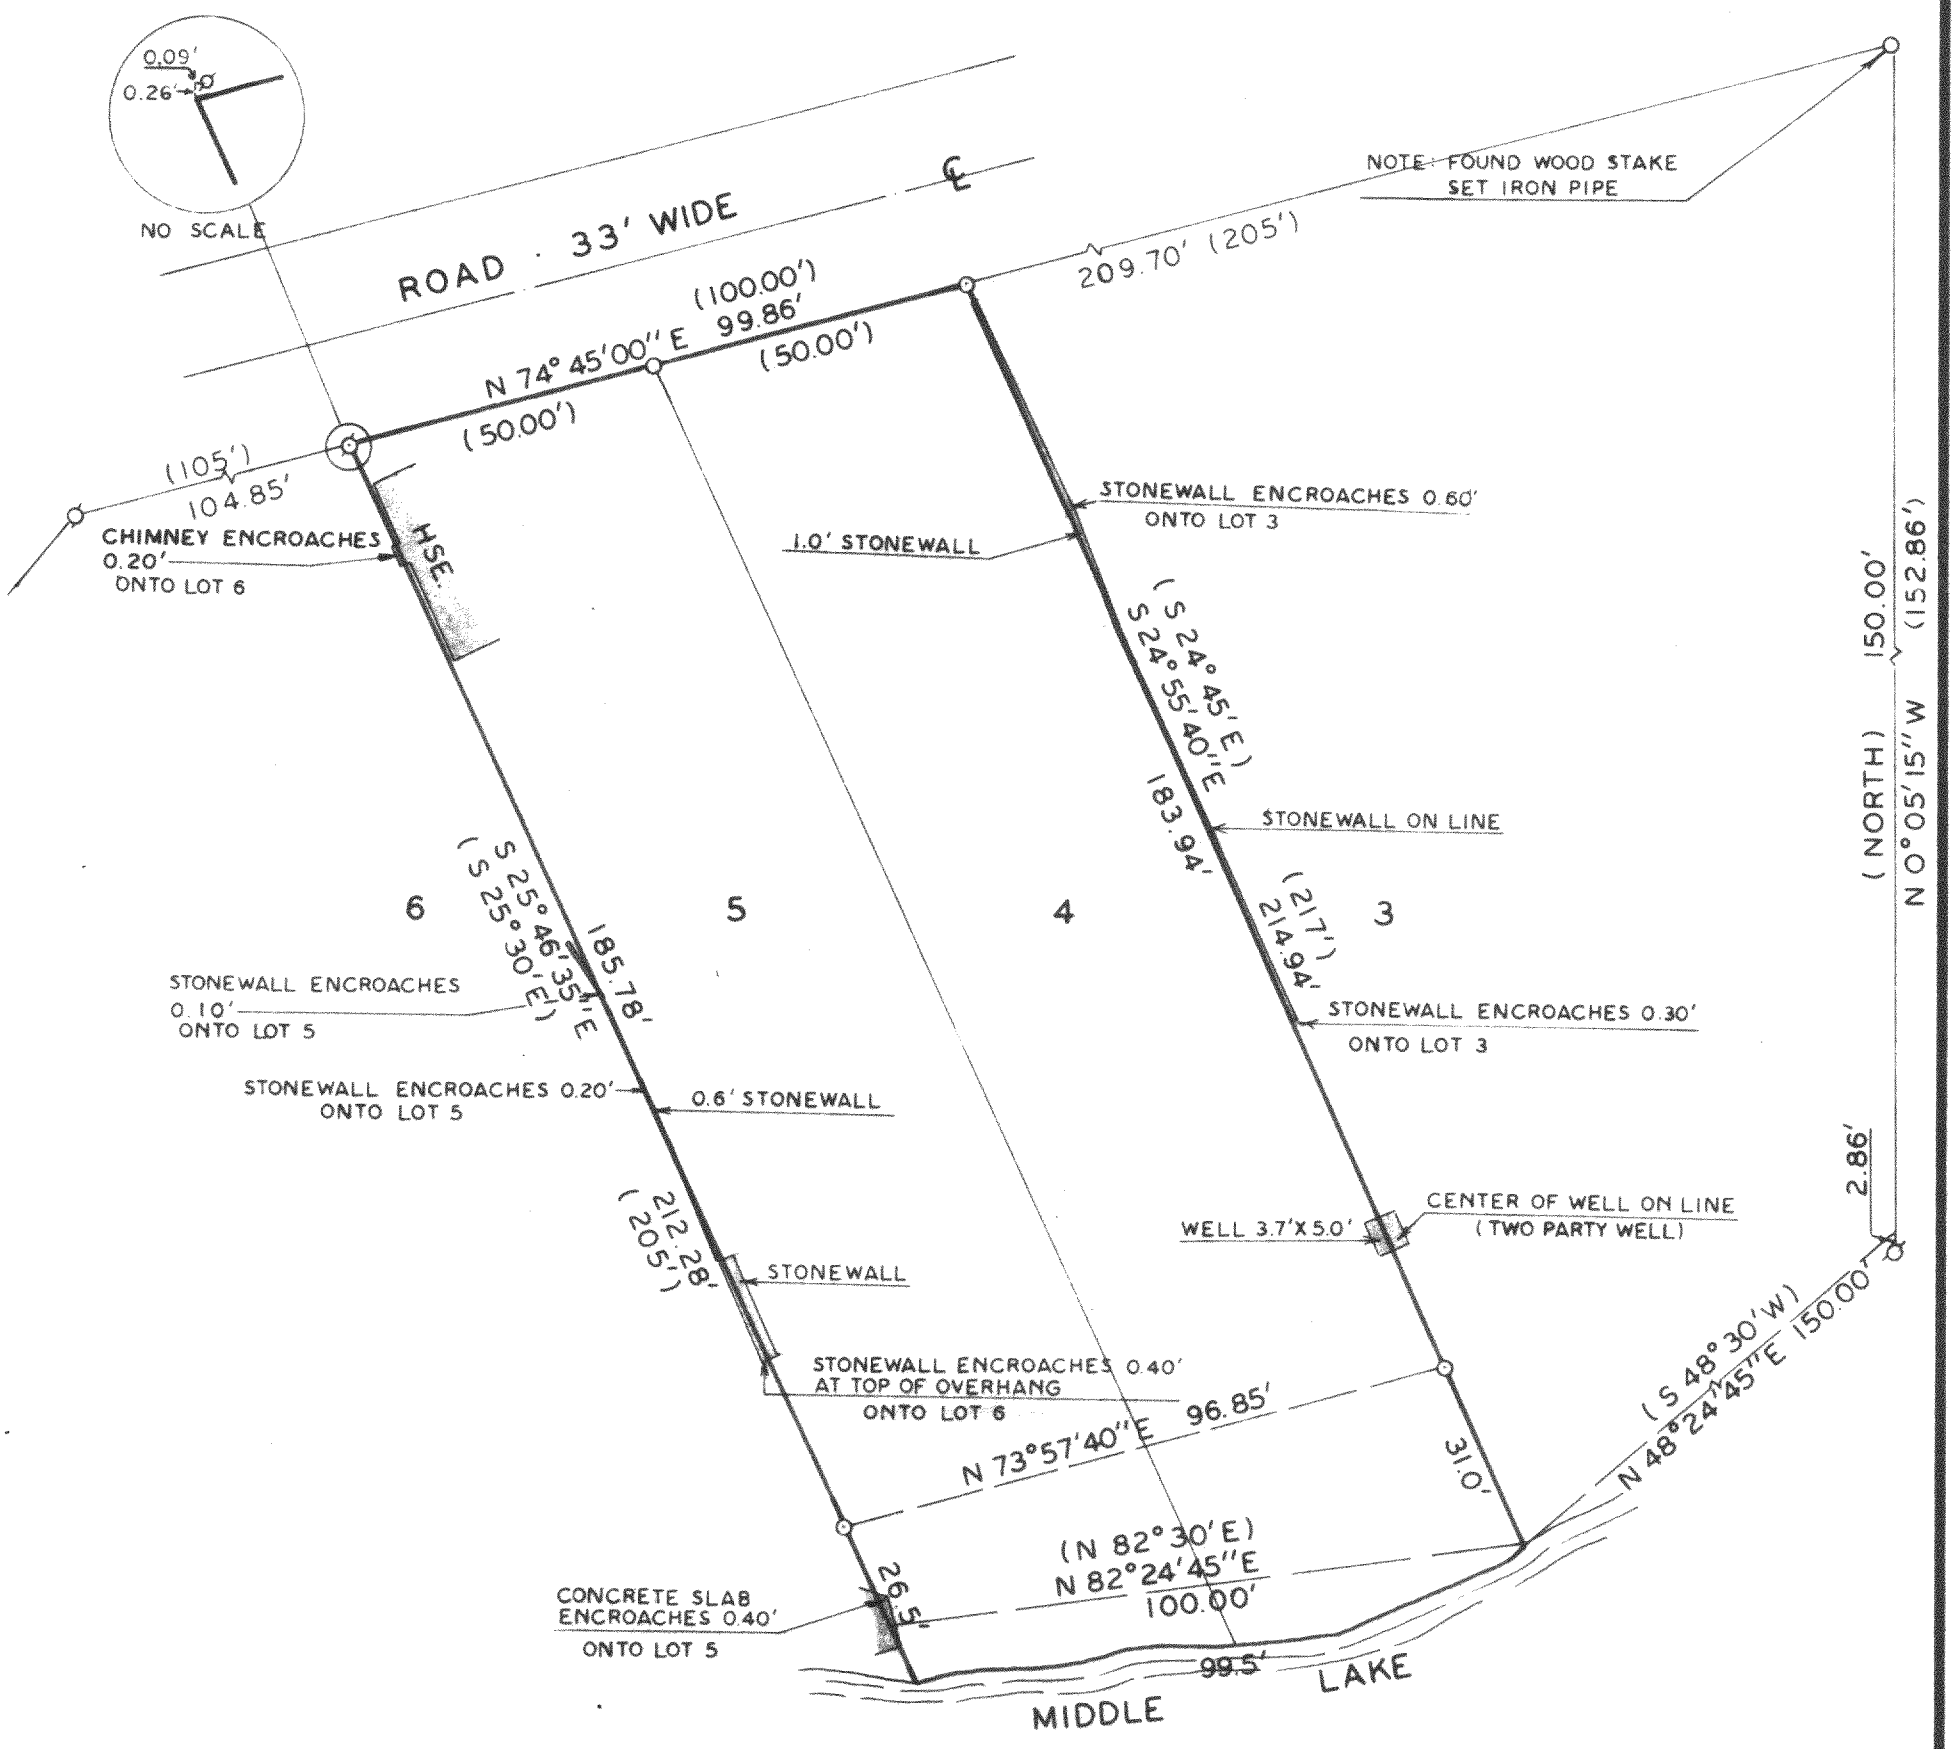

PLAT OF SURVEY OF

LOTS 4 AND 5, OAK PARK SUBDIVISION, T 4 N, R 16 E, WALWORTH COUNTY, WISCONSIN.

NOTE: THE BEARING N 74°45'00" E IS ASSUMED FROM PREVIOUS SURVEY RECORDS.

OWNER: DOROTHY LIDBURRY

ACCURACY: DISTANCE ± 0.01'
ANGLES ± 05"
ERROR OF CLOSURE LESS THAN 1/3000

N

SCALE: 1"=30'

LEGEND

- ϕ — IRON PIPE FOUND
- O — IRON PIPE PLACED
- ● — CONCRETE MONUMENT
- x — SPIKE
- ( ) — AS PLATTED

HAROLD H. KOLB S-187 LAKE GENEVA, WIS. LAND SURVEYOR

I. HAROLD H. KOLB, DO HEREBY CERTIFY THAT I HAVE SURVEYED THE PROPERTY HEREON DESCRIBED ACCORDING TO THE OFFICIAL RECORDS, AND THAT THE PLAT HEREON IS A CORRECT REPRESENTATION OF THE LOT LINES.

Harold H. Kolb

HAROLD H. KOLB
WISCONSIN REGISTERED LAND SURVEYOR, S-187
DATE June 9, 1975

HOP-3

416-197

BRUNING 40-105 500-6-71