
PREPARED FOR:
MIKE SELL
S 70 W23385
MILL BROOK CIRCLE
BIG BEND WI
53103

PLAT OF SURVEY

-OF-

LOT 19 CALI ACRES SUBDIVISION LOCATED IN THE NE1/4 OF THE SW1/4 AND THE NW1/4 OF THE SW1/4 AND THE SW1/4 OF THE SW1/4 AND THE SE1/4 OF THE SW1/4 OF SECTION 35, T4N, R16E, TOWN OF LA GRANGE, WALWORTH COUNTY, WISCONSIN.

J.K. SURVEYING INC.
N3705 WILLOWBEND LANE
LAKE GENEVA, WI, 53147
262-248-3697

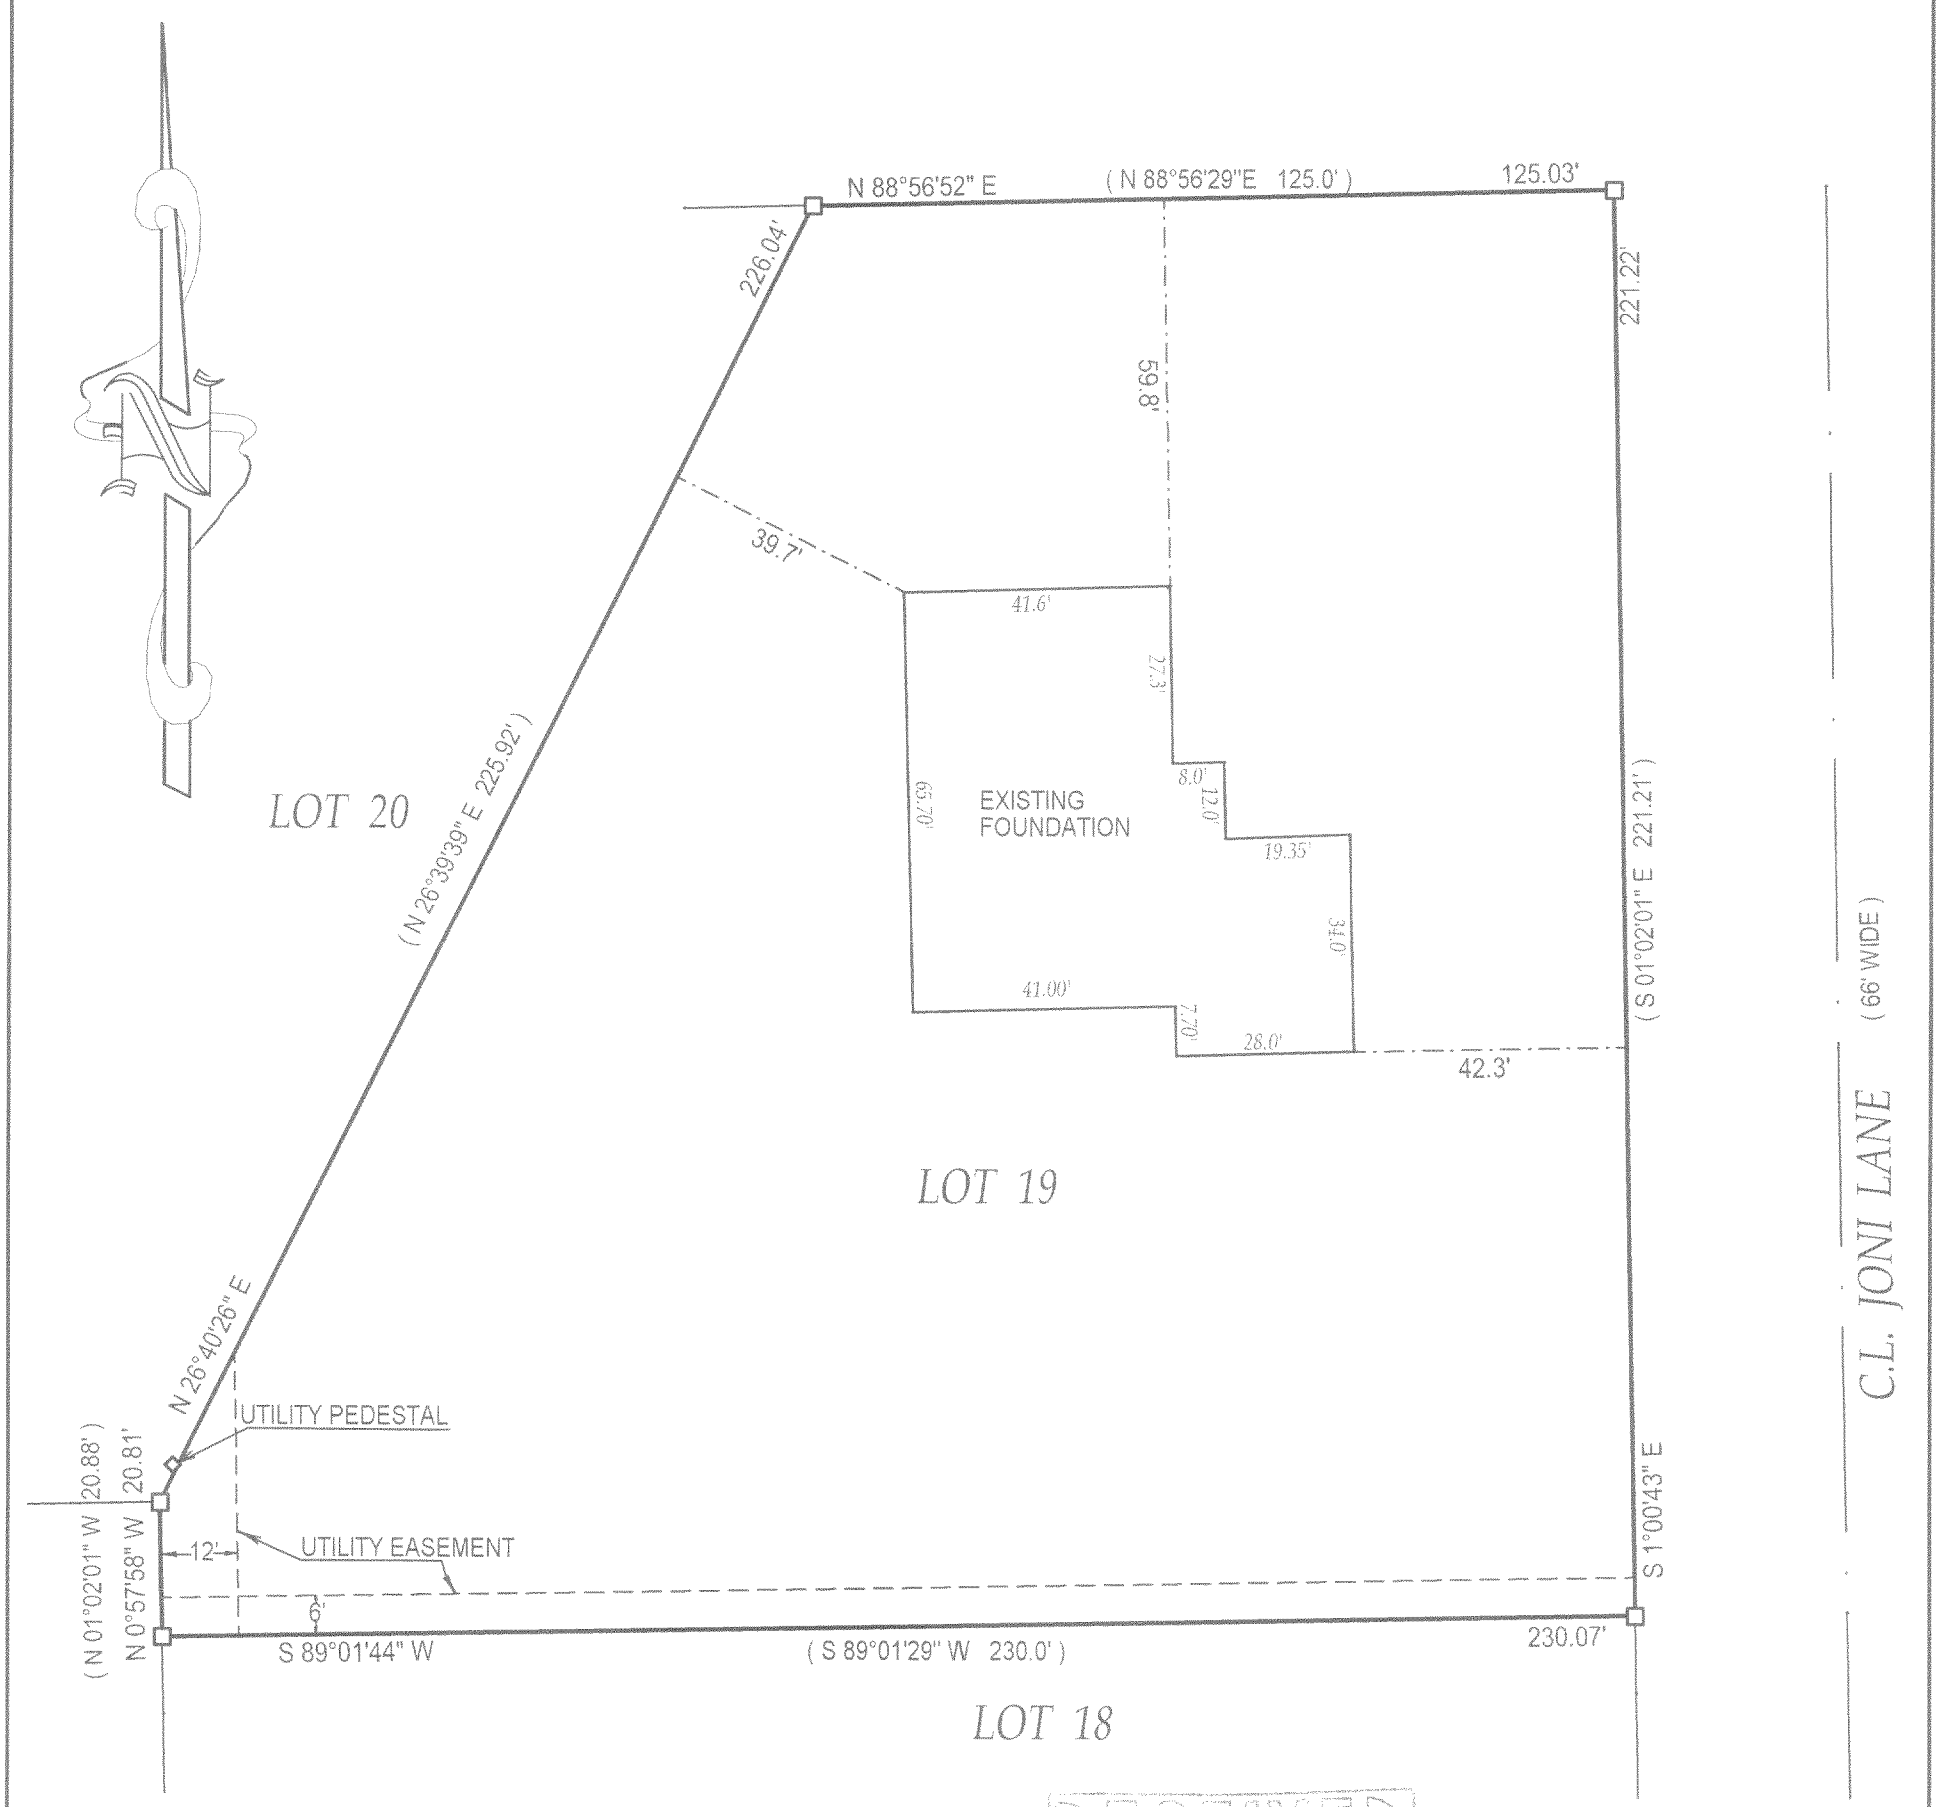

RECEIVED
AUG 1 8 2...

WISCONSIN
JOHN P. KROTT
S-2258
LAKE GENEVA, WIS.
LAND SURVEYOR

( ) = recorded as

□ = found iron bar

○ = found iron pipe

● = set iron pipe

■ = set iron bar

SCALE 1" = 30

JOB # 03-200AB

TAX ID # HC 00019

COMPARE LEGAL DESCRIPTION ABOVE AND DRAWING WITH DEED. FOR BUILDING RESTRICTIONS AND EASEMENTS NOT SHOWN,REFER TO DEED, ABSTRACT SOURCES AND LOCAL MUNICIPAL CODES. NOTIFY THE SURVEYOR IMMEDIATELY OF ANY DISCREPANCY.

"I hereby certify that the above described property was surveyed under my supervision and that the above map is a true representation thereof and shows the size and location of all visible structures, apparent easements and encroachments if any."
This survey is made for the present owners of the property, and those who purchase, mortgage, or guarentee the title thereto, within one year from the date hereof.

DATED THE 23 TH, DAY OF APRIL 2003

DATE OF LAST REVISION: 7 / 08 / 2004

JOHN KROTT S - 2258
Wisconsin Registered Land Surveyor
(original if signed in red)

416-2023