PREPARED FOR:
BASSO BUILDERS
DANNY AND LAURA
JOHNSON PROJECT

PLAT OF SURVEY

- OF -

LOT 2 OF WALNUT HILLS, A SUBDIVISION LOCATED IN THE NE 1\4 OF THE NW 1\4 AND THE NW 1\4 OF THE NE 1\4 AND THE SW 1\4 OF THE NE 1\4 OF SECTION 36, TOWN 4 NORTH, RANGE 16 EAST, WALWORTH COUNTY, WISCONSIN.

J.K. SURVEYING INC.
N3705 WILLOWBEND LANE
LAKE GENEVA, WI, 53147
262-248-3697

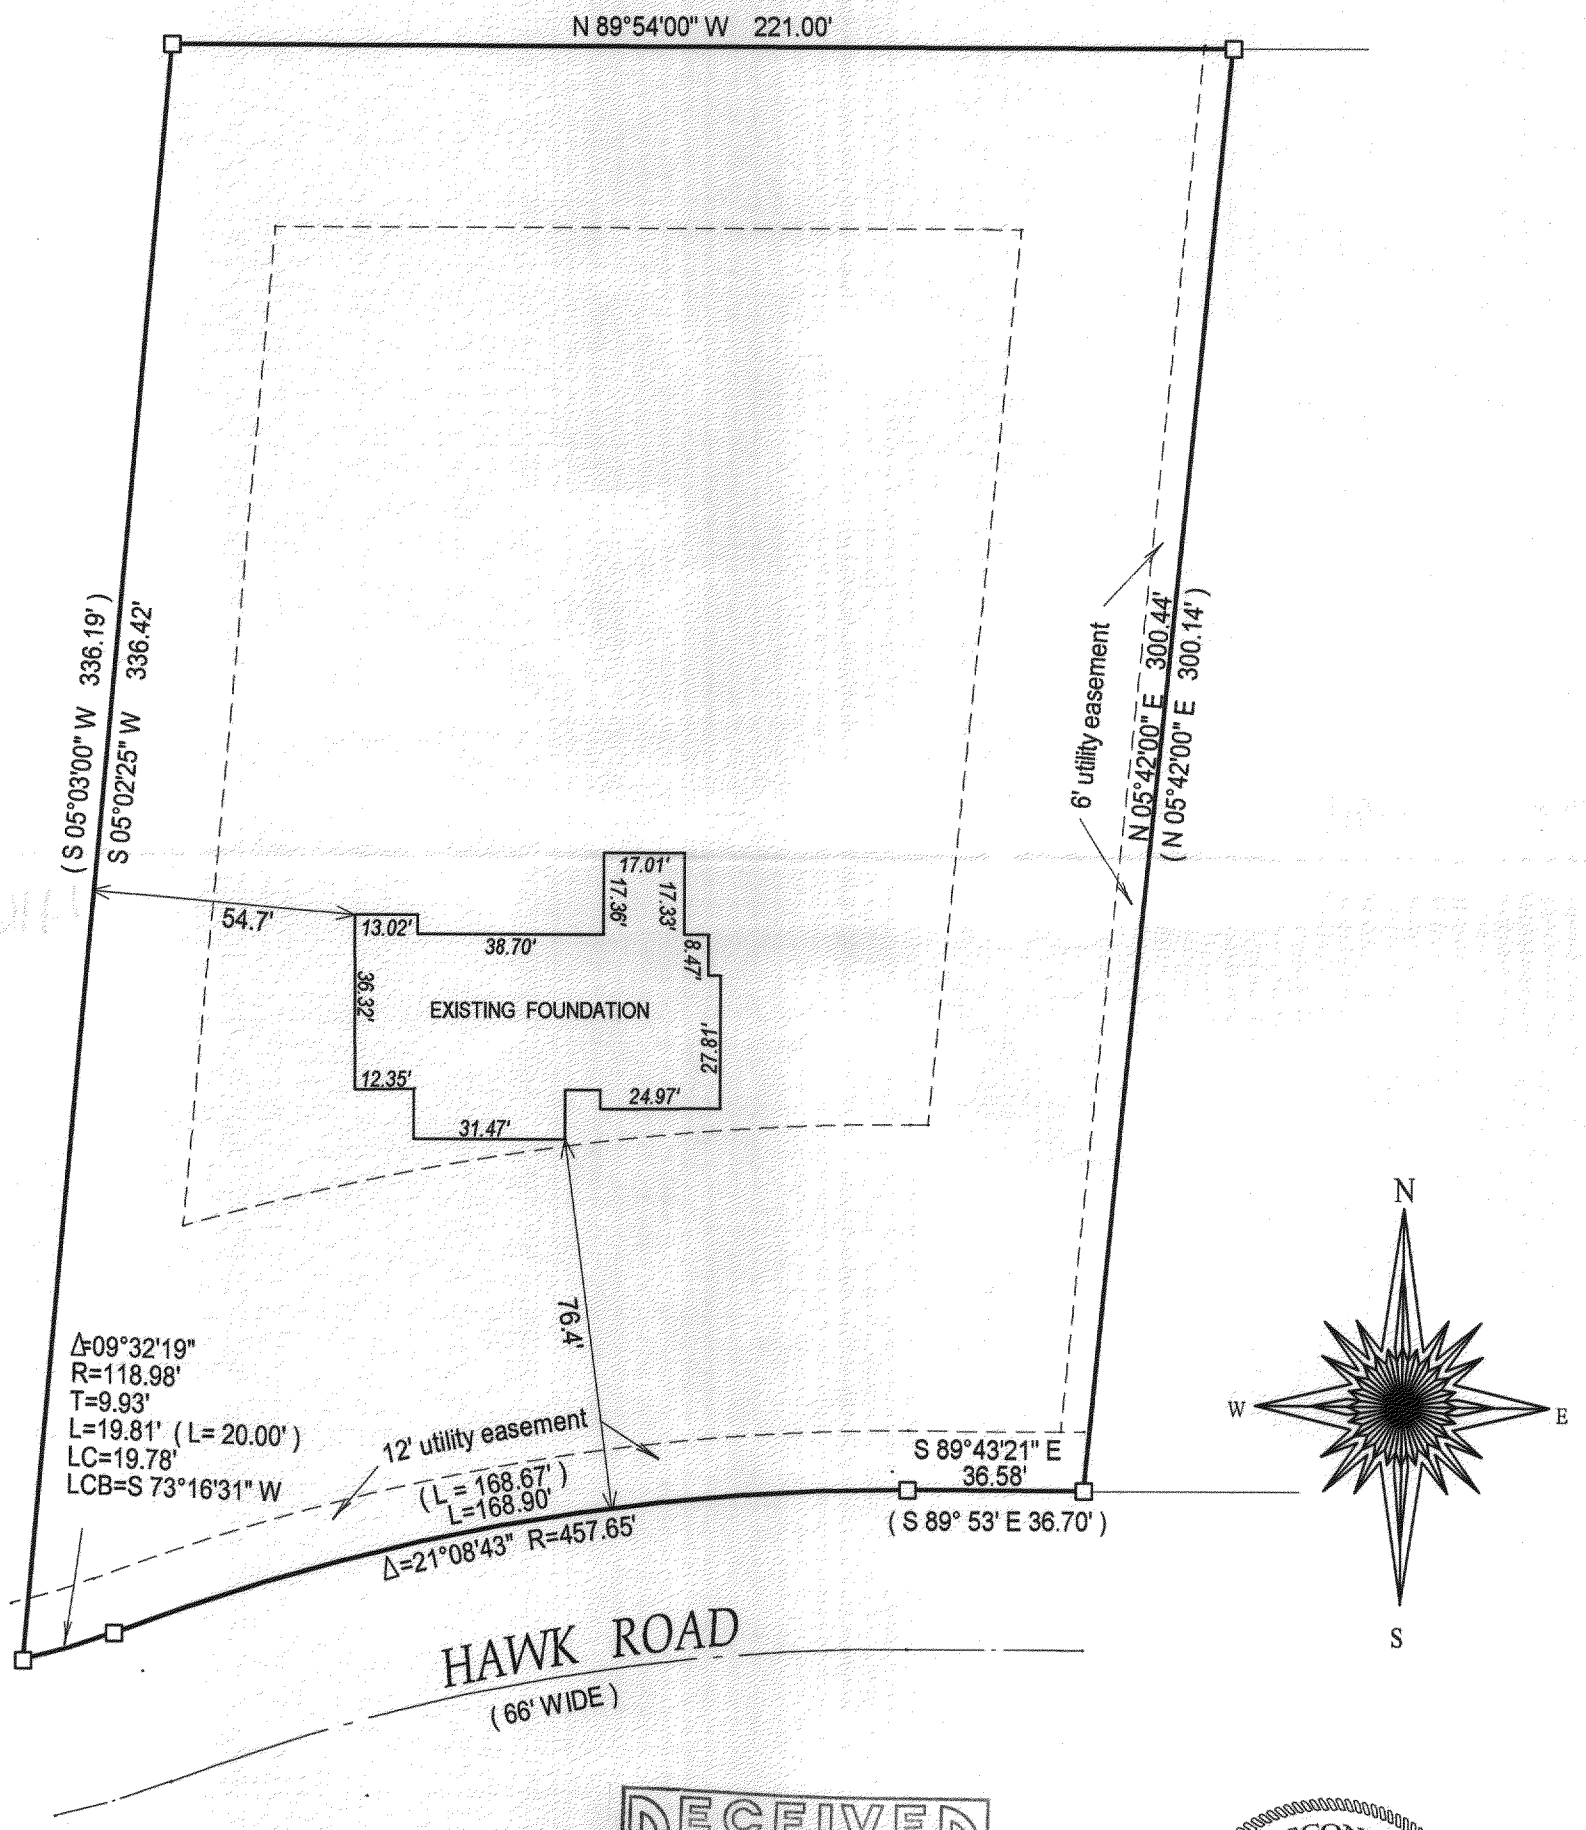

( )= recorded as

□ = found iron bar

○ = found iron pipe

● = set iron pipe

■ = set iron bar

SCALE 1" = 40'

JOB # 03-472AB

TAX ID #HTLW00002

RECEIVED
AUG 13 2004

WISCONSIN
JOHN P.
KROTT
S-2258
LAKE GENEVA
WIS.
LAND SURVEYOR

COMPARE LEGAL DESCRIPTION ABOVE AND DRAWING WITH DEED. FOR BUILDING RESTRICTIONS AND EASEMENTS NOT SHOWN,REFER TO DEED, ABSTRACT SOURCES AND LOCAL MUNICIPAL CODES. NOTIFY THE SURVEYOR IMMEDIATELY OF ANY DISCREPANCY.

"I hereby certify that I have surveyed the above described property and that the above map, to the best of my knowledge and belief, is a true representation thereof and shows the size and location of all visible structures, apparent easements and encroachments if any."
This survey is made for the present owners of the property, and those who purchase, mortgage, or guarantee the title thereto, within one year from the date hereof.

DATE OF LAST REVISION 6-21-04

DATED THIS 8 TH, DAY OF AUGUST 2003 .

JOHN KROTT S - 2258
Wisconsin Registered Land Surveyor
(original if signed in red)

416-2026