


BROOKFIELD, WISCONSIN

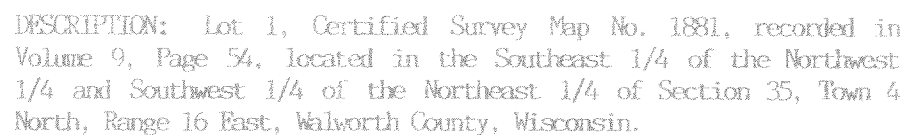

Note: Relative elevations are indicated by underlined figures.

Scale: 1"=50'
OWNER: SCHERER

STATE OF WISCONSIN } ss.
COUNTY OF WAUKESHA }

I HAVE SURVEYED THE ABOVE DESCRIBED PROPERTY AND THE ABOVE MAP IS A TRUE REPRESENTATION THEREOF AND SHOWS THE SIZE AND LOCATION OF THE PROPERTY, ITS EXTERIOR BOUNDARIES, THE LOCATION AND DIMENSIONS OF ALL VISIBLE STRUCTURES THEREON, FENCES, APPARENT EASEMENTS AND ROADWAYS AND VISIBLE ENCROACHMENTS, IF ANY.

THIS SURVEY IS MADE FOR THE EXCLUSIVE USE OF THE PRESENT OWNERS OF THE PROPERTY, AND ALSO THOSE WHO PURCHASE, MORTGAGE, OR GUARANTEE THE TITLE THERETO WITHIN ONE (1) YEAR FROM DATE HEREOF. *And resurveyed 4/26/05. EQ. 71*

DATED AT Brookfield, THIS 27TH DAY OF January, 2005. SIGNED: Edward A. Husler

REGISTERED WISCONSIN LAND SURVEYOR NO. 1185

#6771-R

JRS CONST.