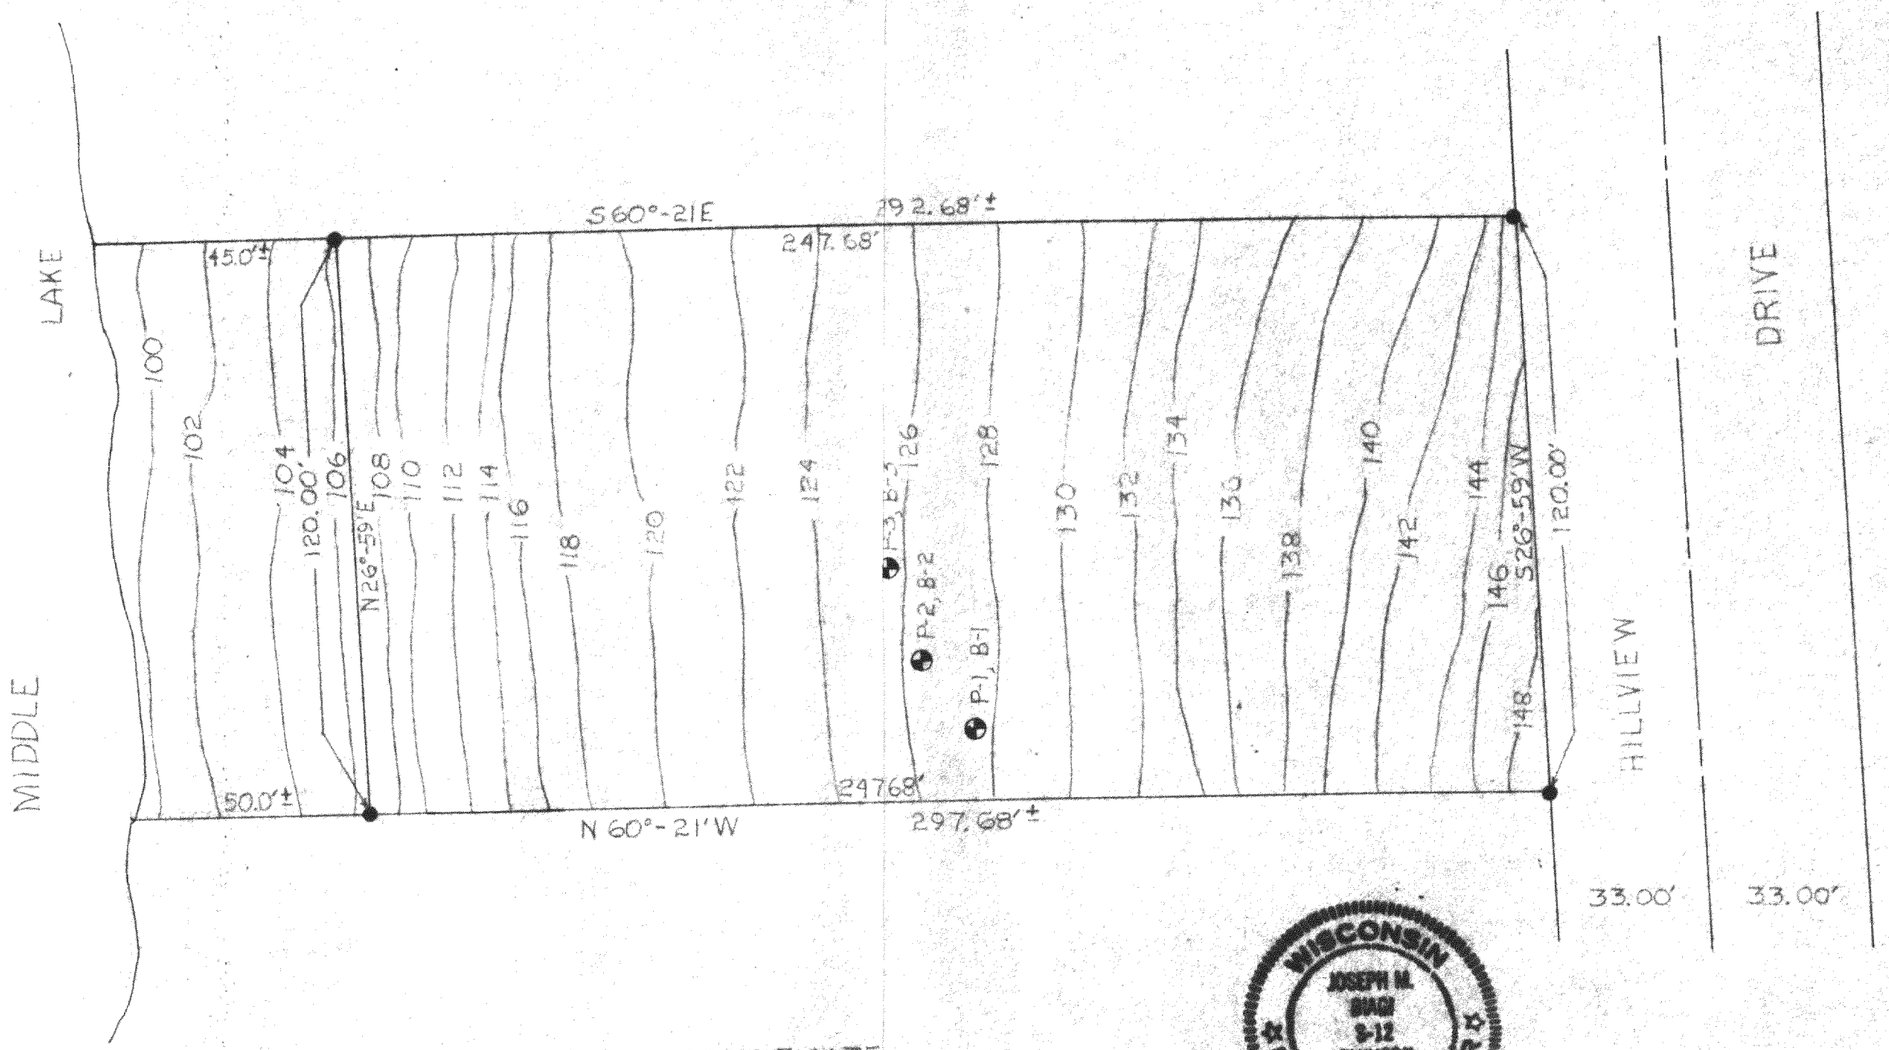

DESCRIPTION:

LOT 10 IN HILLVIEW PARK, LAGRANGE TOWNSHIP, WALWORTH COUNTY, WISCONSIN

LEGEND

- ● IRON PIPE FOUND
- ⊕ SOIL BORING AND PERCOLATION TEST LOCATION

CERTIFICATE:

I, JOSEPH M. BIAGI, SURVEYOR, DO HEREBY CERTIFY THAT I HAVE SURVEYED THE LANDS HEREON DESCRIBED.

JOSEPH M. BIAGI R.L.S.# 12

WISCONSIN JOSEPH M. BIAGI S-12 ELKHORN WIS. LAND SURVEYOR

DATE: AUGUST 11, 1975

REVISIONS			A. SIDHU		
NO.	DATE	BY	LOT 10 HILLVIEW SUB. (TOPO MAP)		
1					
2					
3			DRAWN BY HWG	SCALE 1" = 30'	MATERIAL
4			CHK'D	DATE 8-11-75	DRAWING NO. 75-75
5			TRACED	APP'D	

HHV-10

416-216

TELEDYNE POST 18AE-10E—12X18