HAROLD H. KOLB
REGISTERED LAND SURVEYOR
TWIN BUILDING
LAKE GENEVA, WIS. 53147

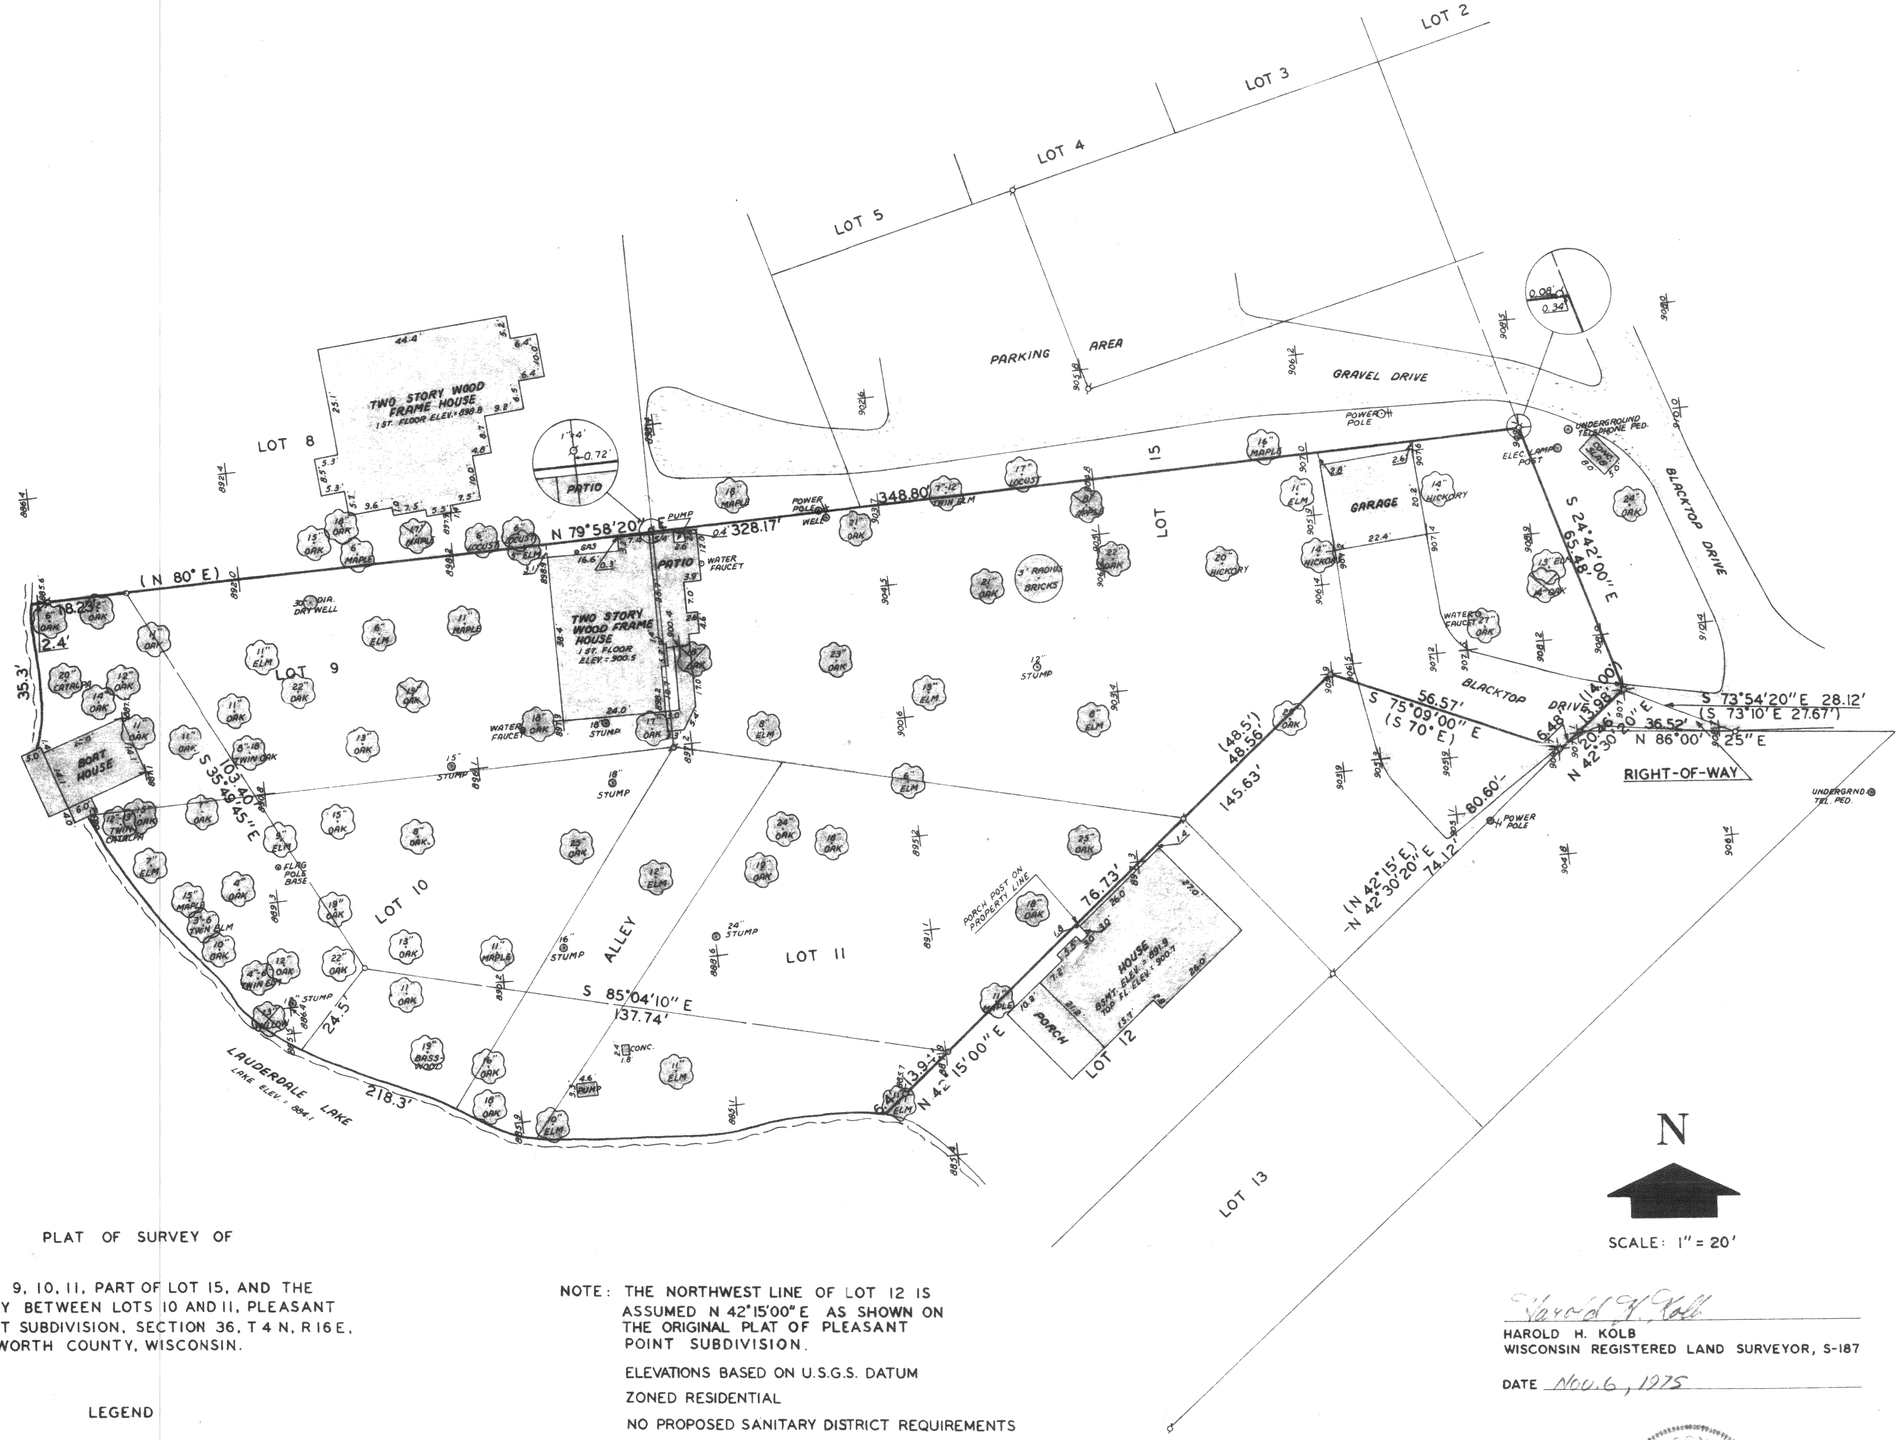

PLAT OF SURVEY OF

LOTS 9, 10, 11, PART OF LOT 15, AND THE ALLEY BETWEEN LOTS 10 AND 11, PLEASANT POINT SUBDIVISION, SECTION 36, T 4 N, R 16 E, WALWORTH COUNTY, WISCONSIN.

LEGEND

ø — IRON PIPE FOUND
o — IRON PIPE PLACED
( ) — RECORDED AS
⊗ — PARTIALLY DEAD TREE

NOTE: THE NORTHWEST LINE OF LOT 12 IS ASSUMED N 42°15'00" E AS SHOWN ON THE ORIGINAL PLAT OF PLEASANT POINT SUBDIVISION.

ELEVATIONS BASED ON U.S.G.S. DATUM

ZONED RESIDENTIAL

NO PROPOSED SANITARY DISTRICT REQUIREMENTS

SCALE: 1" = 20'

Harold H. Kolb

HAROLD H. KOLB
WISCONSIN REGISTERED LAND SURVEYOR, S-187

DATE Nov. 6, 1975

WISCONSIN
HAROLD H.
KOLB
S-187

HPP-4, 5 and 9 Topo MAP

416-220