
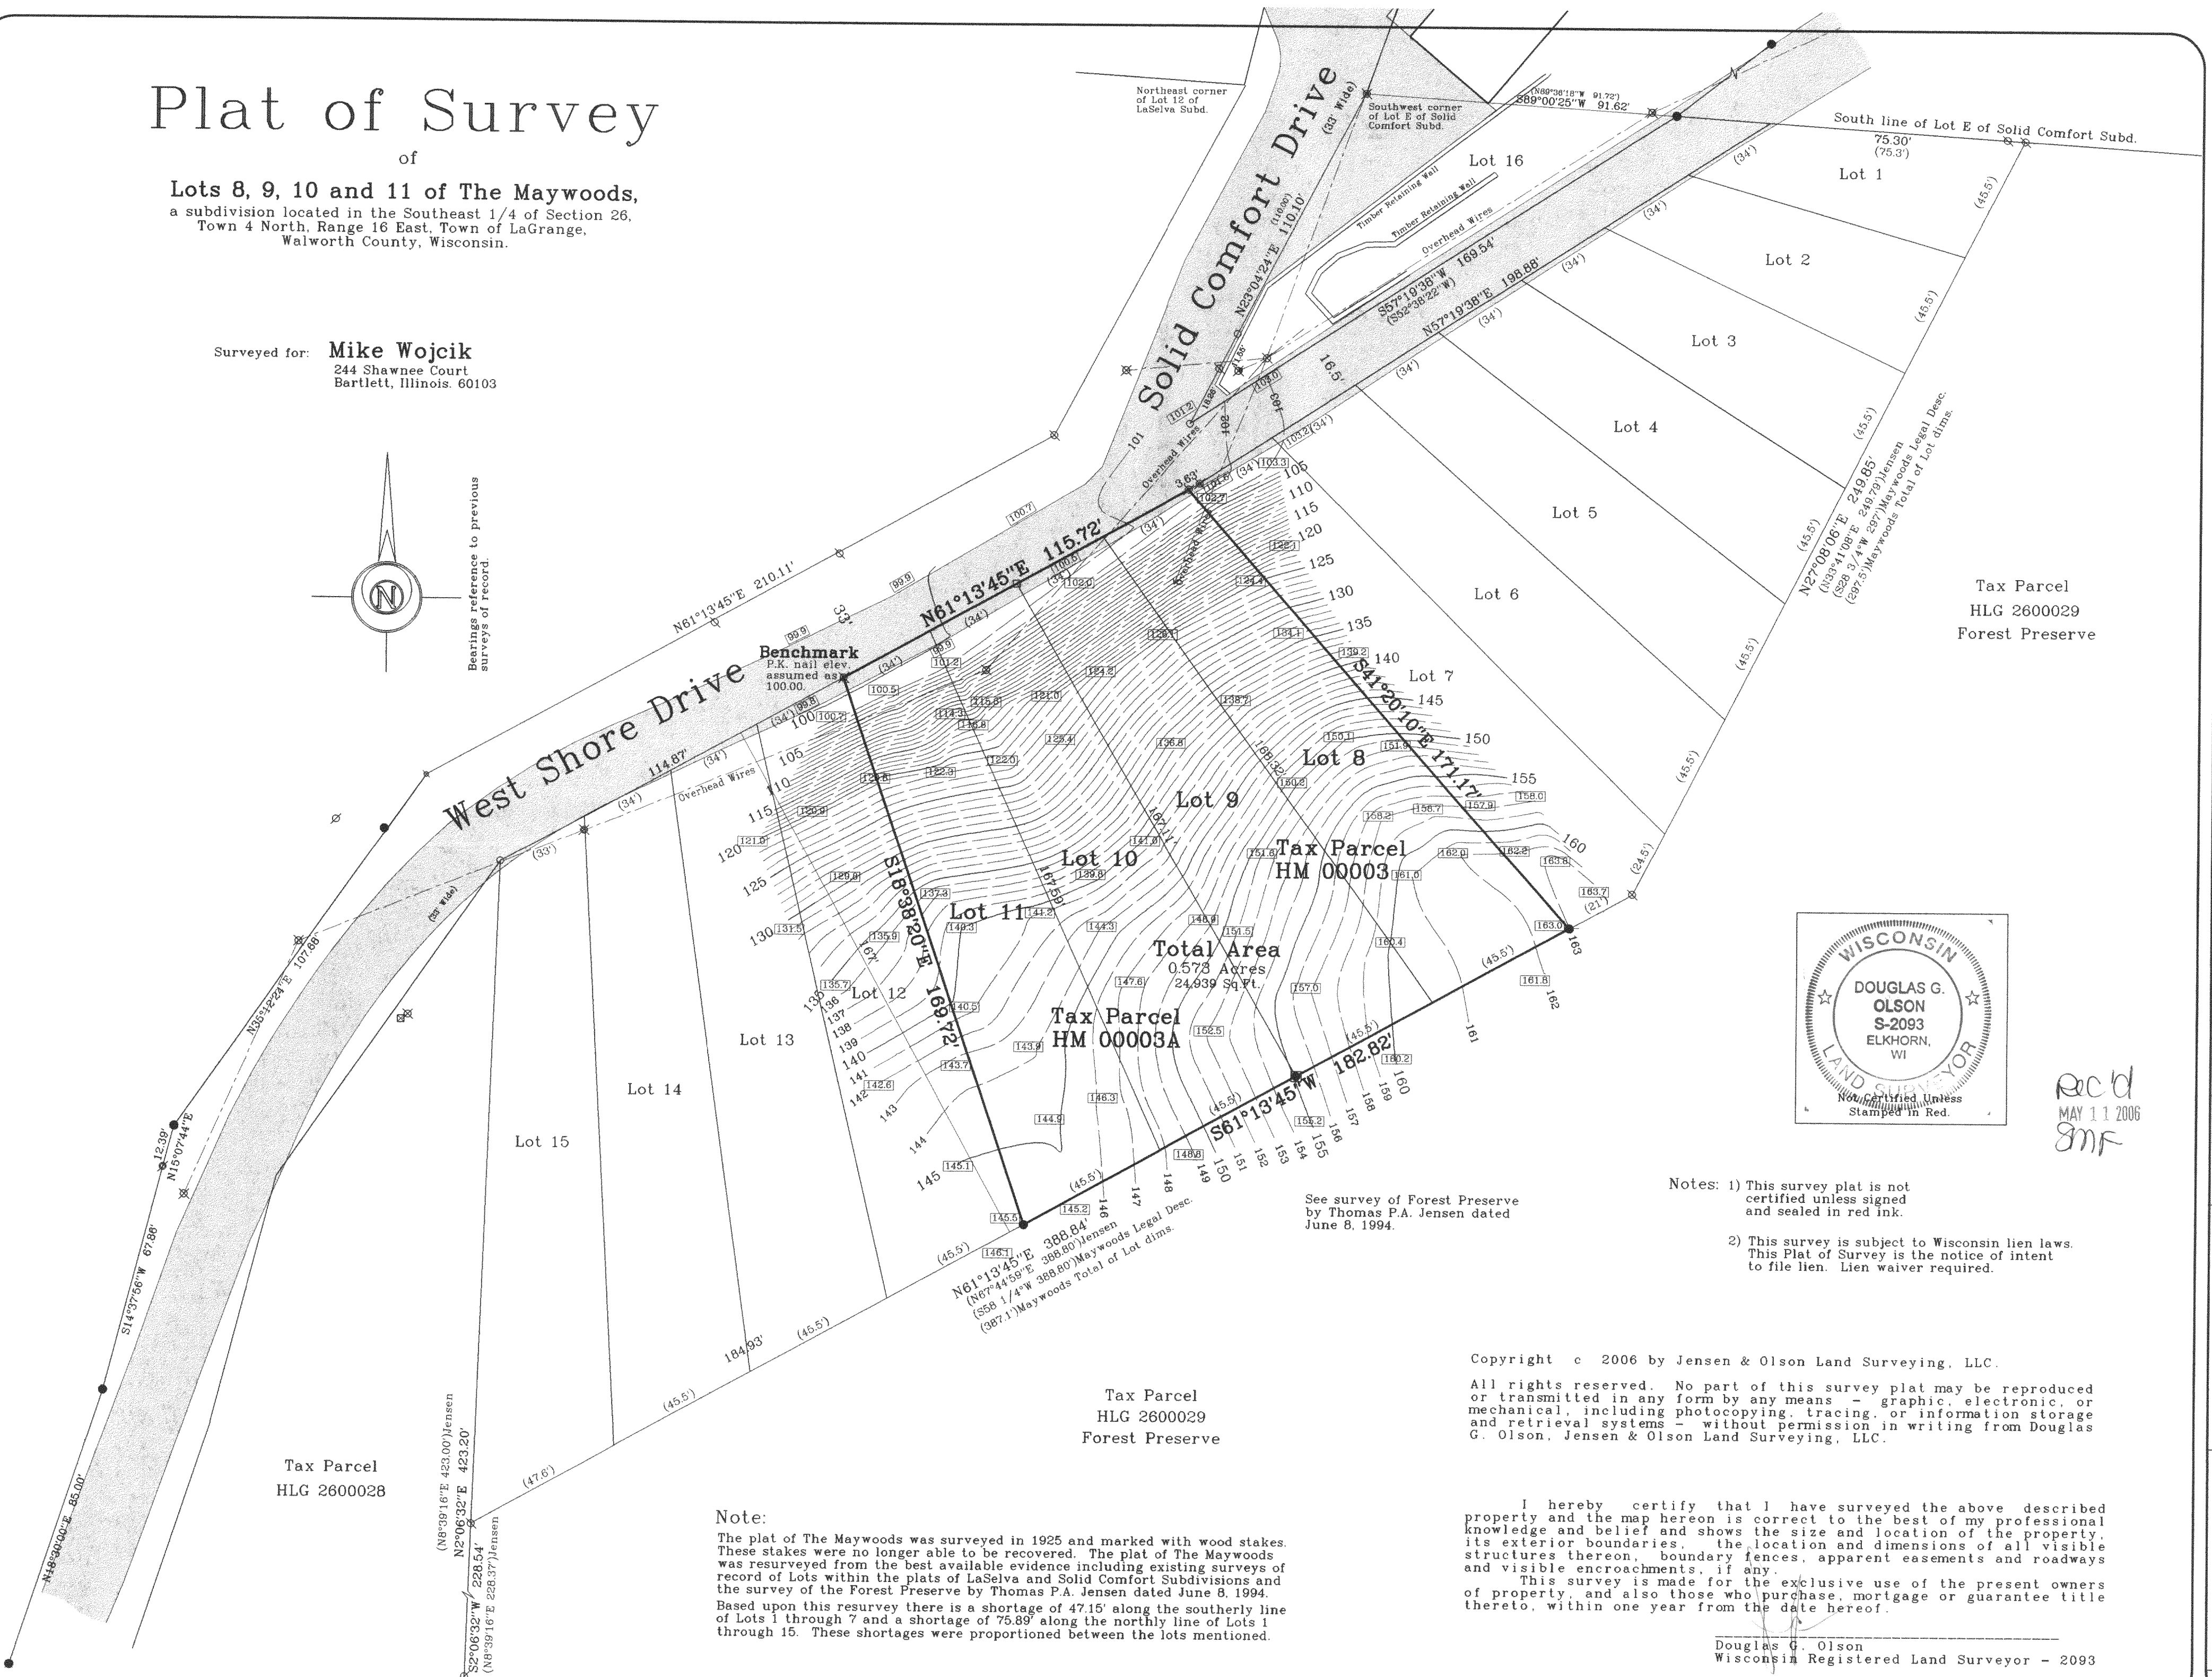



Plat of Survey

of
Lots 8, 9, 10 and 11 of The Maywoods,
a subdivision located in the Southeast 1/4 of Section 26,
Town 4 North, Range 16 East, Town of LaGrange,
Walworth County, Wisconsin.

Surveyed for: **Mike Wojcik**
244 Shawnee Court
Bartlett, Illinois 60103

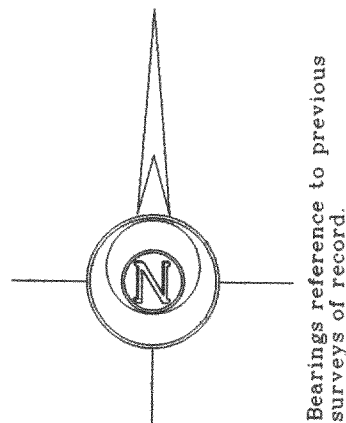

Survey Date: May 26, 2005.
Revisions: No. 1 - Contours

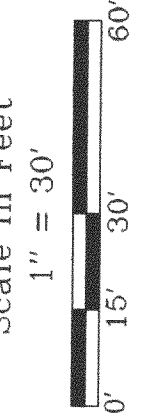

Jensen & Olson Land Surveying, LLC
45 South Wisconsin Street
Elkhorn, Wisconsin 53121
Telephone (262) 723-3434
Facsimile (262) 723-8044



Legend
● Found Iron Pipe
● Found Iron Rod
● Found Railroad Spike
● Found F.N. Nail
● Found F.N. Rod 3/4\"/>

Sheet 1 of 1 Sheets
Job Reference Number
2006.041

2006.041

HM-3 HM-3A

416-2202