PLat of Survey


~of~

Lot 2 of Certified Survey Map # 1430 Located in the NW 1/4 of the NE 1/4 and part of Government Lot 2 of Section 25, T4N, R16E, Town of LaGrange, Walworth County, Wisconsin.

Surveyed By: Jensen Surveying & Mapping S.C.
45 S Wis. St P.O. Box 322
Elkhorn, WI. 53121

Surveyed For: Mike Baker
417 E 1st Ave
Elkhorn, WI 53121

RECEIVED
OCT - 4 1985

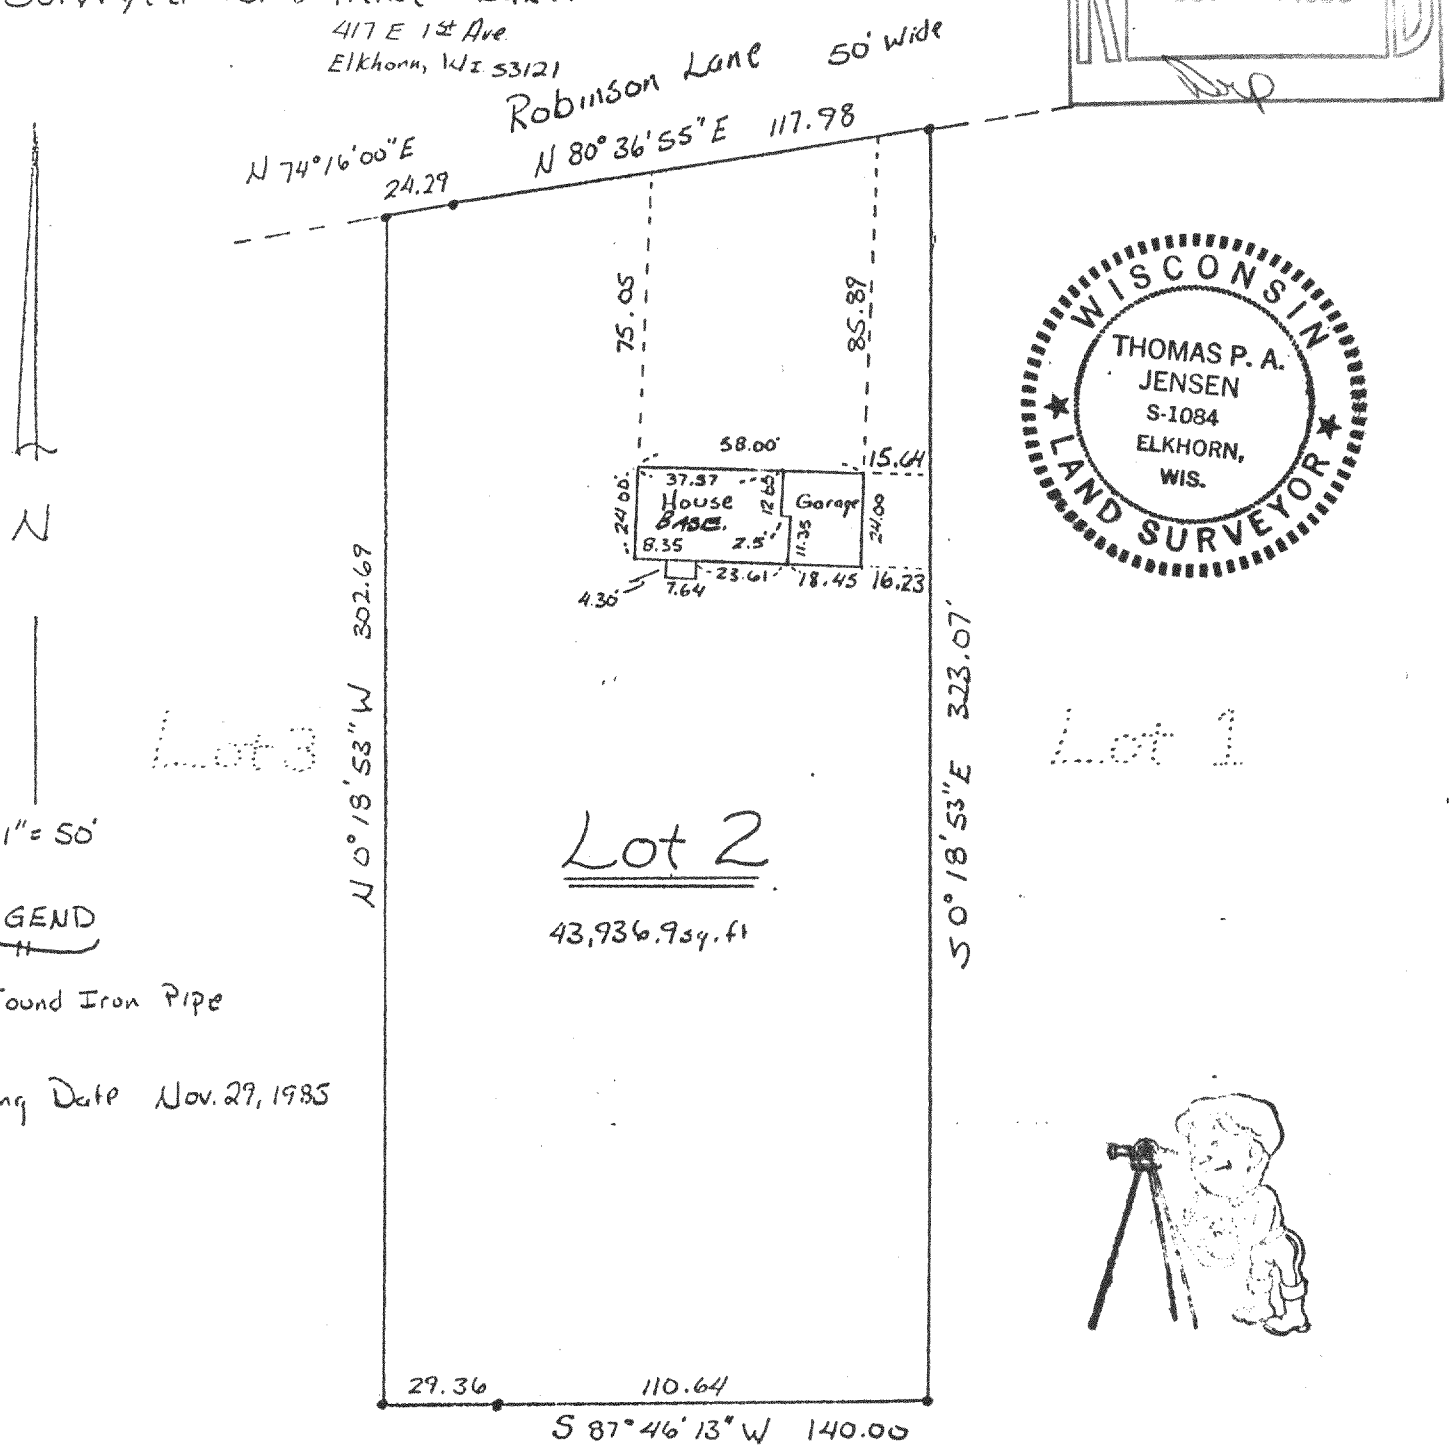

WISCONSIN
THOMAS P. A. JENSEN
S-1084
ELKHORN, WIS.
LAND SURVEYOR

Scale 1" = 50'

LEGEND

o ~ Found Iron Pipe

Mapping Date Nov. 29, 1985

I, Thomas P.A. Jensen, Wisconsin Registered Land Surveyor, do hereby certify that this survey was performed by me, or under my direction, in full compliance with the owner's/agent's instructions and chapter A-E 5 of the Wisconsin Administrative Code "Minimum Standards For Property Surveys"; and that this map is an accurate representation thereof to the best of my knowledge and belief.

Thomas P.A. Jensen S-1084
Jensen Surveying & Mapping S.C.
45 S. Wisconsin St.
Elkhorn, Wisconsin. 53121
(414) 723-3434

416-392
1985.105X