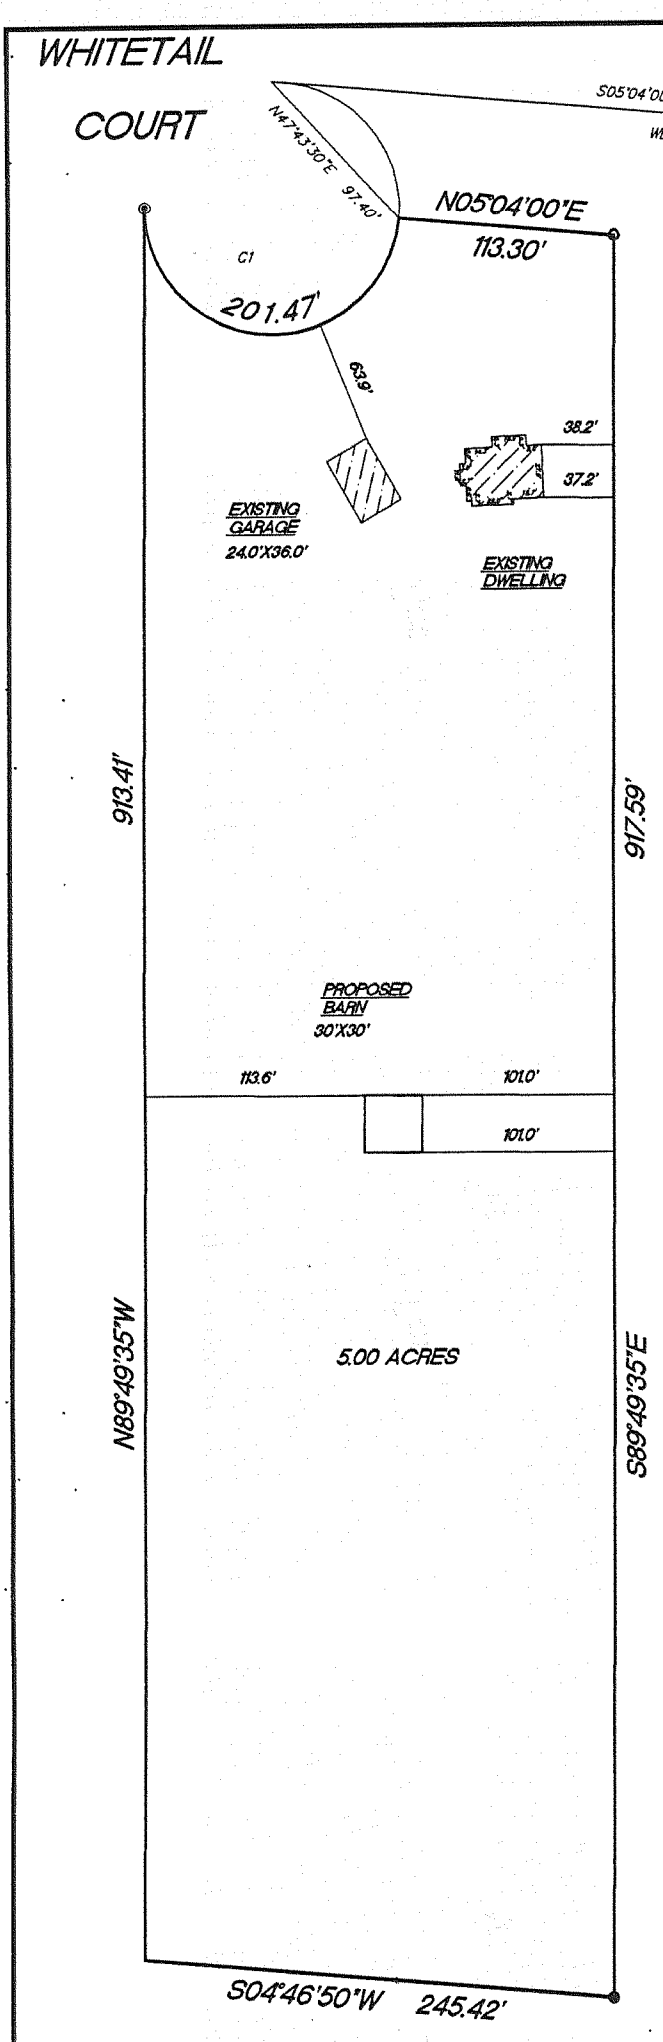


PLAT OF SURVEY

LOT 2, CERTIFIED SURVEY MAP NO. 2682, being a redivision of Lot 3, Certified Survey Map No. 1279, being a part of the Southeast ¼ and the Southwest ¼ of Section 11, Town 4 North, Range 16 East, Town of LaGrange, Walworth County, Wisconsin.

Surveyed for: Jeff and Kathy Richter


Survey address: W5494 Whitetail Trail

RECEIVED
OCT 12 2006
SMF

SCALE 1"=100'

RADIUS	LENGTH	CHORD	BEARING	DELTA
66.00'	201.47'	131.87'	N02°43'26"E	174°53'58"

MONUMENTATION WAS WAIVED BY CLIENT IN ACCORDANCE WOTH A-E 7.01(2) OF THE WISCONSIN ADMINISTRATIVE CODE.

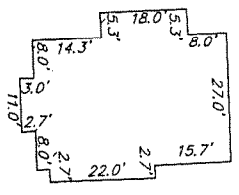

HOUSE DETAIL


SCALE 1"=40'

- FOUND 1" IRON PIPE
- FOUND 3/4" IRON PIN
- FOUND 1 5/8" IRON PIPE

"I hereby certify that I have surveyed the above described property and that the above map is a true representation thereof and shows the size and location of the property, its exterior boundaries, the location of all visible structures and dimension of all principal buildings thereon, boundary fences, apparent easements, roadways and encroachments if any."

"This survey is made for the use of the present owners of the property, and also those who purchase, mortgage or guarantee the title thereto within one year from date hereof."

KETTLE MORAINE SURVEYING INC.
W356 S9050 Godfrey Lane
Eagle Wisconsin 53119
P.O. Box 357
(262) 594-3484
Terrance E. Pisarek R.L.S.

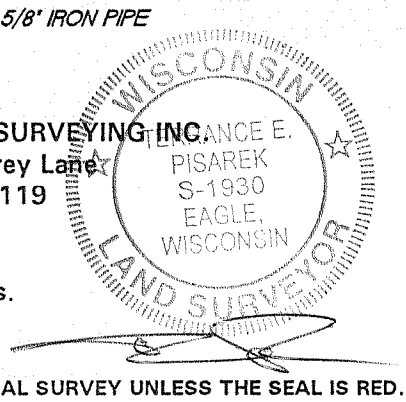

THIS IS NOT AN ORIGINAL SURVEY UNLESS THE SEAL IS RED.

10/1/06	TEP	TEP	06141
DATE	FIELD WORK BY	DRAWN BY	JOB NUMBER

HA2682-2

416-2233