

PLAT OF SURVEY
LOT 53 AND PART OF LOTS 54 AND 55 OF
LAUDERDALE HEIGHTS
LOCATED IN PART OF THE SOUTHWEST 1/4 OF SECTION 36,
TOWN 4 NORTH, RANGE 16 EAST, TOWN OF LAGRANGE,
WALWORTH COUNTY, WISCONSIN

LEGAL DESCRIPTION:



Parcel I: Lot 53 and Lot 54, Lauderdale Heights, T. 4 N. R. 16 E., Walworth County, Wisconsin, excepting from Lot 54 the following described portion: Commencing at the Southeast corner of Lot 53, thence Northwesterly along the Southeast line of said Lot 53, 10 feet to the place of beginning; thence Northeast at right angles to the lot line 10 feet to the Southeast corner of Lot 54, thence Northwesterly along the lot line 30 feet to the place of beginning.

Parcel II: That part of Lot 55, Lauderdale Heights, T. 4 N. R. 16 E., Walworth County, Wisconsin, commencing at the Southeast corner of Lot 53, thence Northwesterly along the lot line 30 feet to the place of beginning; 





(Tax Map No. 8 HLD 00016 and HLD 00017)


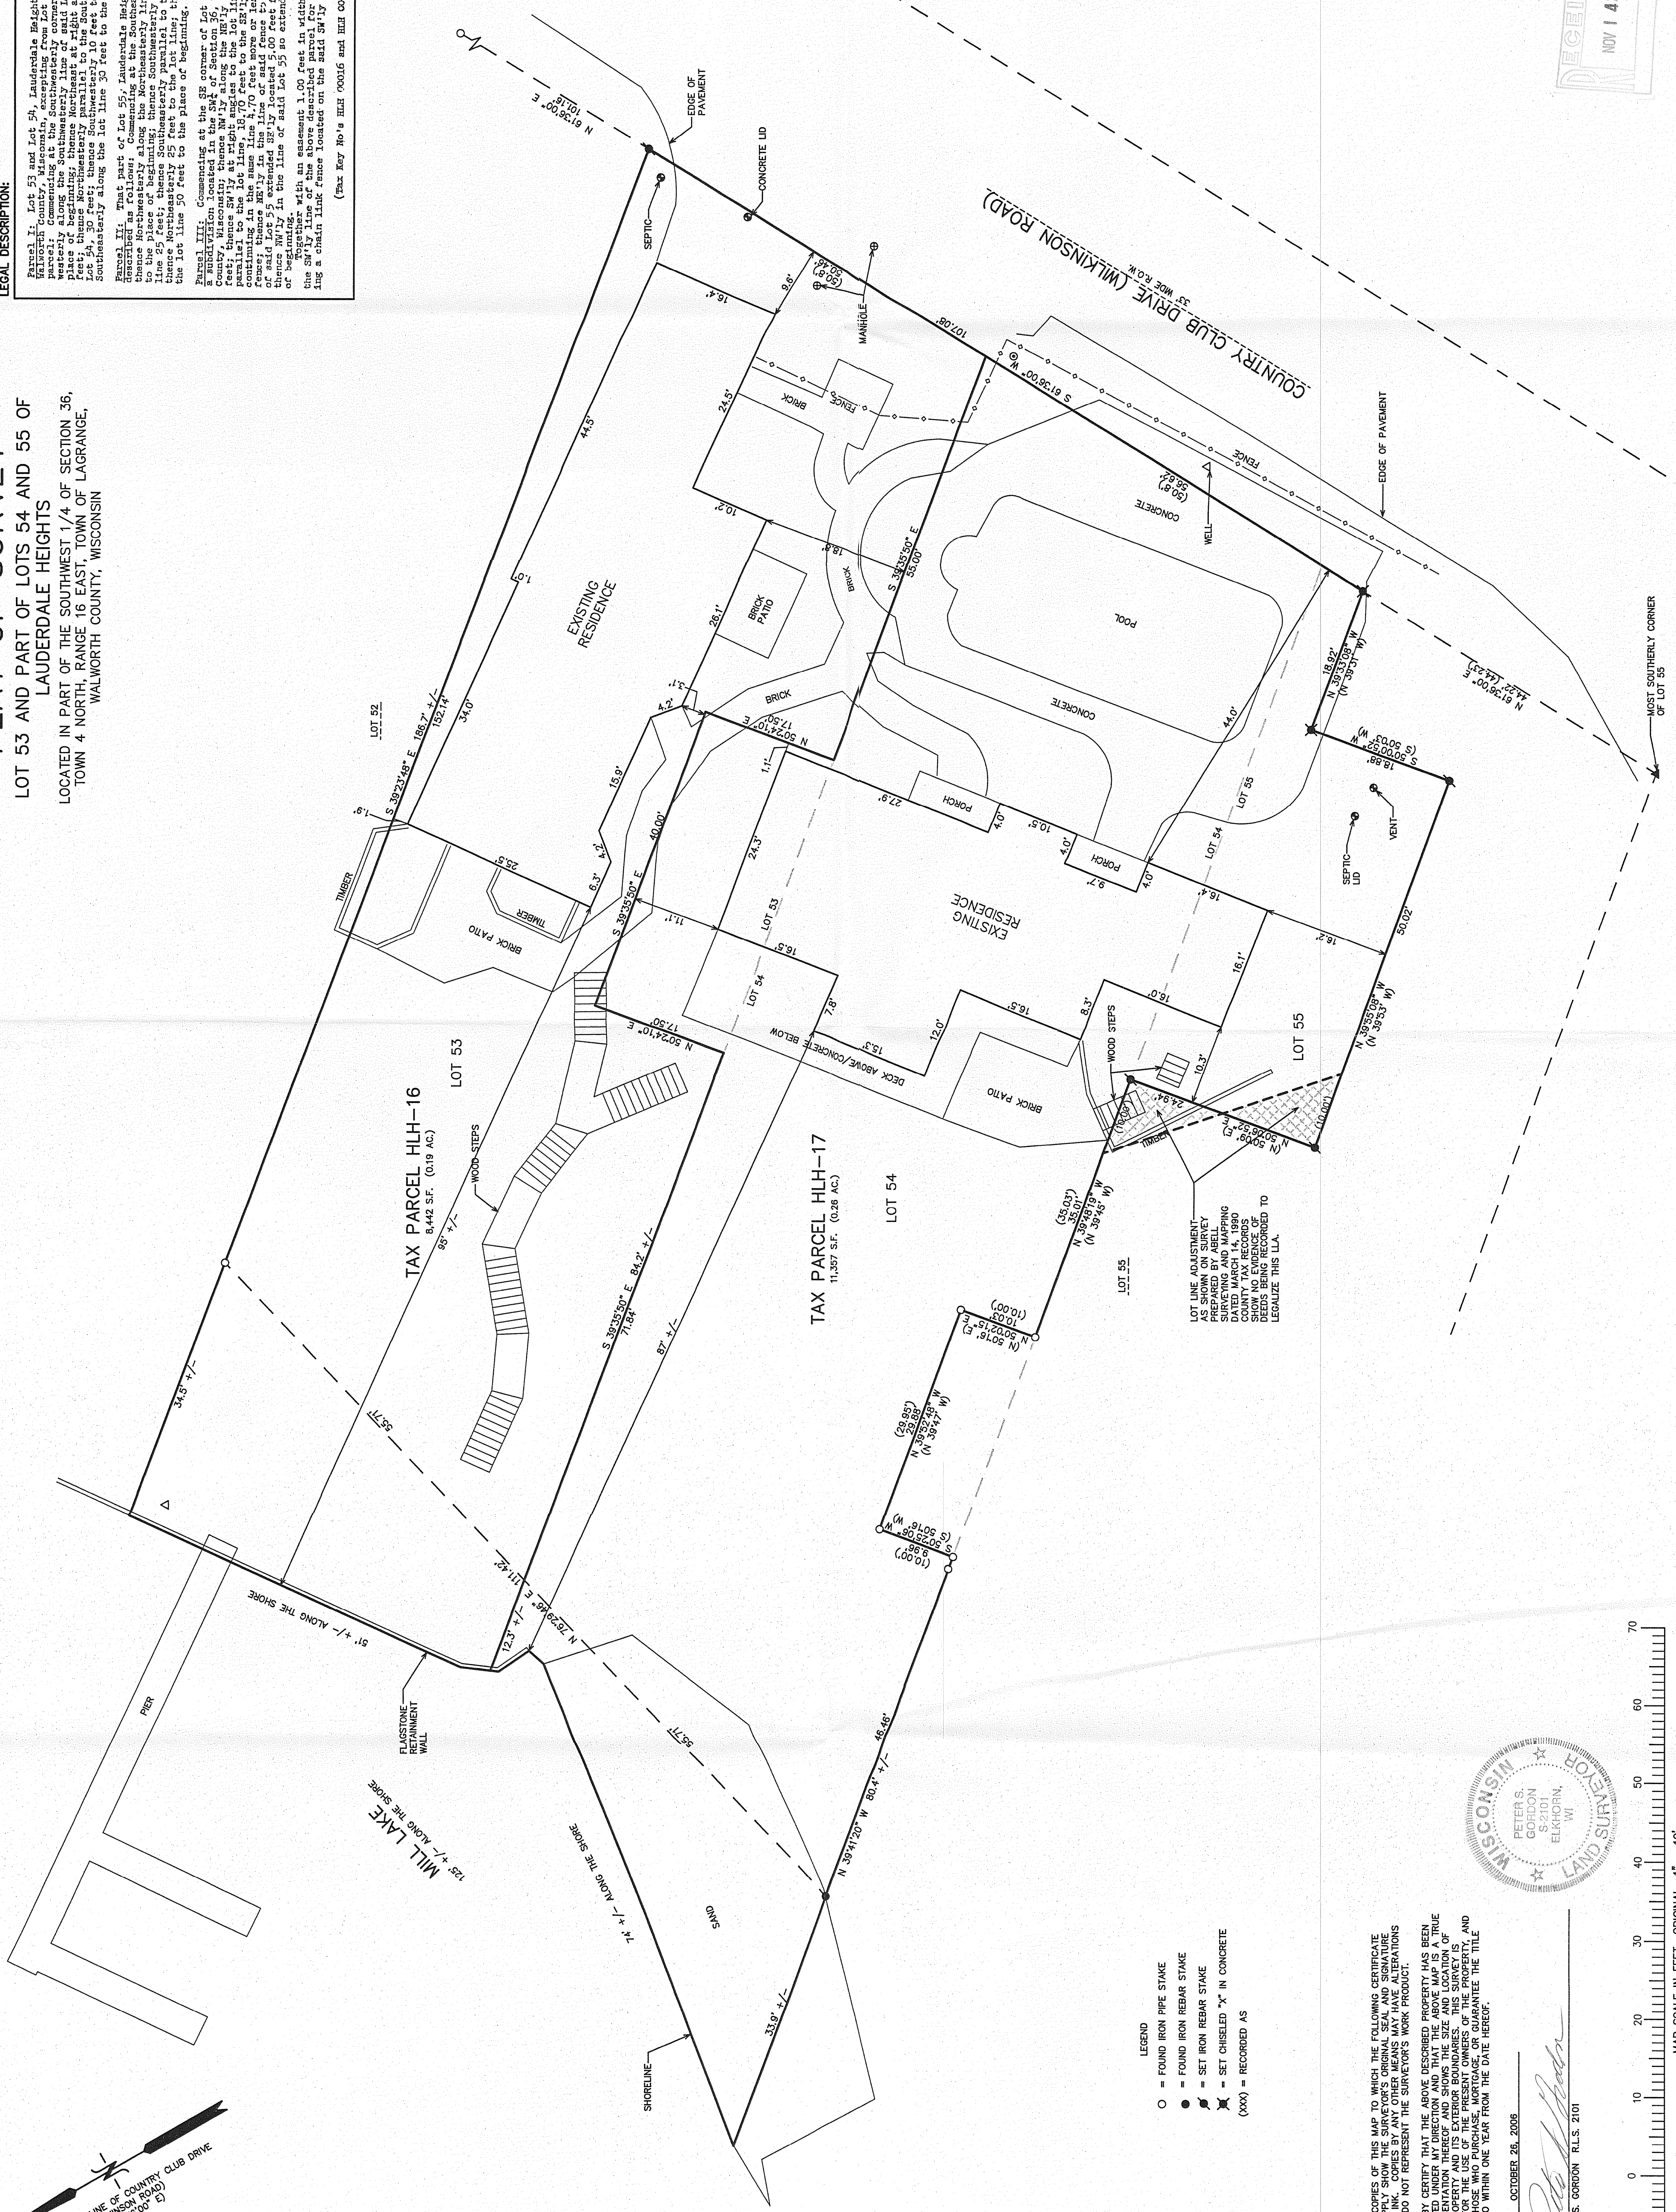
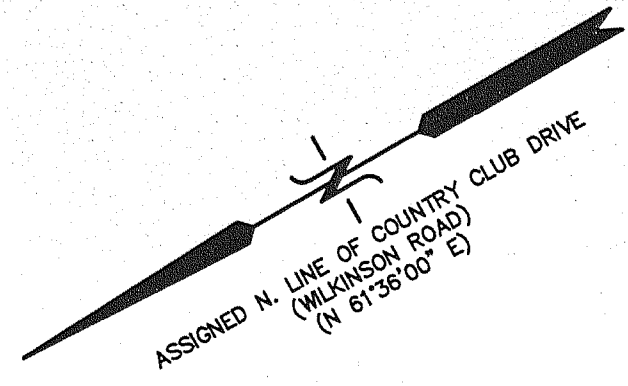


NOTE: COPIES OF THIS MAP TO WHICH THE FOLLOWING CERTIFICATE WILL APPLY SHOW THE SURVEYOR'S ORIGINAL SEAL AND SIGNATURE IN RED INK. COPIES BY ANY OTHER MEANS MAY HAVE ALTERATIONS WHICH DO NOT REPRESENT THE SURVEYOR'S WORK PRODUCT.





PETER S. GORDON R.L.S. 2101

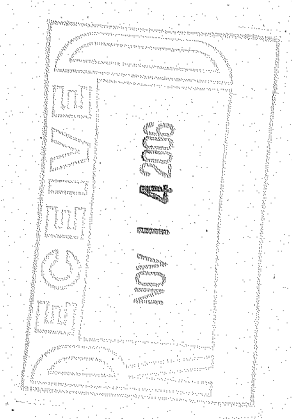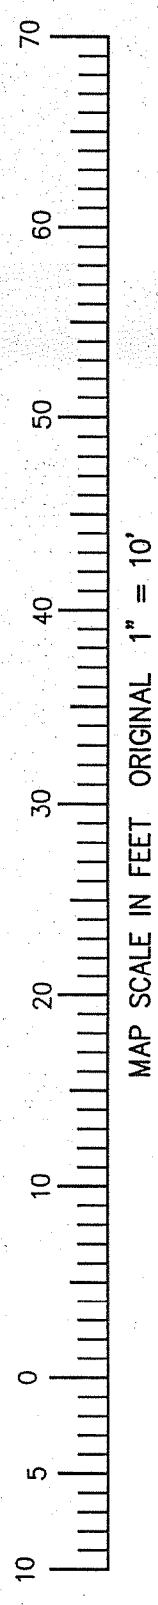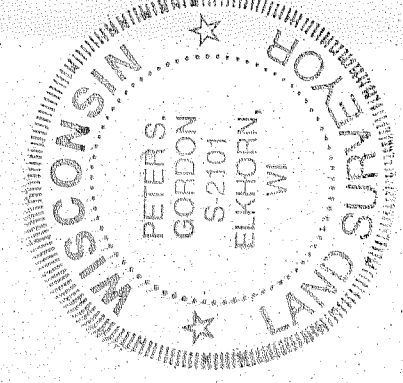

HLH-16 HLH-17

416-2240

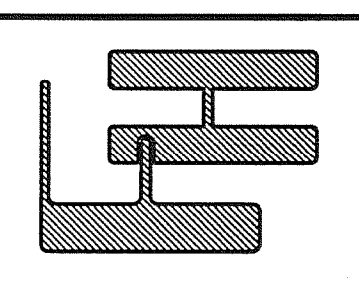

- WORK ORDERED BY -
JEFF RHYAN
N7433 COUNTRY CLUB DRIVE
ELKHORN, WI 53121

FARRIS, HANSEN & ASSOCIATES, INC.
ENGINEERING - ARCHITECTURE - SURVEYING
7 RIMWAY COURT P.O. BOX 437
ELKHORN, WISCONSIN 53121
OFFICE: (262) 723-2098 FAX: (262) 723-5886

REVISIONS	
PROJECT NO.	7152
DATE	10/26/06
SHEET NO.	1 OF 1