
ABELL
SURVEYING & MAPPING
1140 SEQUOIA STREET • DELAVAN, WISCONSIN 53115
262-728-6737

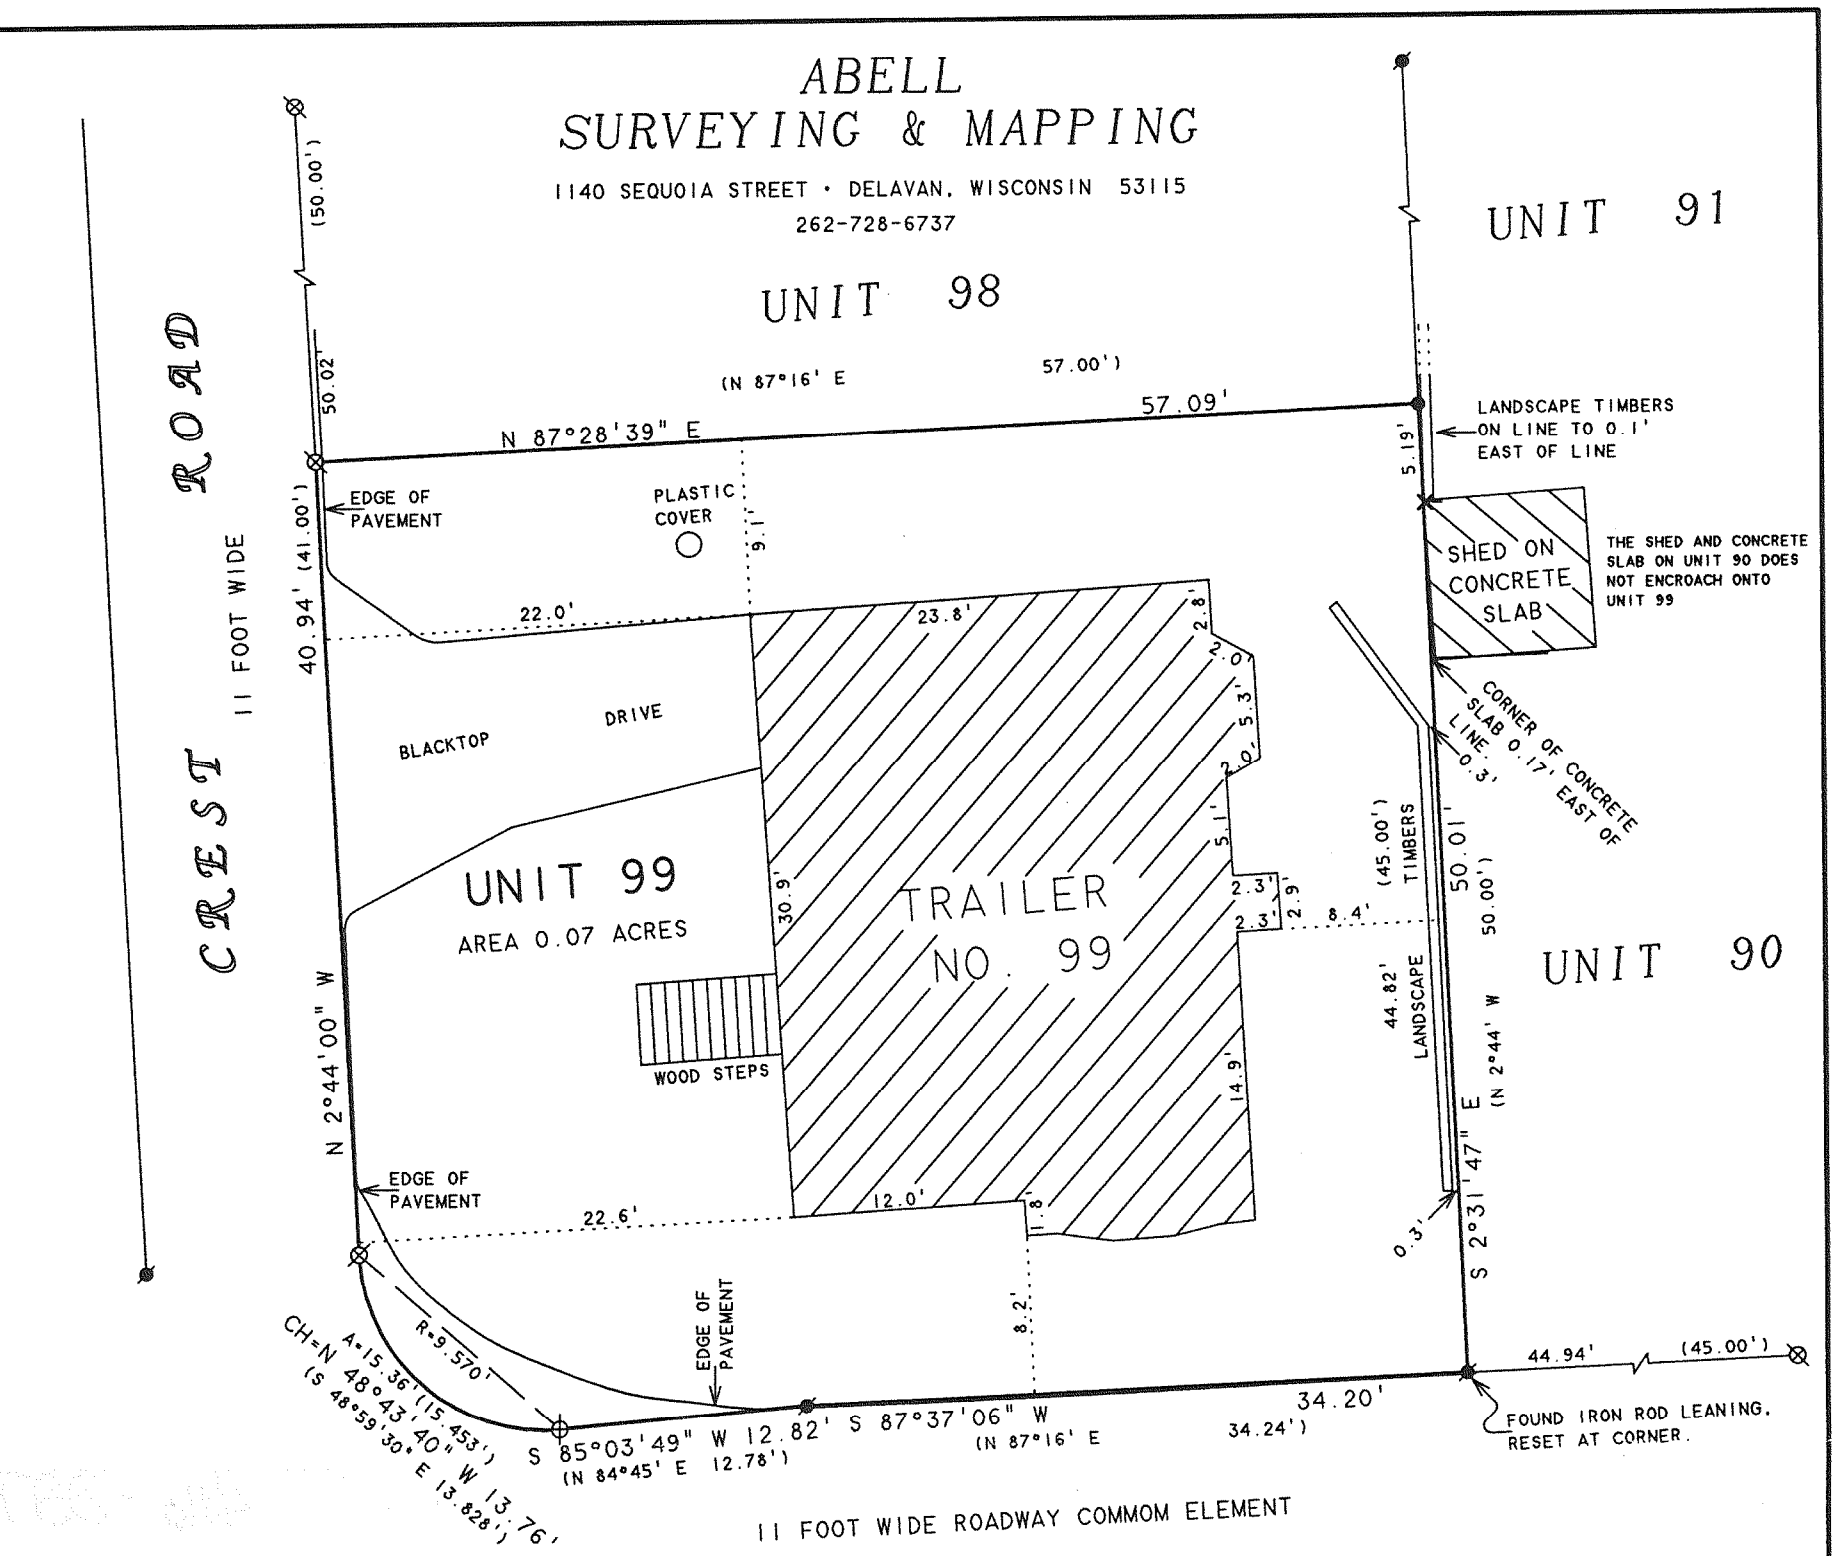

PLAT OF SURVEY OF

UNIT 99 OF LAUDERDALE SHORES A RECREATIONAL VEHICLE CONDOMINIUM LOCATED IN THE NORTHWEST 1/4 OF SECTION 25, T4N, R16E, WALWORTH COUNTY, WISCONSIN.

NOTE: BEARINGS ARE REFERENCED TO THE RECORDED CONDOMINIUM PLAT.

N

SCALE 1"=10'

LEGEND

- ● -IRON ROD FOUND
- ⊗ -RAILROAD SPIKE IN BLACKTOP ROADWAY FOUND
- × -CROSS CUT IN CONCRETE FOUND
- ● -LARGE NAIL FOUND
- ( )-RECORDED AS

REVISED DATE: APRIL 3, 2007
REVISED TO SHOW REMOVAL OF ENCROACHING CONCRETE SLAB ONTO UNIT 99 AND RESETTING OF IRON ROD AT SOUTHEAST PROPERTY CORNER.

ORDERED BY: PAUL SAMPSON
923 CROOKED STICK COURT
CRYSTAL LAKE, IL 60014

RECEIVED
JUL 18 2007

I HEREBY CERTIFY THAT I HAVE SURVEYED THE ABOVE DESCRIBED PROPERTY AND THAT THE ABOVE MAP IS A TRUE REPRESENTATION THEREOF AND SHOWS THE SIZE AND LOCATION OF THE PROPERTY, ITS EXTERIOR BOUNDARIES, THE LOCATION OF ALL VISIBLE STRUCTURES AND DIMENSIONS OF ALL PRINCIPAL BUILDINGS THEREON, BOUNDARY FENCES, APPARENT EASEMENTS, ROADWAYS AND VISIBLE ENCROACHMENTS, IF ANY, TO THE BEST OF MY KNOWLEDGE AND BELIEF.

THIS SURVEY IS MADE FOR THE USE OF THE PRESENT OWNERS OF THE PROPERTY, AND ALSO THOSE WHO PURCHASE, MORTGAGE, OR GUARANTEE THE TITLE THERETO WITHIN ONE (1) YEAR FROM DATE HEREON.

David F. Abell

DAVID F. ABELL
WISCONSIN REGISTERED LAND SURVEYOR, S-1596

March 29, 2007

DATE JOB NUMBER - 07016A
NOTE: THIS IS NOT A CERTIFIED COPY UNLESS SEALED.

HLAS-99

416-2279