
Plat of Survey

of

Lot 2 of Certified Survey Map No. 3783,

recorded in Vol. 22 of Certified Survey Maps of Walworth County on Page 348 and located in the Northeast 1/4 and the Northwest 1/4 of Section 35, Town 4 North, Range 16 East, Town of LaGrange, Walworth County, Wisconsin.

Surveyed for: **Keefe Real Estate, Inc.**
751 Geneva Parkway
P.O. Box 460
Lake Geneva, Wisconsin. 53147

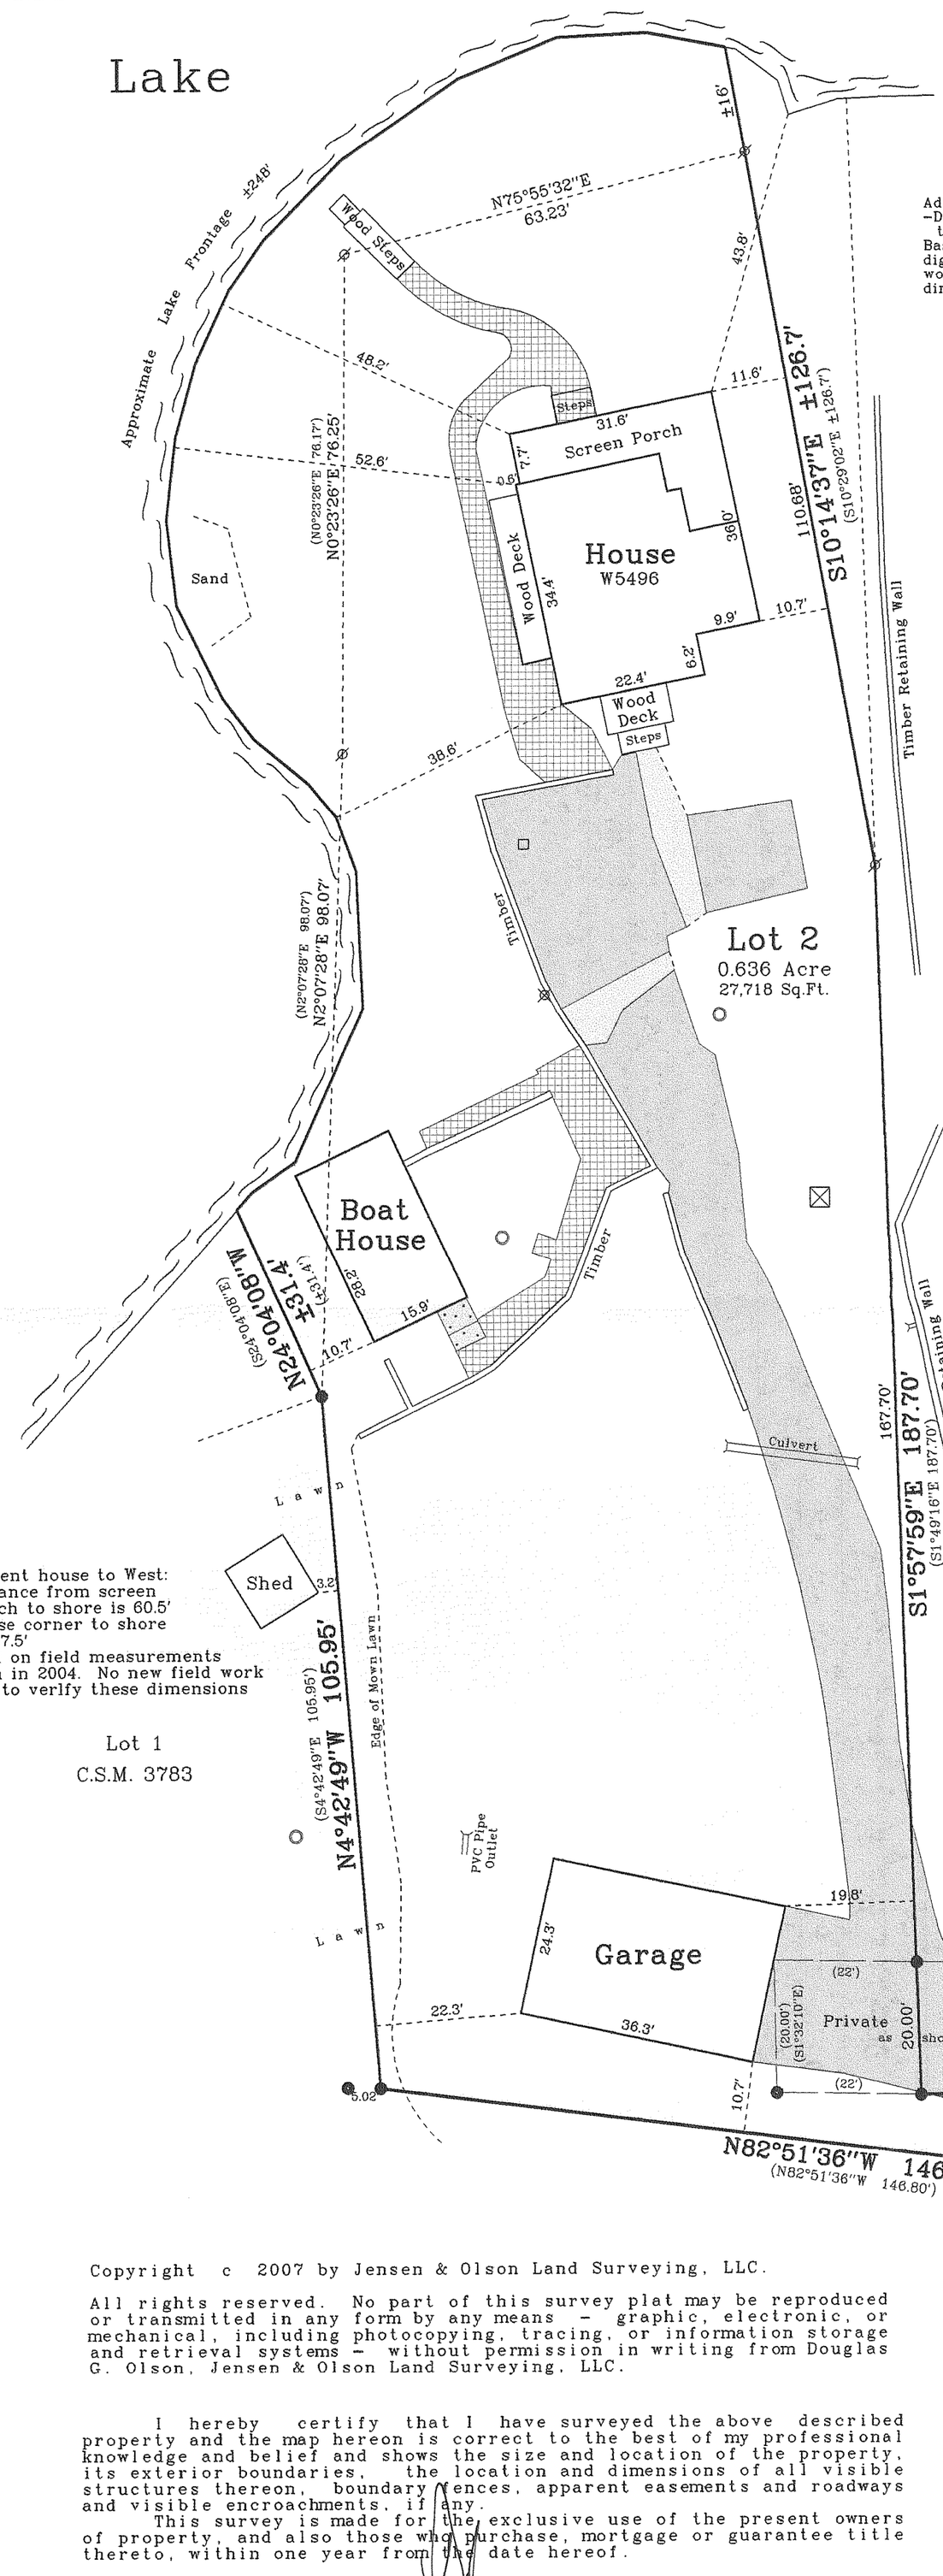

Adjacent house to East:
-Distance from House to shore is approx. 40'
Based on Walworth County digital mapping. No field work done to verify these dimensions

Adjacent house to West:
-Distance from screen porch to shore is 60.5'
-House corner to shore is 67.5'
Based on field measurements taken in 2004. No new field work done to verify these dimensions

RECEIVED
AUG - 1 2007

WISCONSIN
DOUGLAS G. OLSON
S-2093
ELKHORN, WI
LAND SURVEYOR
Not Certified Unless Stamped In Red.

Notes: 1) This survey plat is not certified unless signed and sealed in red ink.

2) This survey is subject to Wisconsin lien laws. This Plat of Survey is the notice of intent to file lien. Lien waiver required.

Copyright c 2007 by Jensen & Olson Land Surveying, LLC.

All rights reserved. No part of this survey plat may be reproduced or transmitted in any form by any means - graphic, electronic, or mechanical, including photocopying, tracing, or information storage and retrieval systems - without permission in writing from Douglas G. Olson, Jensen & Olson Land Surveying, LLC.

I hereby certify that I have surveyed the above described property and the map hereon is correct to the best of my professional knowledge and belief and shows the size and location of the property, its exterior boundaries, the location and dimensions of all visible structures thereon, boundary fences, apparent easements and roadways and visible encroachments, if any.

This survey is made for the exclusive use of the present owners of property, and also those who purchase, mortgage or guarantee title thereto, within one year from the date hereof.

Douglas G. Olson
Wisconsin Registered Land Surveyor - 2093

2000.070

Sheet 1 of 1 Sheets

Job Reference Number
2007.070

Legend
- Found Iron Pipe
- Found Iron Rod, 3/4" dia.
- ( ) Recorded Information
- Concrete Cover, Catch Basin
- Utility Box or Pedestal
- Light Pole
- Asphalt Surface, Stone
- Concrete Surface, Gravel

Jensen & Olson Land Surveying, LLC
45 South Wisconsin Street P.O. Box 322
Elkhorn, Wisconsin. 53121
Telephone (262) 723-3434
Facsimile (262) 723-8044

Scale in Feet
1" = 20'
0' 10' 20' 40'

Survey Date: May 24, 2007.
Revisions: No. 1 - Shore dimensions

HA3783-2

416-2283