
Scale
1" = 40'

* outside finish grade = EL 928.00 (advisory only) – top of foundation = EL 928.67 (advisory only) unless otherwise determined in writing by Town Building Inspector

top of foundation elevation = 928.69

* *Verify exact number with Town Building Inspector*

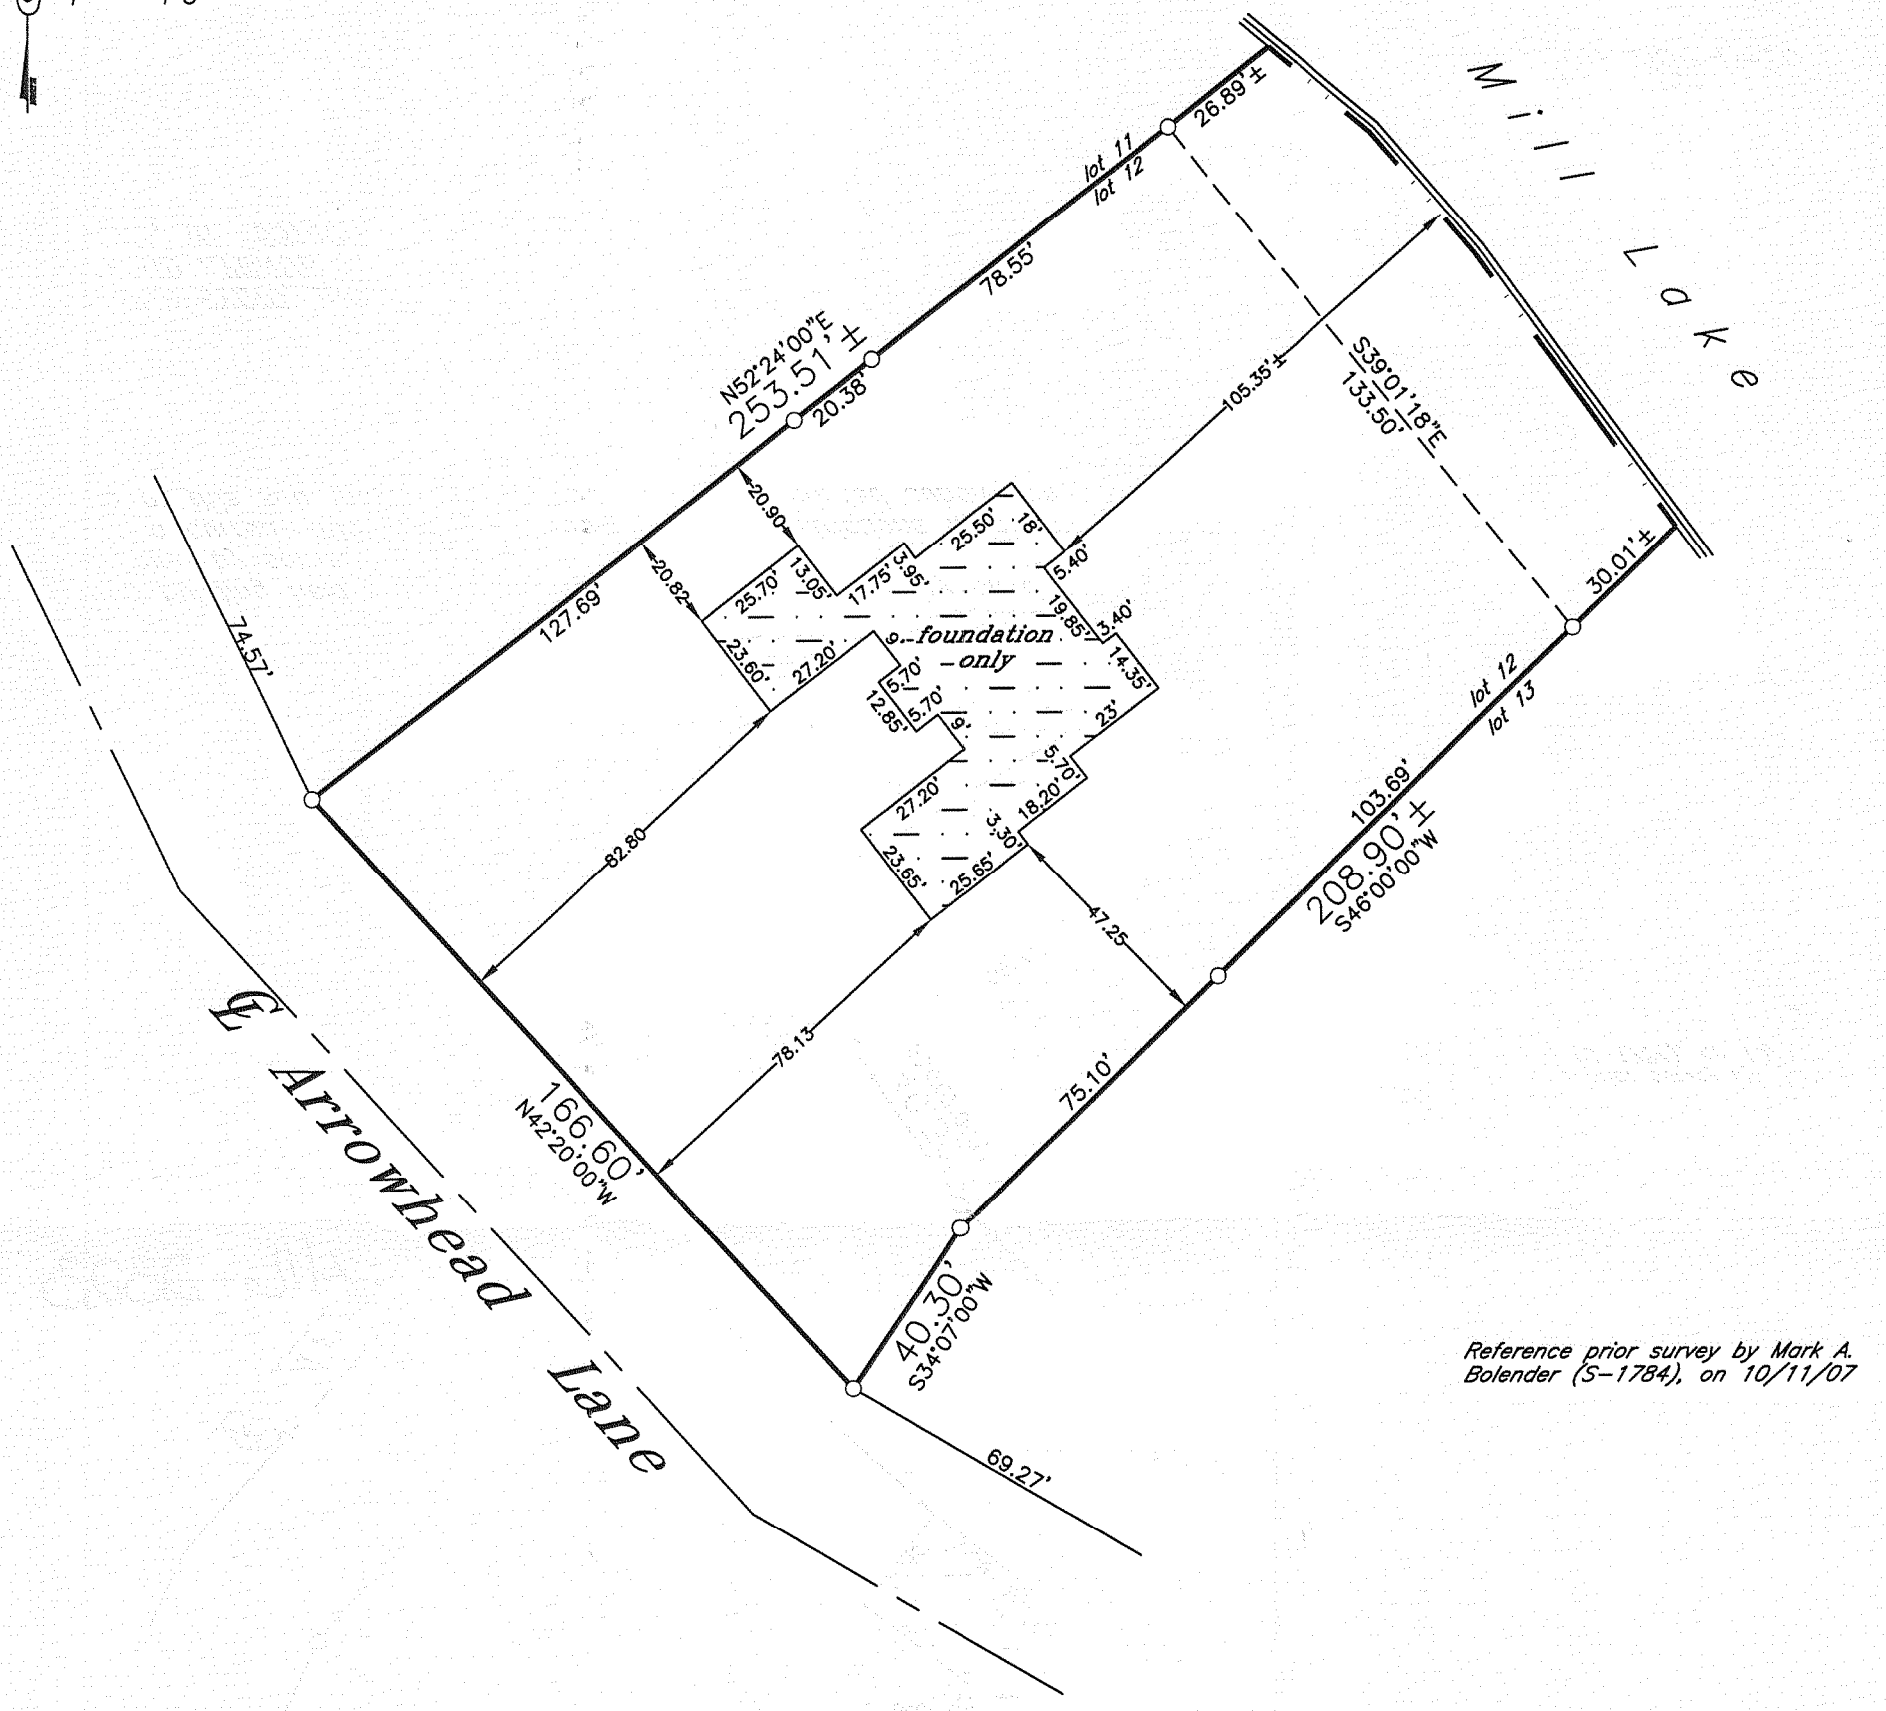

Reference prior survey by Mark A. Bolender (S–1784), on 10/11/07

Proposed building field staked true size. Contractor to verify all dimensions before building by same.
Refer to a current title report for easements or restrictions which may affect the use of this site that are not shown on the recorded subdivision plat.

denotes iron pipe

J.K.R. SURVEYING, INC.
8121 22ND AVENUE
KENOSHA, WI 53143

RECEIVED
JAN 14 2008

WISCONSIN
JEFFREY K. RAMPART
2141
KENOSHA, WI
LAND SURVEYOR

I hereby certify that this property was surveyed under my direction and this plat is a true representation thereof.

Reg. Land Surveyor
December 11, 2007

...NT IS NOT IN RED.
...RIGINAL.

HAPA-2

Plat of Survey of

LOT 12 IN

ARROWHEAD PARK ADDITION NO. 1

in SE1/4 Section 35–4–16

TOWN OF LAGRANGE
WALWORTH COUNTY, WIS.

–for–
Liberty Builders

416-2323