
FARRIS, HANSEN & COOPER, INC.

ENGINEERING, SURVEYING AND LAND PLANNING

715 W. WALWORTH ST. - P.O. BOX 487 - ELKHORN, WI 53121

OFFICE: 414/723-2098

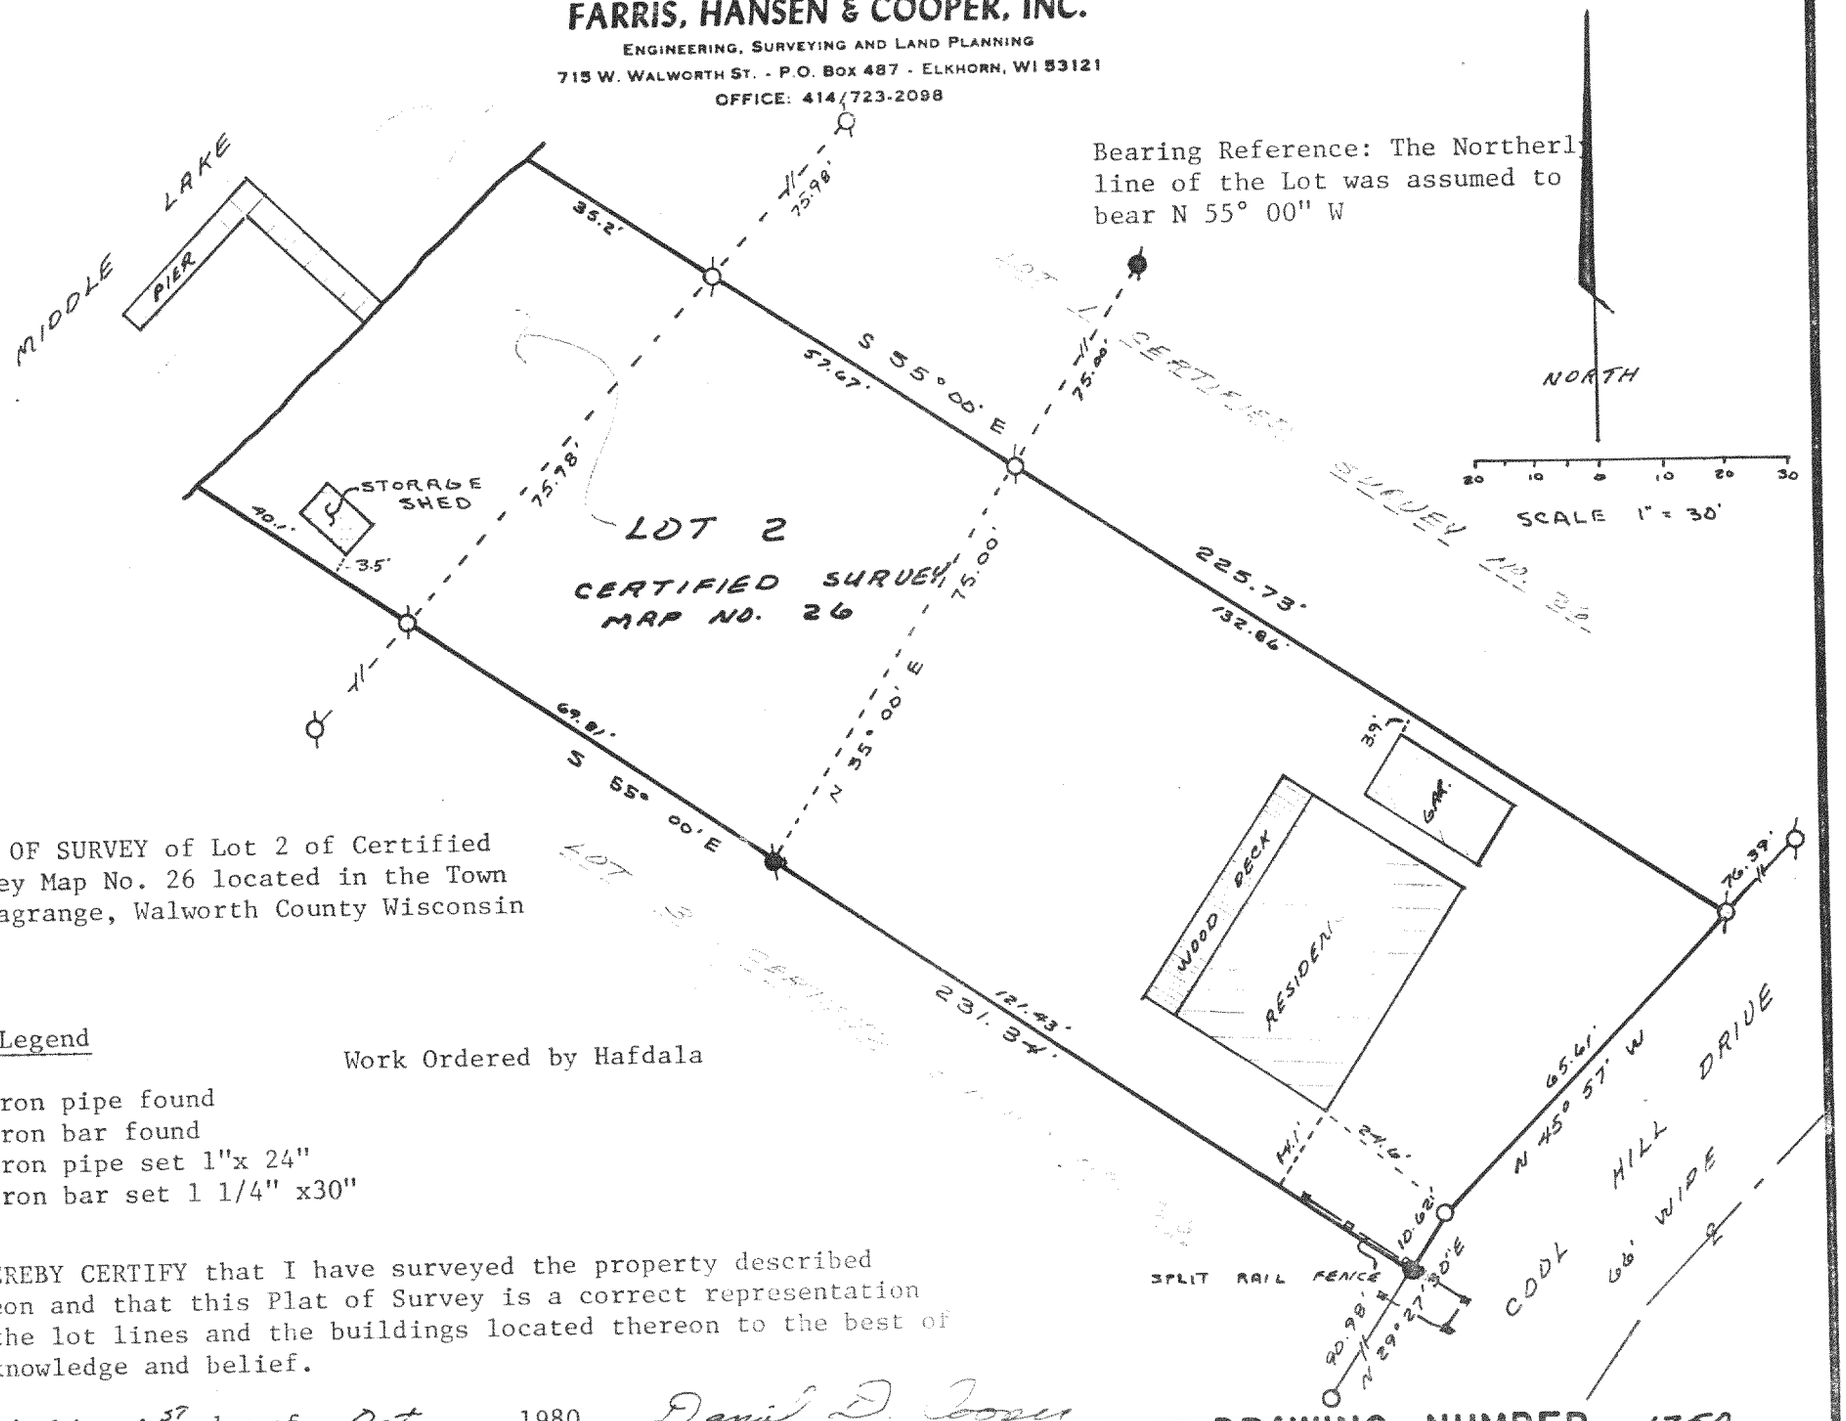

PLAT OF SURVEY of Lot 2 of Certified Survey Map No. 26 located in the Town of Lagrange, Walworth County Wisconsin

Work Ordered by Hafdala

Legend

- iron pipe found
- iron bar found
- iron pipe set 1"x 24"
- iron bar set 1 1/4" x30"

I HEREBY CERTIFY that I have surveyed the property described hereon and that this Plat of Survey is a correct representation of the lot lines and the buildings located thereon to the best of my knowledge and belief.

Dated this 1st day of Oct ,1980

Daniel D. Cooper

Daniel D. Cooper RLS No. S-1464

DRAWING NUMBER 1750

HA26-2

'16-236-F