
PLAT OF SURVEY

LOT 22 OF CALI ACRES SUBDIVISION

LOCATED IN THE SW 1/4 OF THE SW 1/4 OF SECTION 35,
TOWN 4 NORTH, RANGE 16 EAST, WALWORTH COUNTY, WISCONSIN

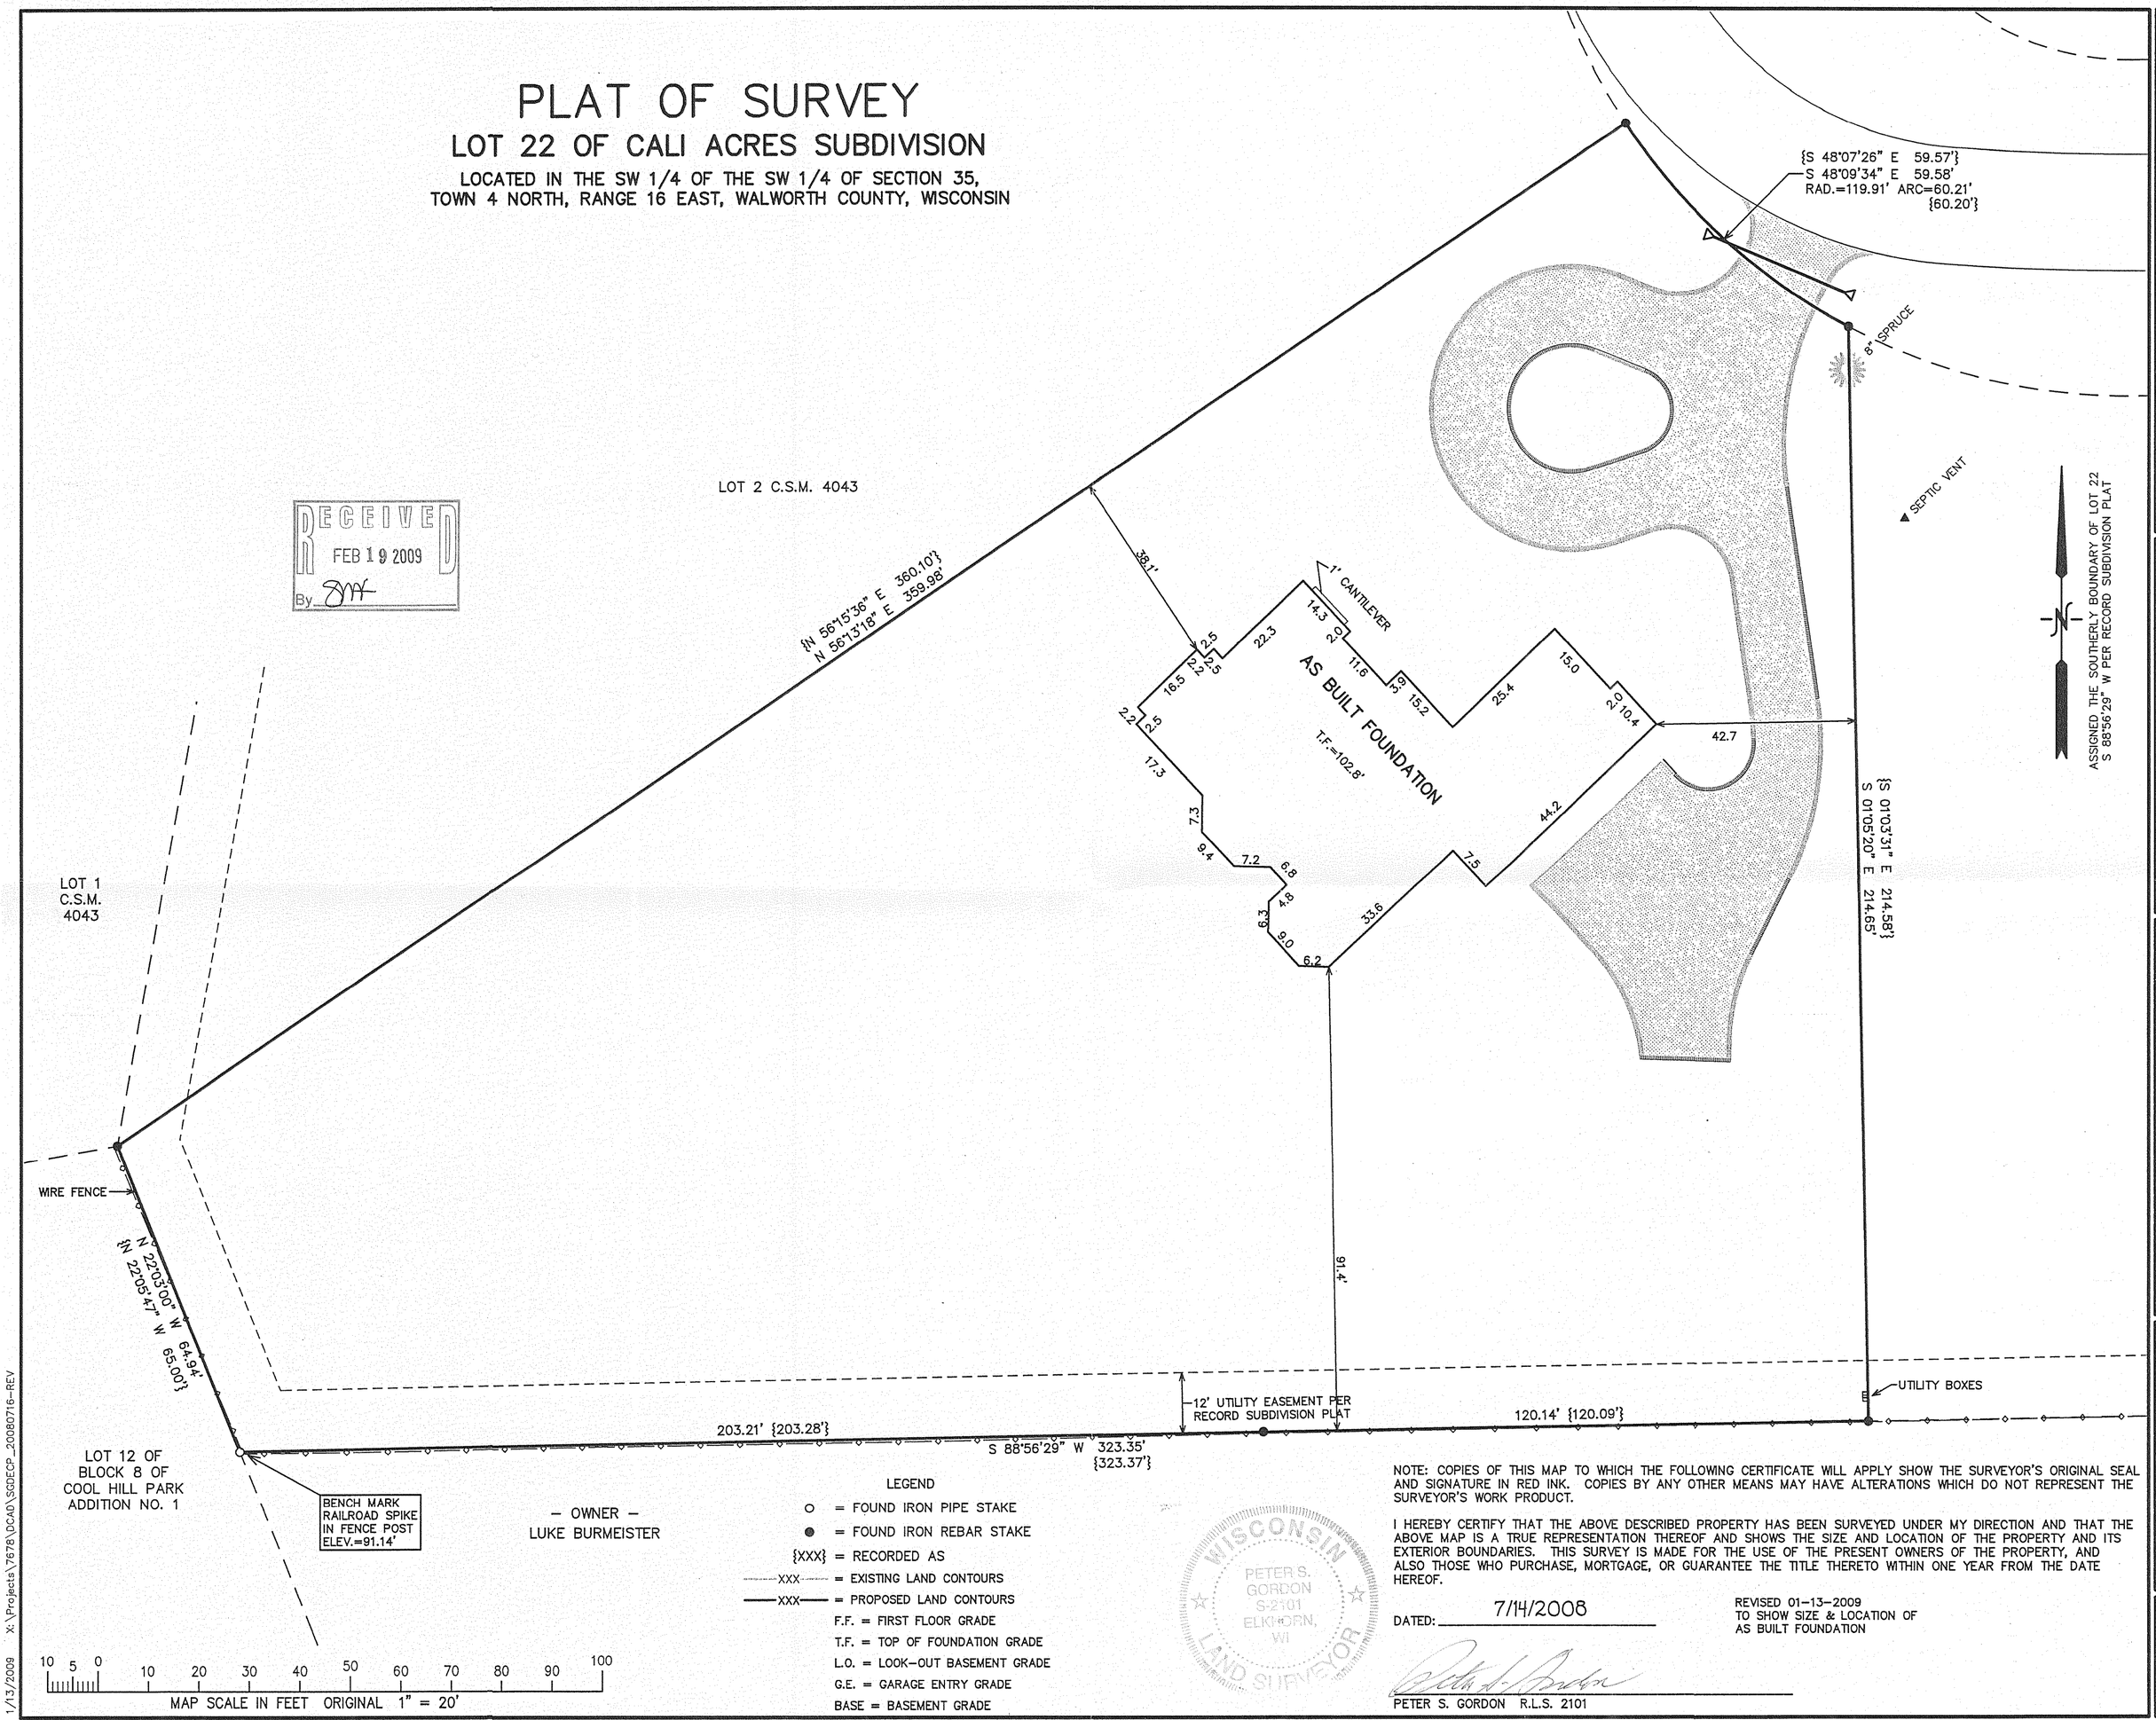

RECEIVED
FEB 19 2009
By

– OWNER –
LUKE BURMEISTER

LEGEND

- ○ = FOUND IRON PIPE STAKE
- ● = FOUND IRON REBAR STAKE
- {XXX} = RECORDED AS
- XXX = EXISTING LAND CONTOURS
- XXX = PROPOSED LAND CONTOURS
- F.F. = FIRST FLOOR GRADE
- T.F. = TOP OF FOUNDATION GRADE
- L.O. = LOOK-OUT BASEMENT GRADE
- G.E. = GARAGE ENTRY GRADE
- BASE = BASEMENT GRADE

NOTE: COPIES OF THIS MAP TO WHICH THE FOLLOWING CERTIFICATE WILL APPLY SHOW THE SURVEYOR'S ORIGINAL SEAL AND SIGNATURE IN RED INK. COPIES BY ANY OTHER MEANS MAY HAVE ALTERATIONS WHICH DO NOT REPRESENT THE SURVEYOR'S WORK PRODUCT.

I HEREBY CERTIFY THAT THE ABOVE DESCRIBED PROPERTY HAS BEEN SURVEYED UNDER MY DIRECTION AND THAT THE ABOVE MAP IS A TRUE REPRESENTATION THEREOF AND SHOWS THE SIZE AND LOCATION OF THE PROPERTY AND ITS EXTERIOR BOUNDARIES. THIS SURVEY IS MADE FOR THE USE OF THE PRESENT OWNERS OF THE PROPERTY, AND ALSO THOSE WHO PURCHASE, MORTGAGE, OR GUARANTEE THE TITLE THERETO WITHIN ONE YEAR FROM THE DATE HEREOF.

WISCONSIN
PETER S. GORDON
S-2101
ELKHORN, WI
LAND SURVEYOR

DATED: 7/14/2008

REVISED 01-13-2009
TO SHOW SIZE & LOCATION OF
AS BUILT FOUNDATION

PETER S. GORDON R.L.S. 2101

PLAT OF SURVEY
TOWN OF LA GRANGE, WALWORTH COUNTY, WISCONSIN

– WORK ORDERED BY –
J. TIMOTHY BUILDERS
W4732 PEBBLE DRIVE
ELKHORN, WI 53121

FARRIS, HANSEN & ASSOCIATES, INC.
ENGINEERING – ARCHITECTURE – SURVEYING
7 RIDGWAY COURT P.O. BOX 437
ELKHORN, WISCONSIN 53121
OFFICE: (262) 723-2098 FAX: (262) 723-5886

REVISIONS
7/16/2008-KB
SITE, GRADING, DRAINAGE, & EROSION CONTROL PLAN
8/18/2008-KB
REVISED PRO. RES. GRADES

PROJECT NO.
7678
DATE:
07/14/2008
SHEET NO.
1 OF 1

1/13/2009 X:\Projects\7678\DCAD\SGDECP_20080716-REV

HC-22

4/6-2386